PARENT PARCEL: 12-00-040-101-009, -010, -011

CHILD PARCEL: 12-00-040-101-062

STARTING POINT: AC CORR PER SURV BY SEAN A. BOLAND

23-04716

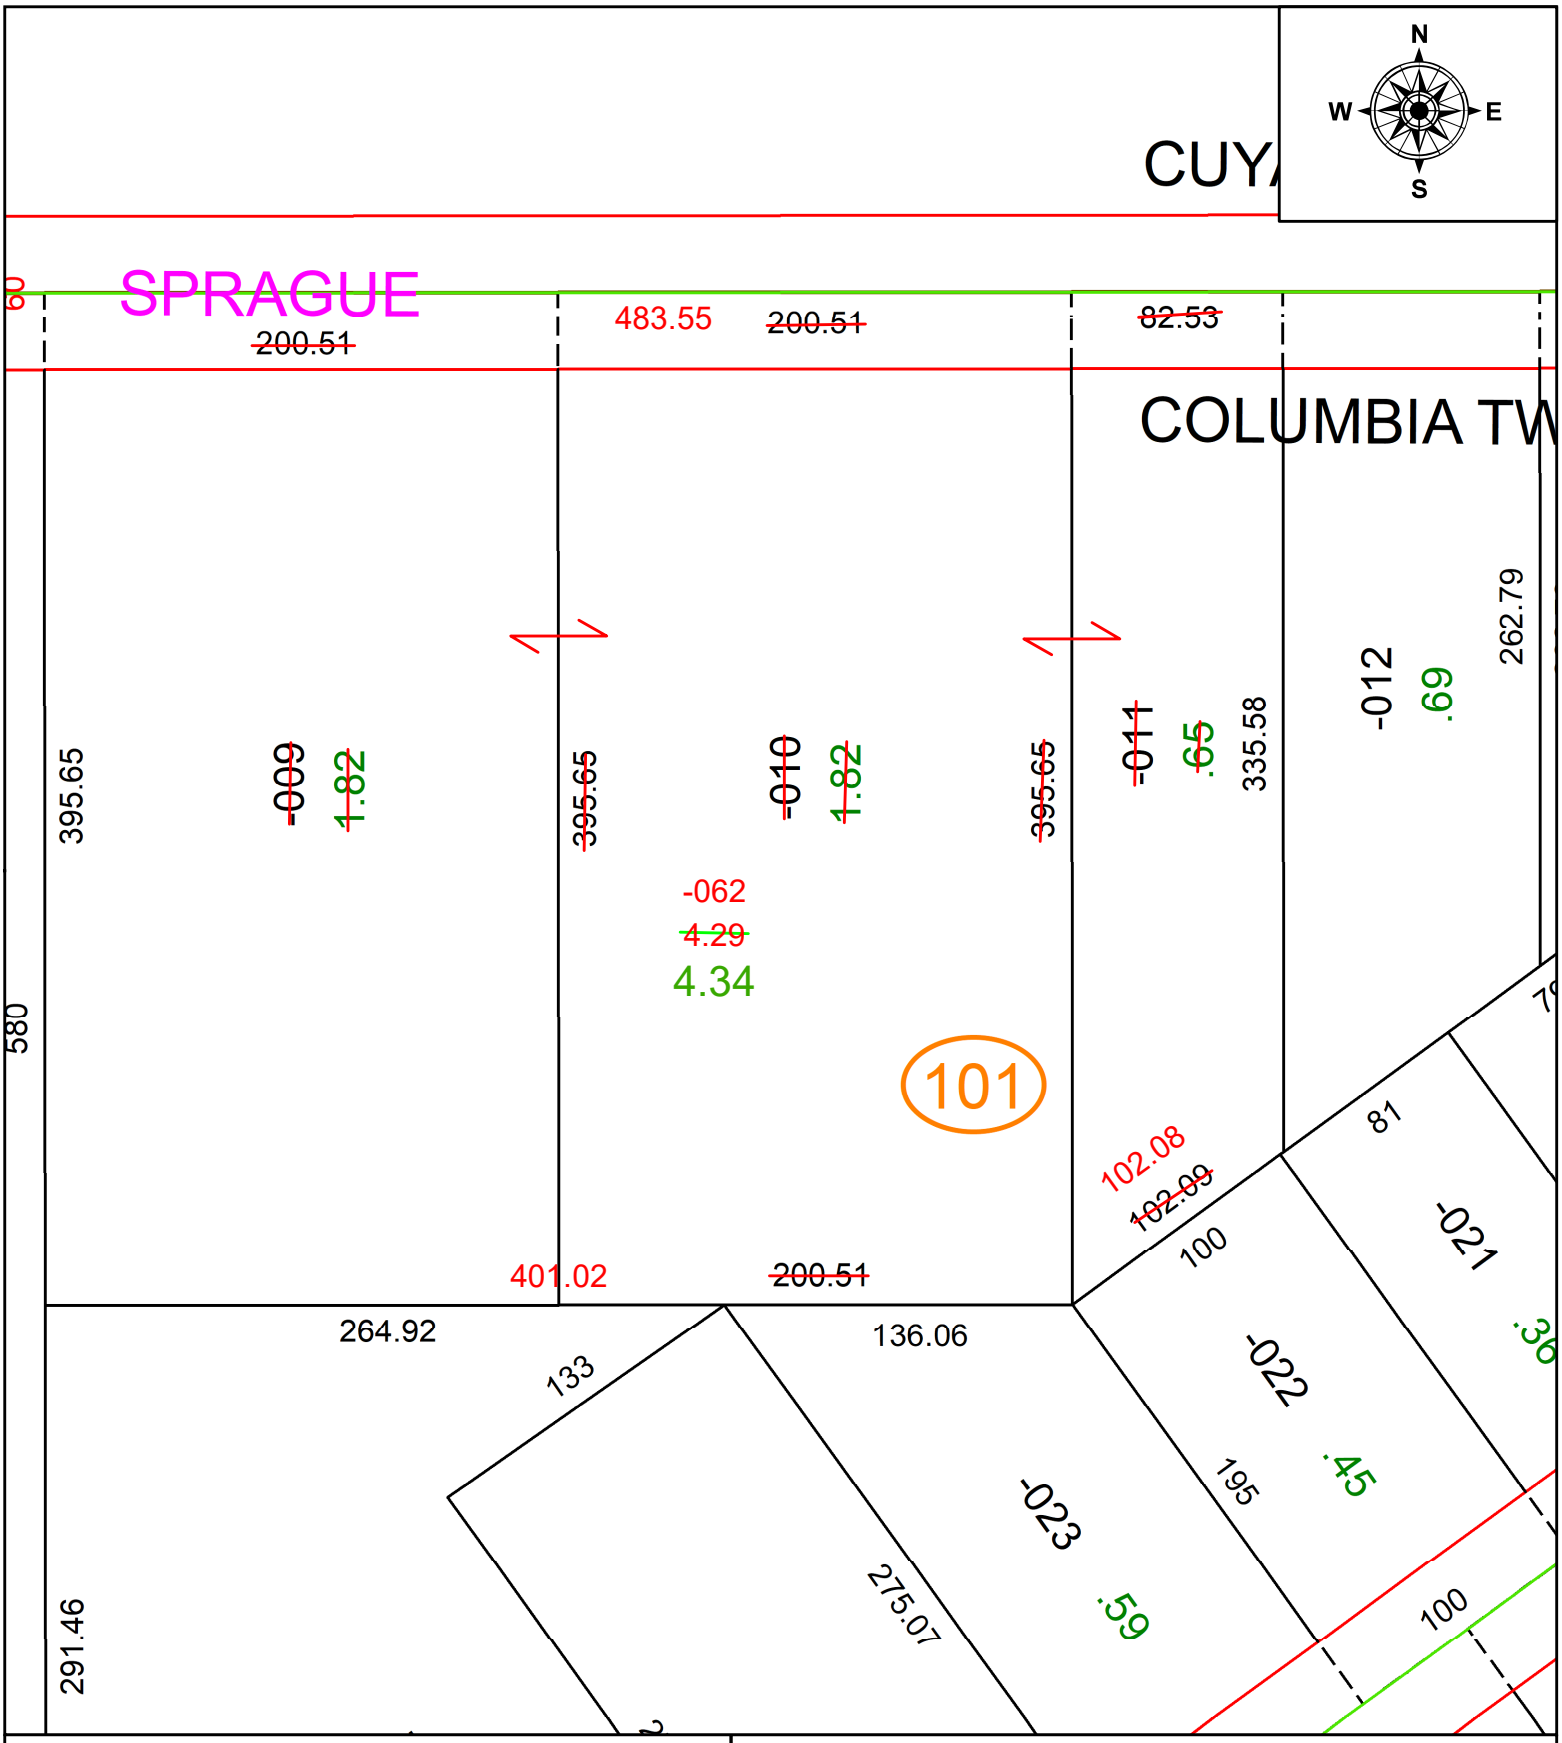

SPLITS/DEEDS PROCESSED

LORAIN COUNTY TAX MAP DEPARTMENT
226 MIDDLE AVE. ELYRIA, OH

SURVEYED BY: SEAN A. BOLAND **SURV # 50925**

CLOSURE: 1: 486317

MAP PAGE(S): 12-00-040

APPOVED BY: AC **DATE:** June 22, 2023

SCALE: 1 in = 75 ft **PRIOR INSTRUMENT:** 2015- 0569130