PARENT PARCEL: 07-00-014-106-007
CHILD PARCEL: 07-00-014-106-012, -013
STARTING POINT: INTERSECTION OF ROOT RD & LORAIN RD CENTERLINES

23-04717

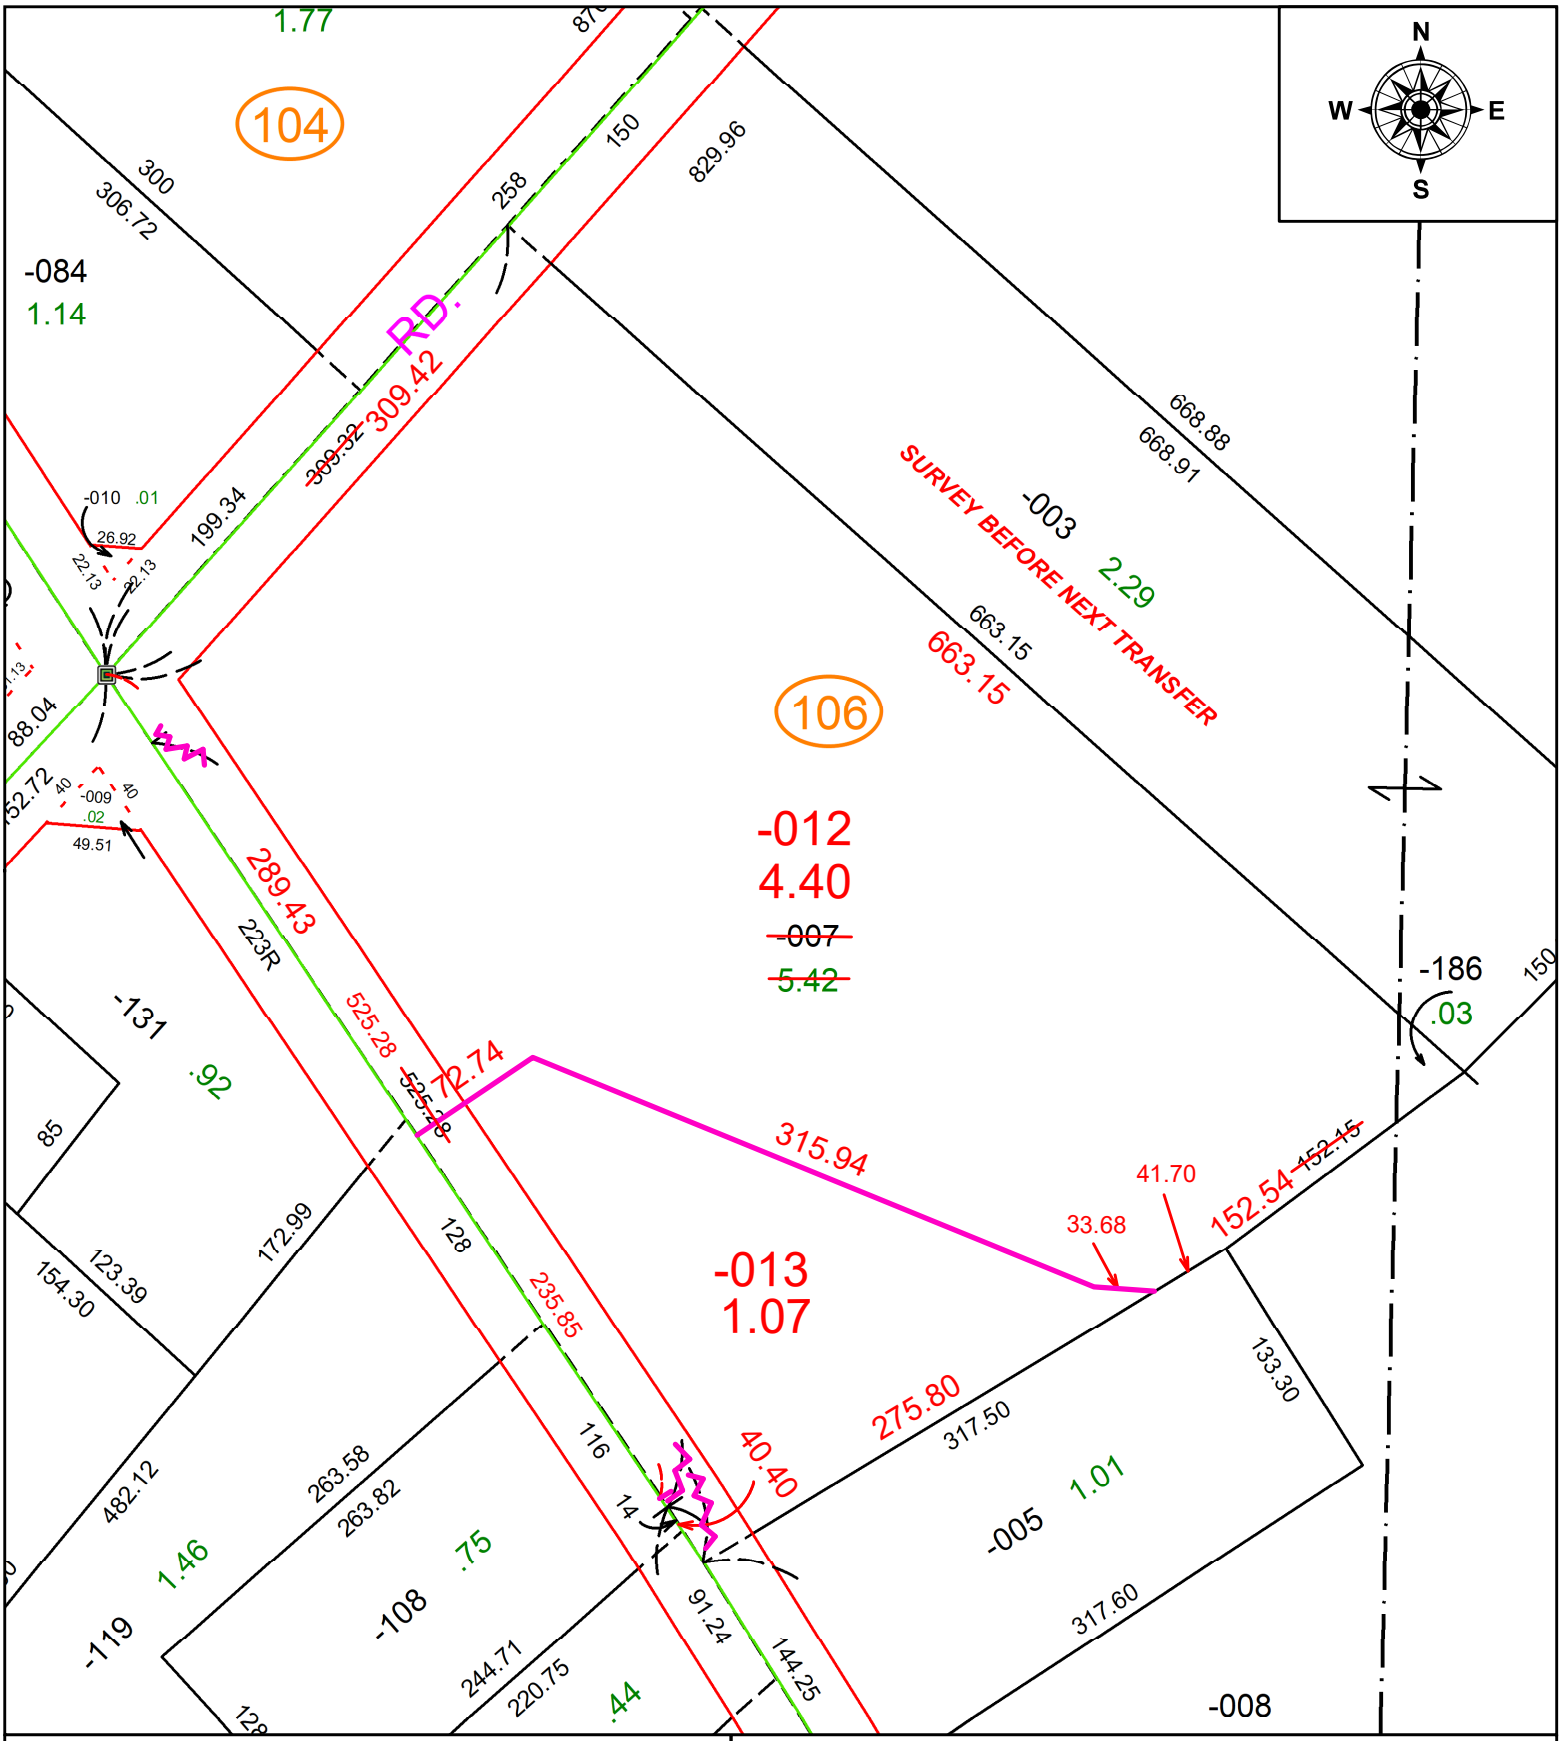

SPLITS/DEEDS PROCESSED
LORAIN COUNTY TAX MAP DEPARTMENT
226 MIDDLE AVE. ELYRIA, OH

SURVEYED BY: RICHARD A. THOMPSON **SURVEY #:** 50929
CLOSURE: 1: 25,775
MAP PAGE(S): 07-00-014
APPOVED BY: SP **DATE:** 6/29/2023
SCALE: 1" = 100' **PRIOR INSTRUMENT:** 2021-0855014