PARENT PARCEL: 07-00-047-000-031

CHILD PARCEL: 07-00-047-000-189 & -190

STARTING POINT: AC CORR PER SURV BY WILFREDO BARBOSA

23-04719

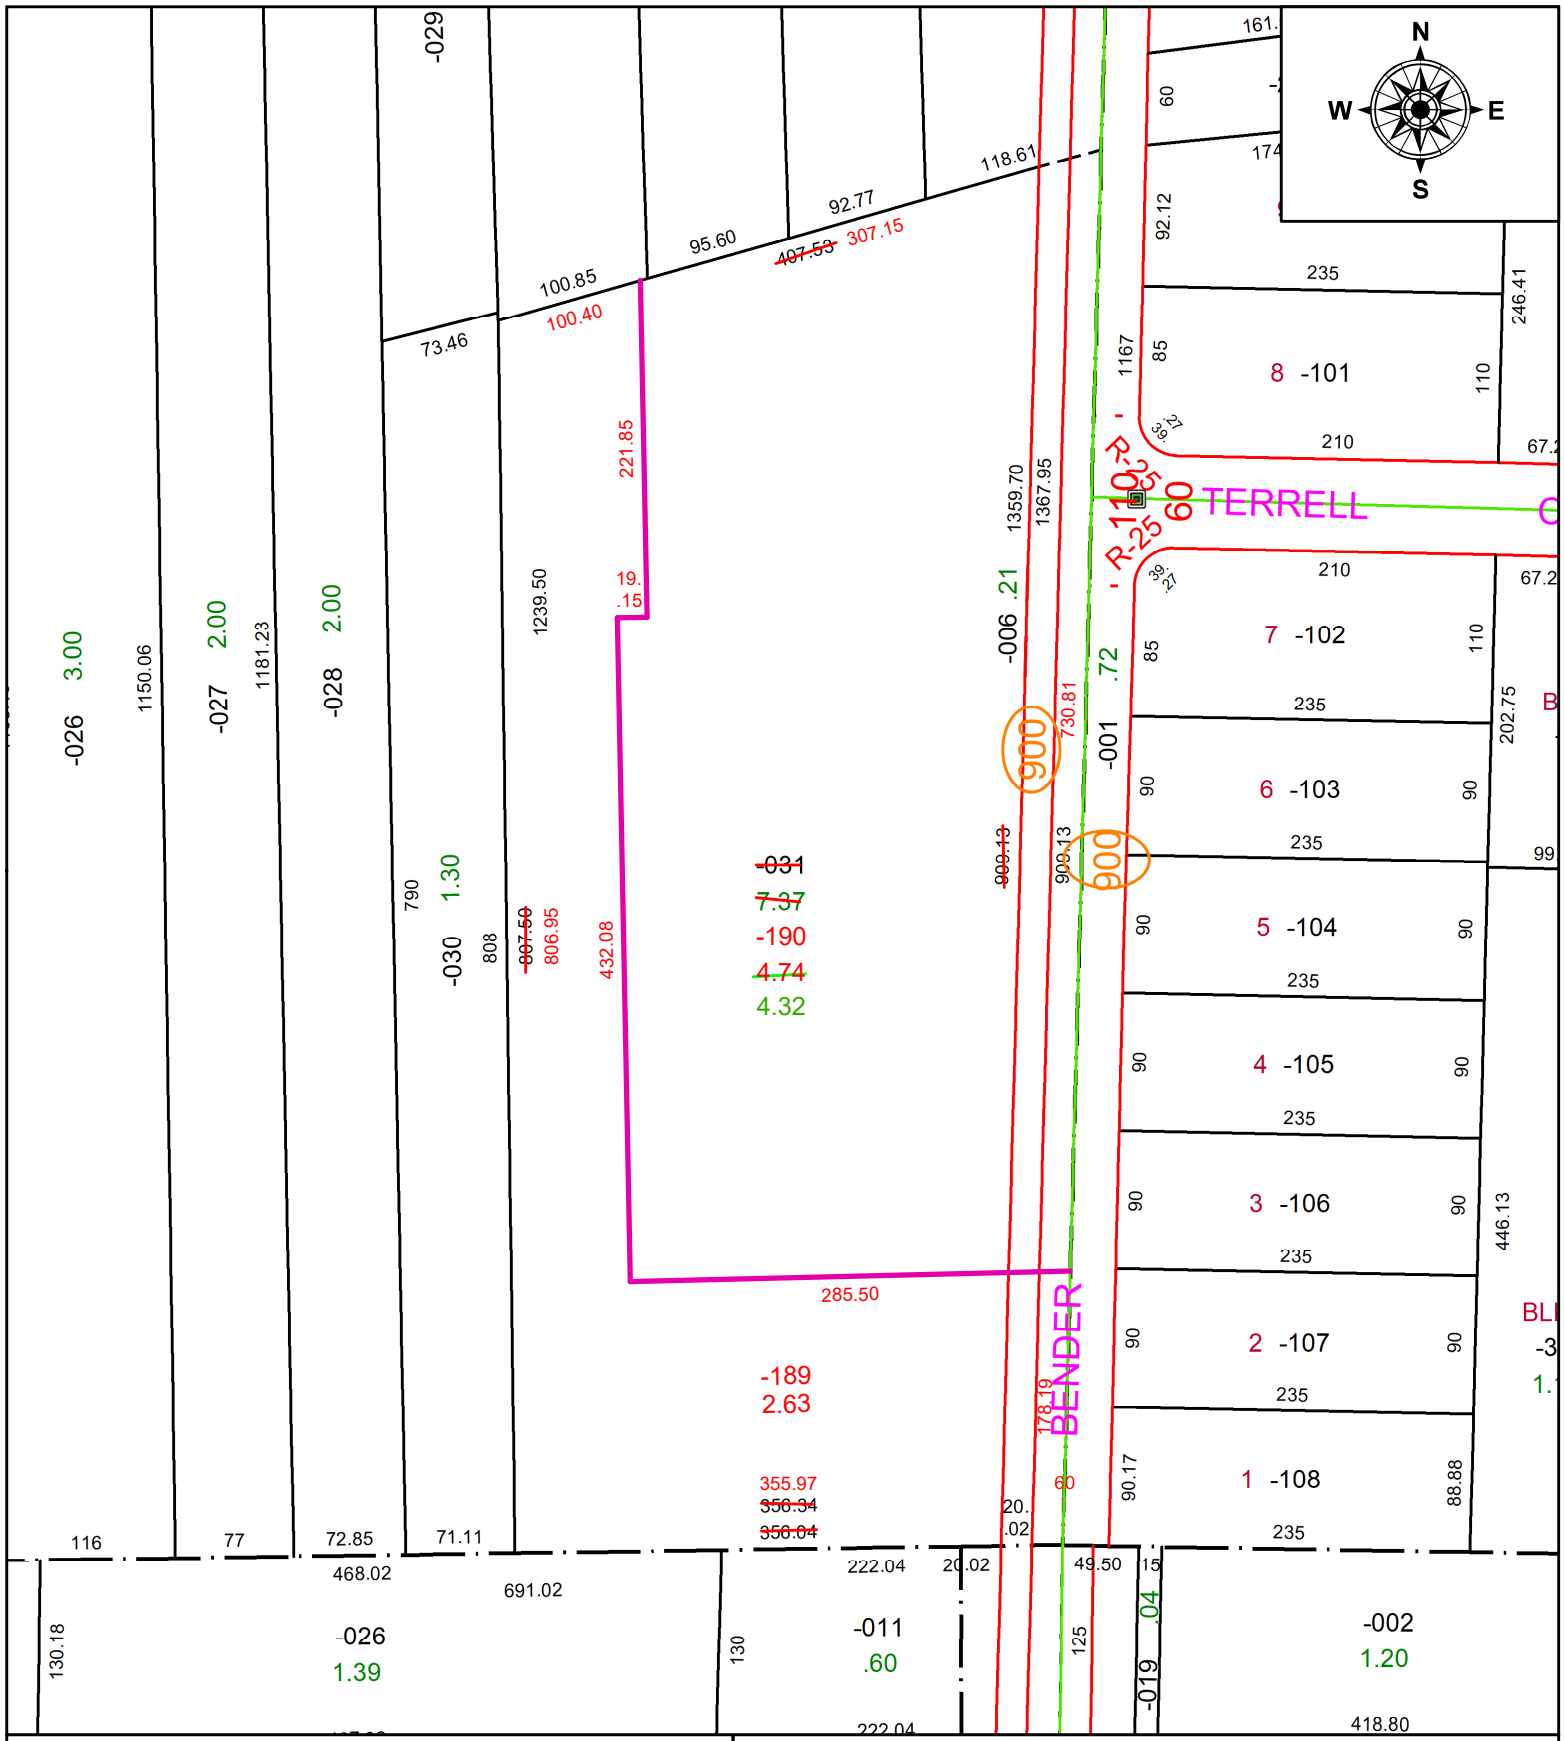

SPLITS/DEEDS PROCESSED

LORAIN COUNTY TAX MAP DEPARTMENT
226 MIDDLE AVE. ELYRIA, OH

SURVEYED BY: WILFREDO BARBOSA **SURV # 50931**

CLOSURE: 1: 123921

MAP PAGE(S): 07-00-047

APPOVED BY: AC **DATE:** June 29, 2023

SCALE: 1 in = 125 ft **PRIOR INSTRUMENT:** 2020- 0747961