PARENT PARCEL: 04-00-011-107-096 & -176

CHILD PARCEL: 04-00-011-107-252 THRU -255 AC CORR PER SURVEYOR MICHAEL SPELLACY

STARTING POINT: MONUMENT BOX @ INTERSECTION OF C/LS OF STONEY RIDGE RD & HALSTED LAND

23-04724

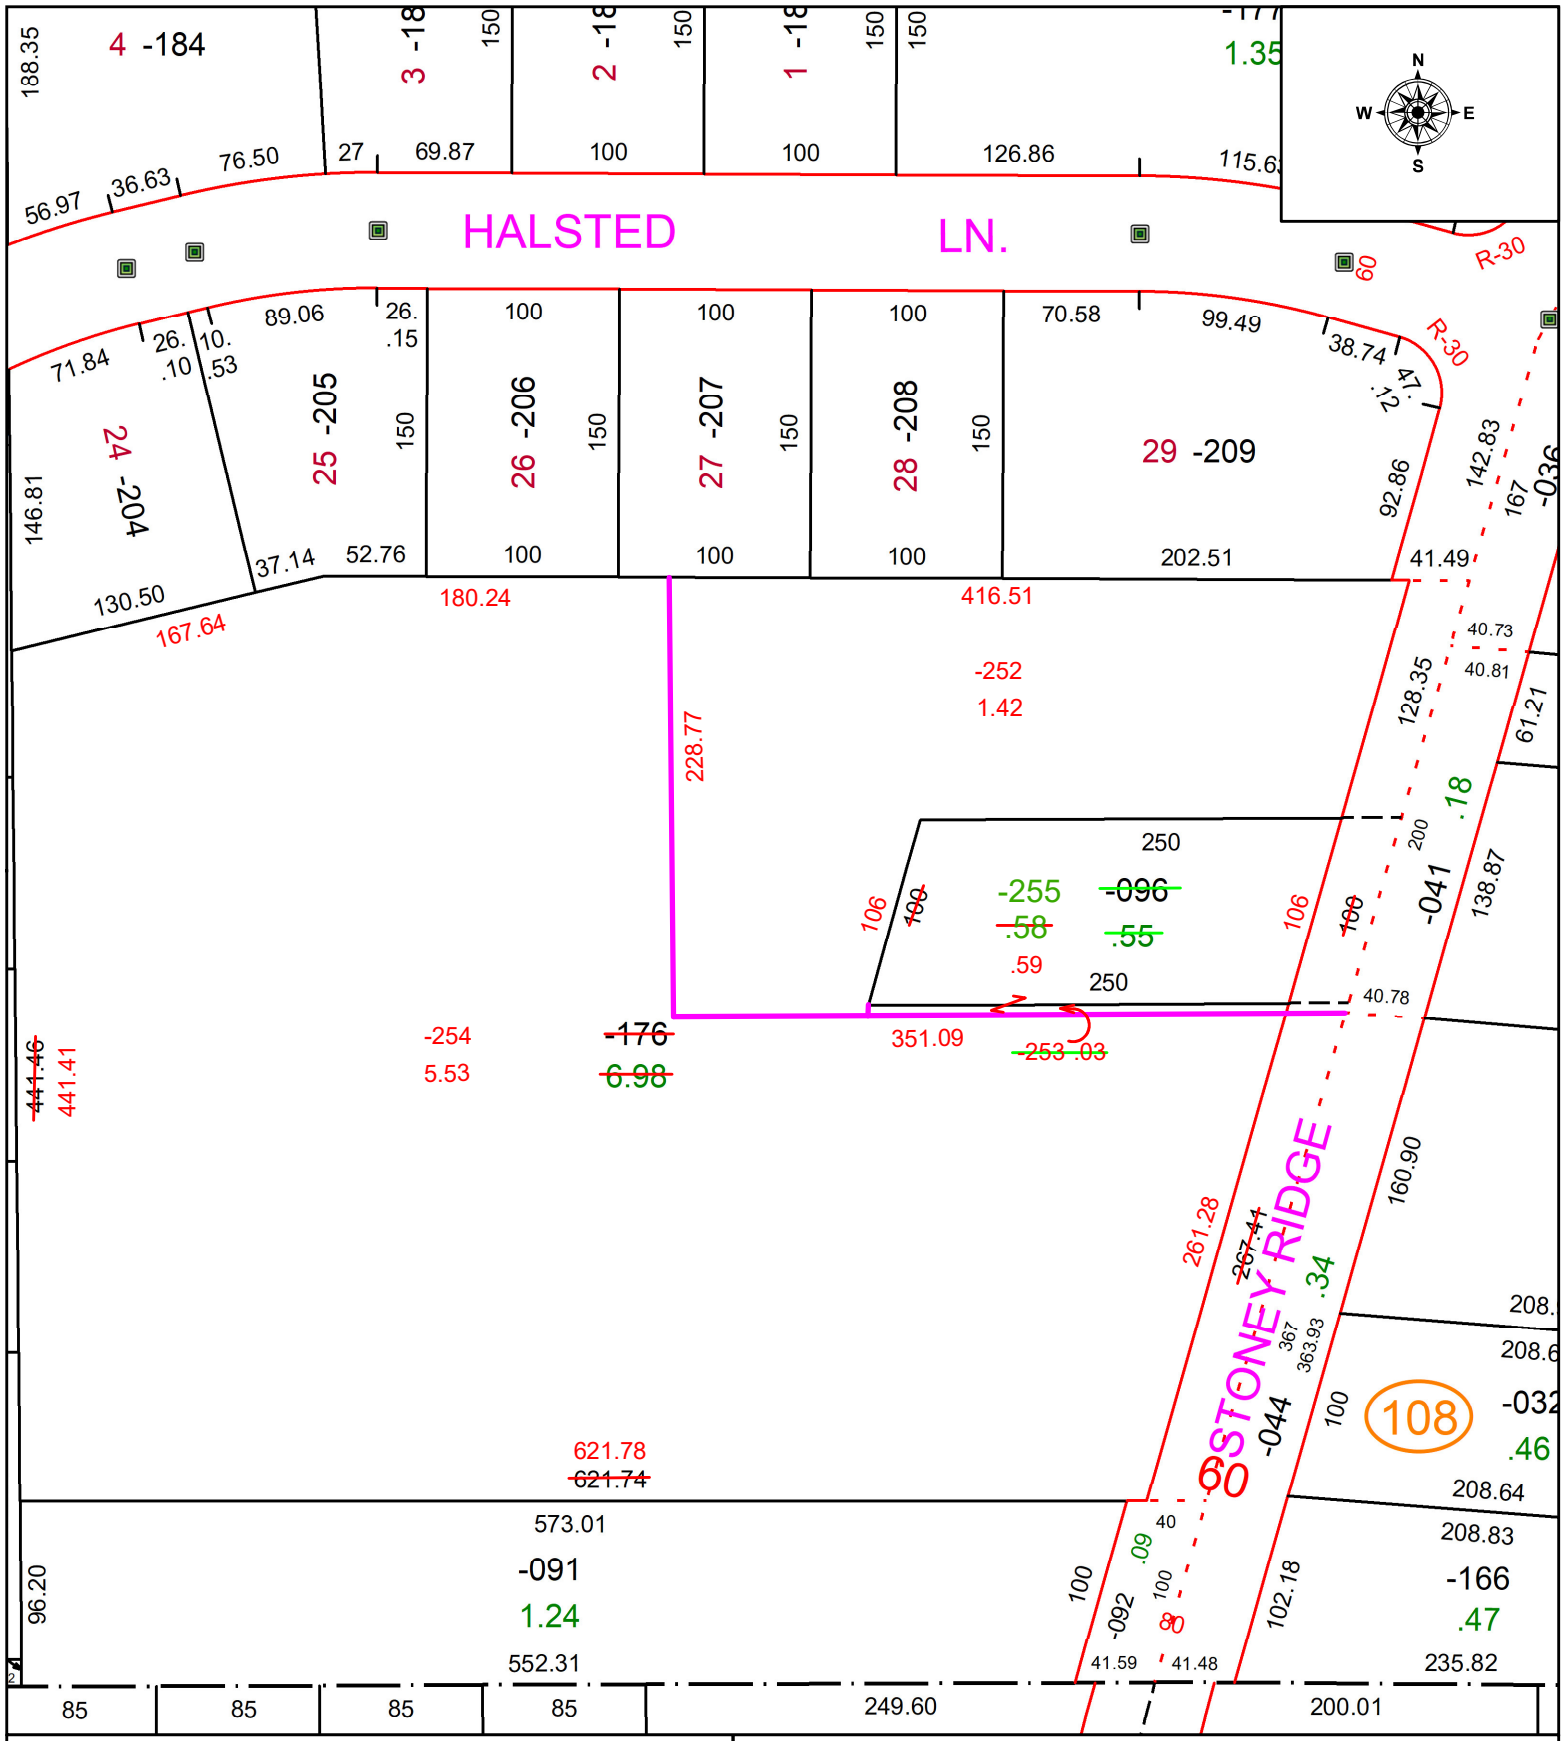

SPLITS/DEEDS PROCESSED

LORAIN COUNTY TAX MAP DEPARTMENT
226 MIDDLE AVE. ELYRIA, OH

SURVEYED BY: MICHAEL SPELLACY SURVEY # 50941

CLOSURE: 1: 895510

MAP PAGE(S): 04-00-011

APPOVED BY: WRZ **DATE:** 7/14/2023

SCALE: 1" = 100 **PRIOR INSTRUMENT:** #2022-0888260