PARENT PARCEL: 04-00-019-101-067
CHILD PARCEL: MAP CORRECTION TO CORRECT ACREAGE PRIOR INSTR. # 20210824711
STARTING POINT: XXXXXXXXXXX

21-04726-A

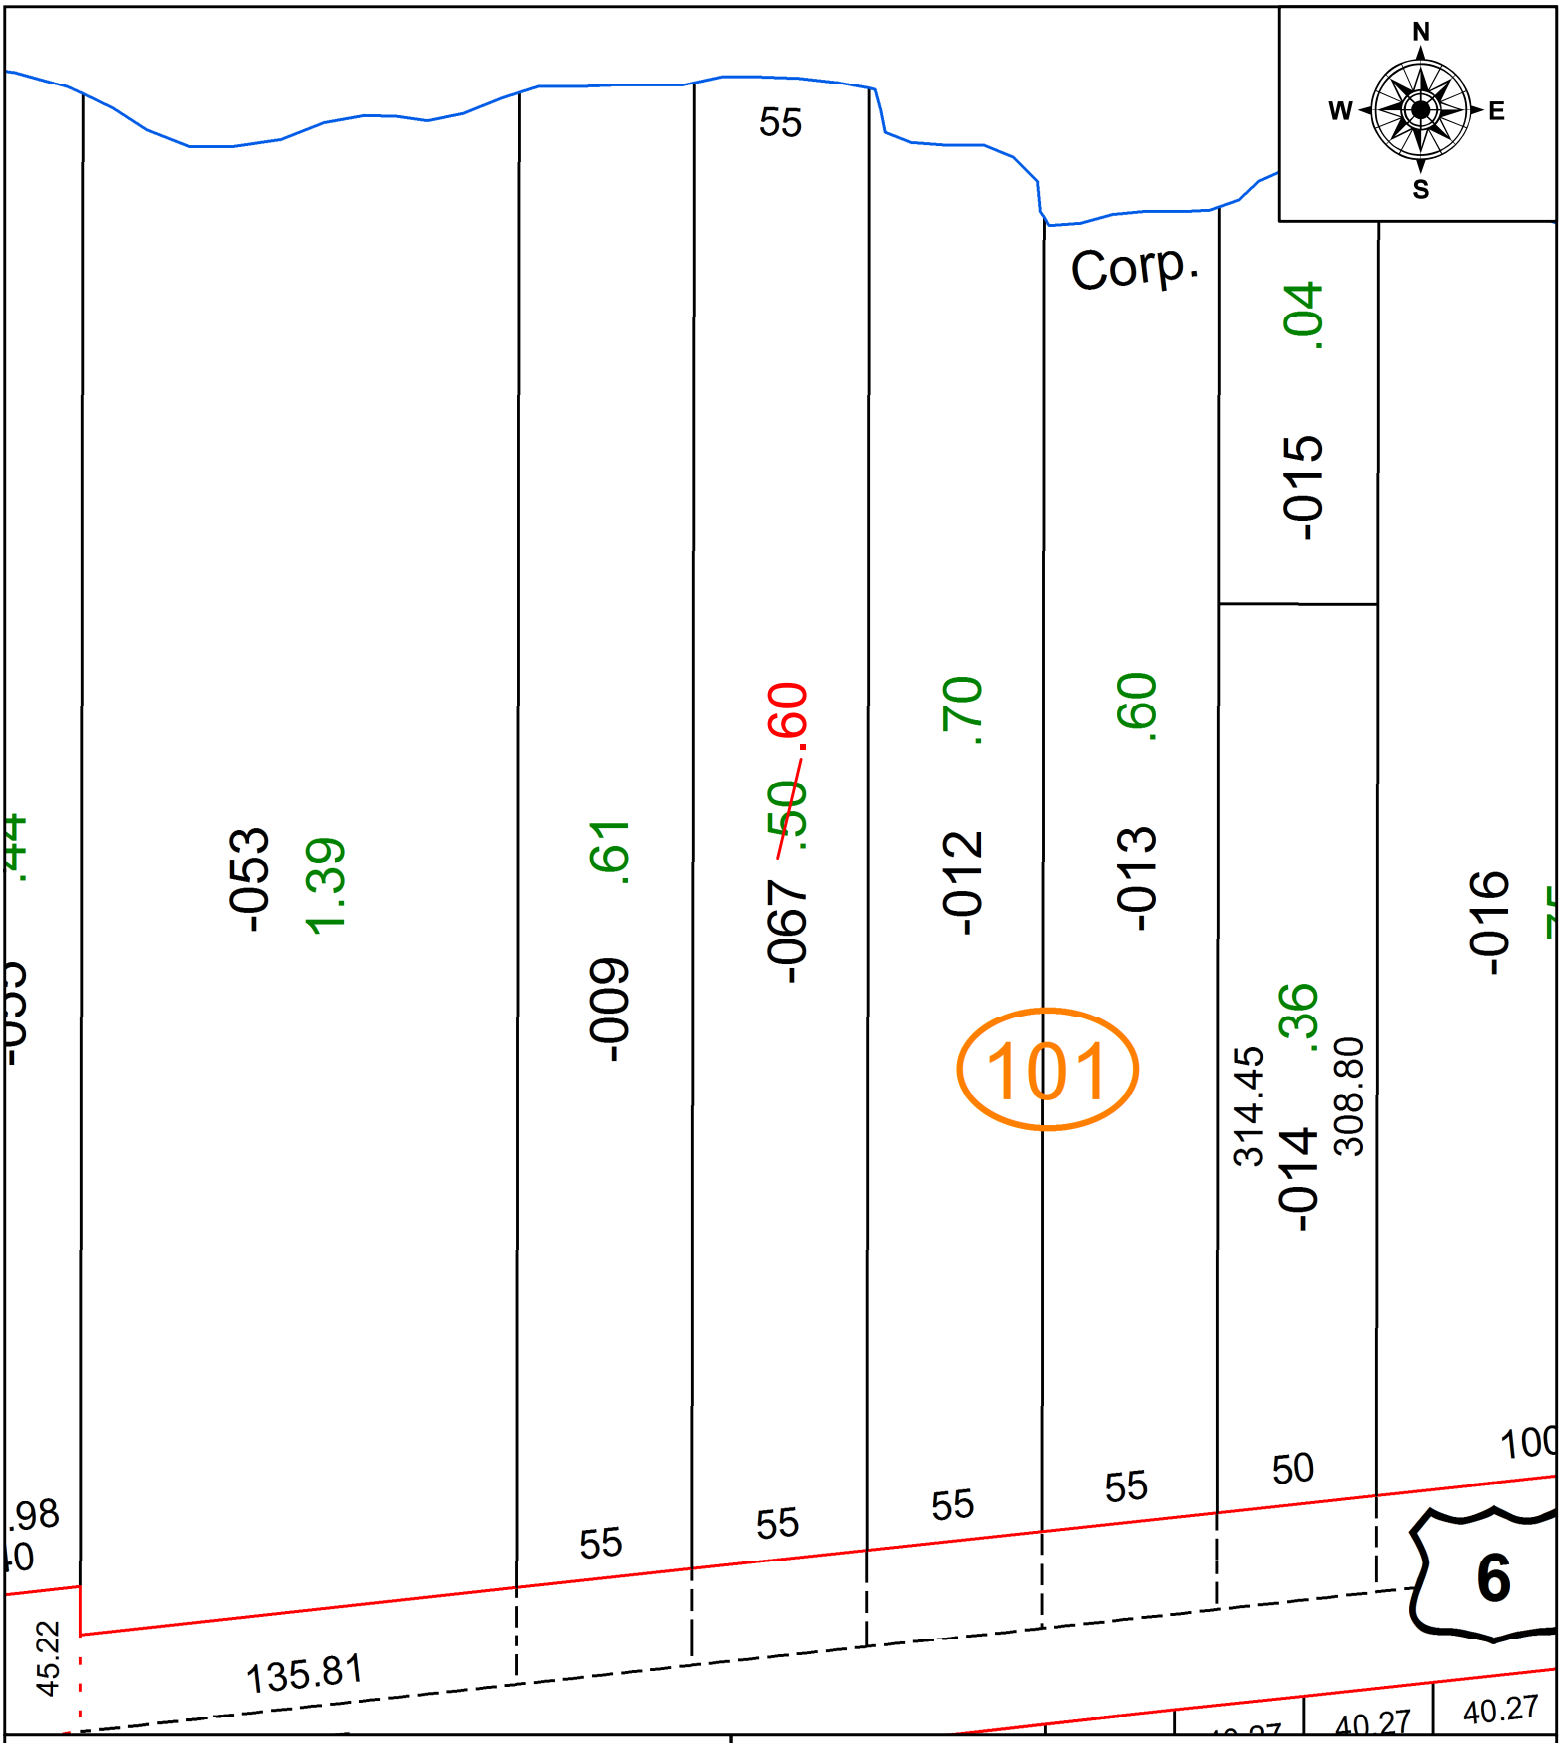

SPLITS/DEEDS PROCESSED
LORAIN COUNTY TAX MAP DEPARTMENT
226 MIDDLE AVE. ELYRIA, OH

SURVEYED BY: XXXXXXXXXX
CLOSURE: XXXXXXXXXX
MAP PAGE(S): 04-00-019
APPOVED BY: DMA **DATE:** 11/19/2021
SCALE: 1" = 60' **PRIOR INSTRUMENT:** 20210824711