PARENT PARCEL: 13-09-007-000-004 & -012

CHILD PARCEL: 13-09-007-000-013

STARTING POINT: N.W. CORNER OF O.L. 7

21-04728-C

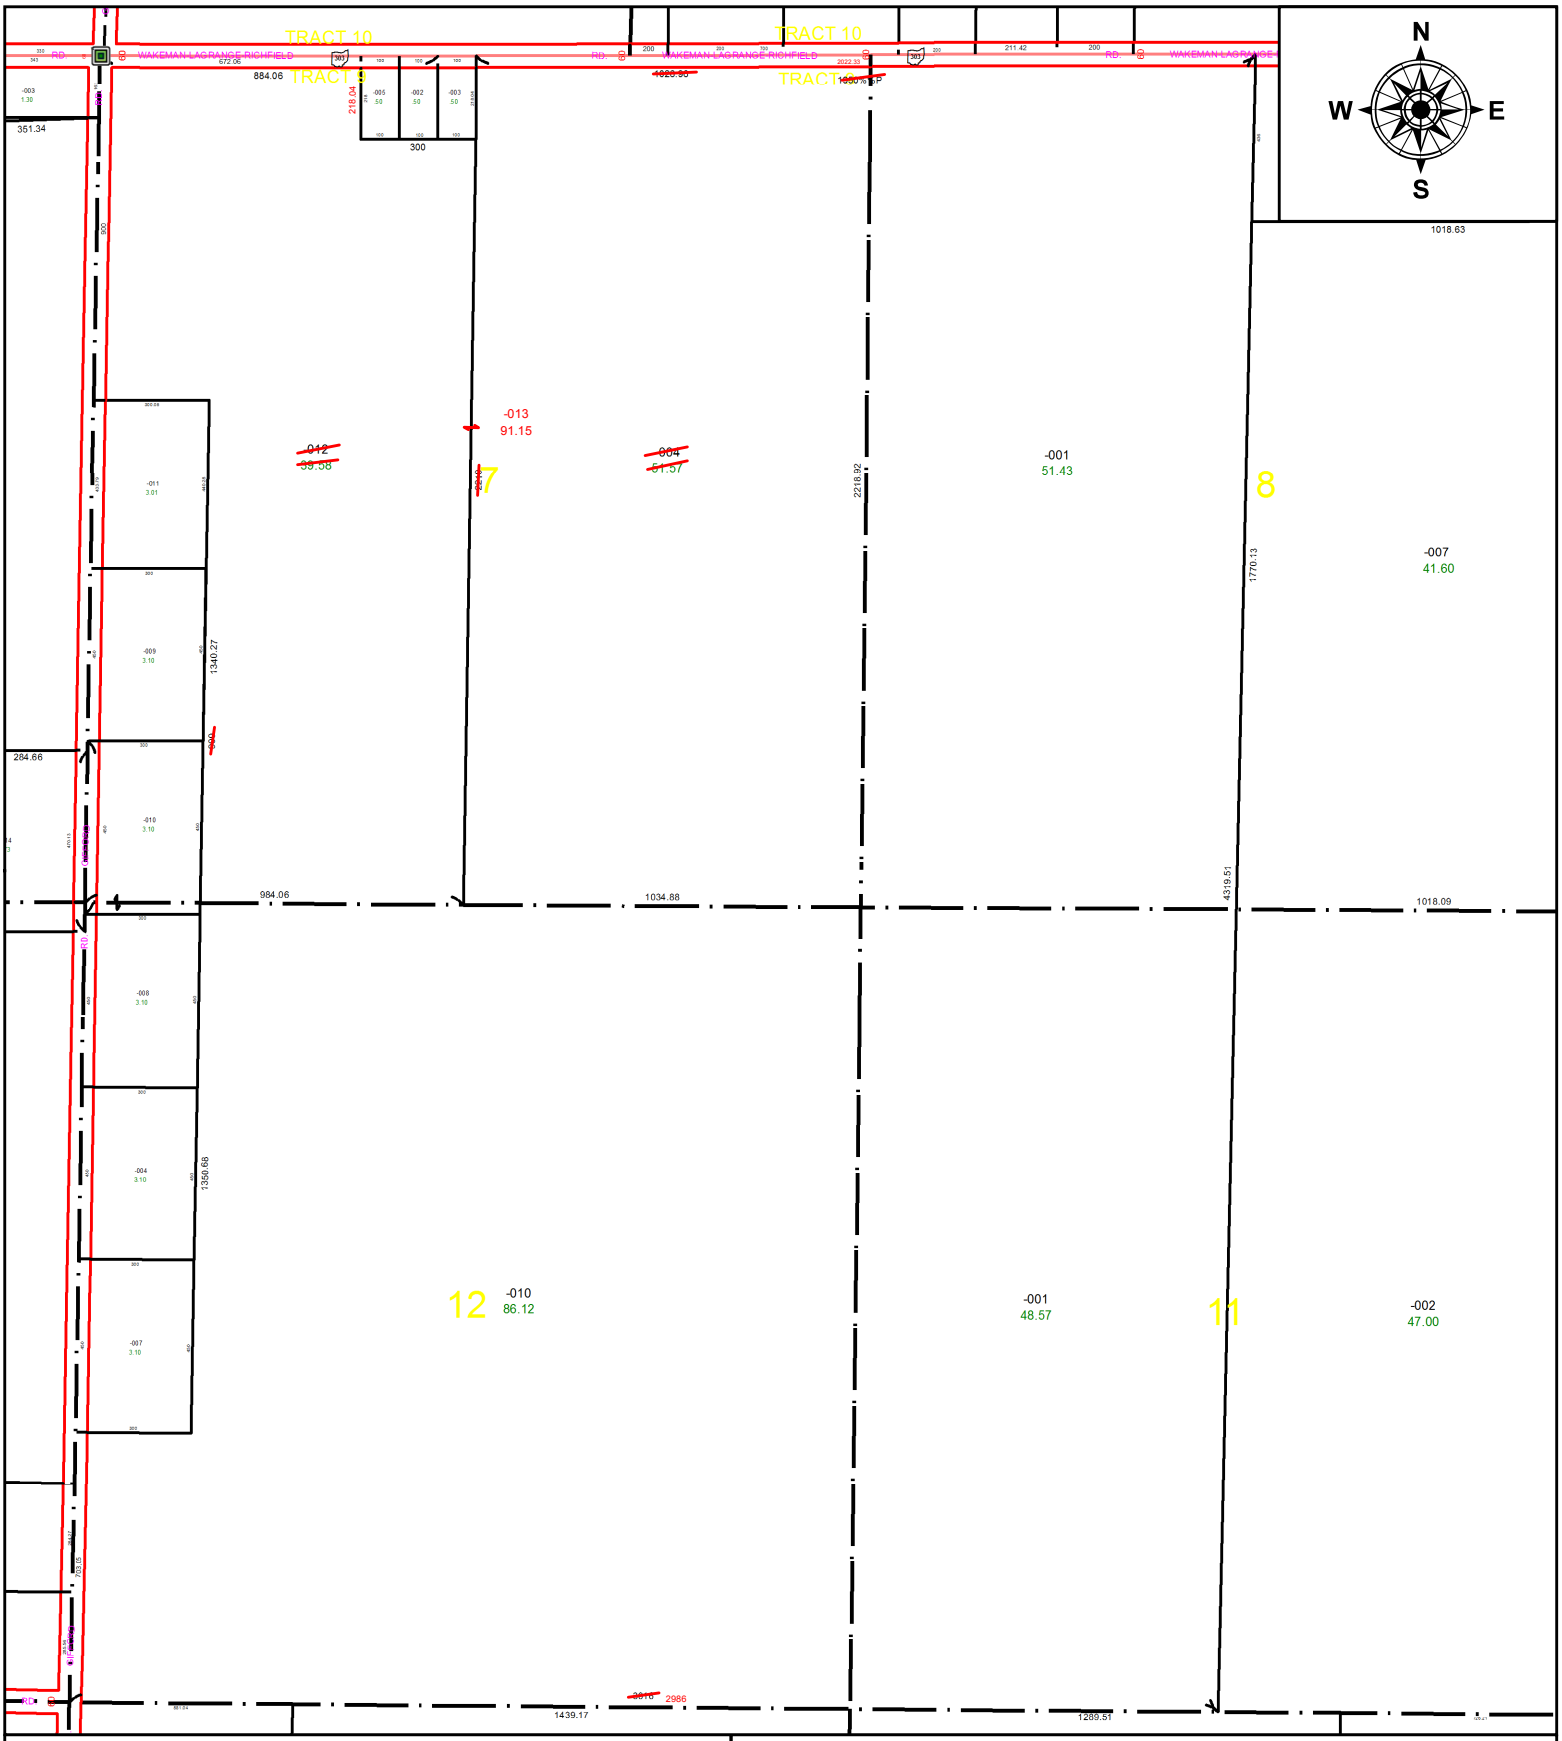

SPLITS/DEEDS PROCESSED

LORAIN COUNTY TAX MAP DEPARTMENT
226 MIDDLE AVE. ELYRIA, OH

SURVEYED BY: VIRGIL LANDIS

CLOSURE: 1: 2304265

MAP PAGE(S): 13-09-007, 13-09-008, 13-09-011 & -13-09-012

APPOVED BY: DMA **DATE:** 11/23/21

SCALE: 1" = 500' **PRIOR INSTRUMENT:** 20210821618