PARENT PARCEL: 13-11-016-109-051 & -052

CHILD PARCEL: 13-11-016-109-053, -054, & -055

STARTING POINT: C/L OF RT 20 AND STATE ST **AC CORR PER SURV BY TIMOTHY D. HOZALSKI**

23-04729

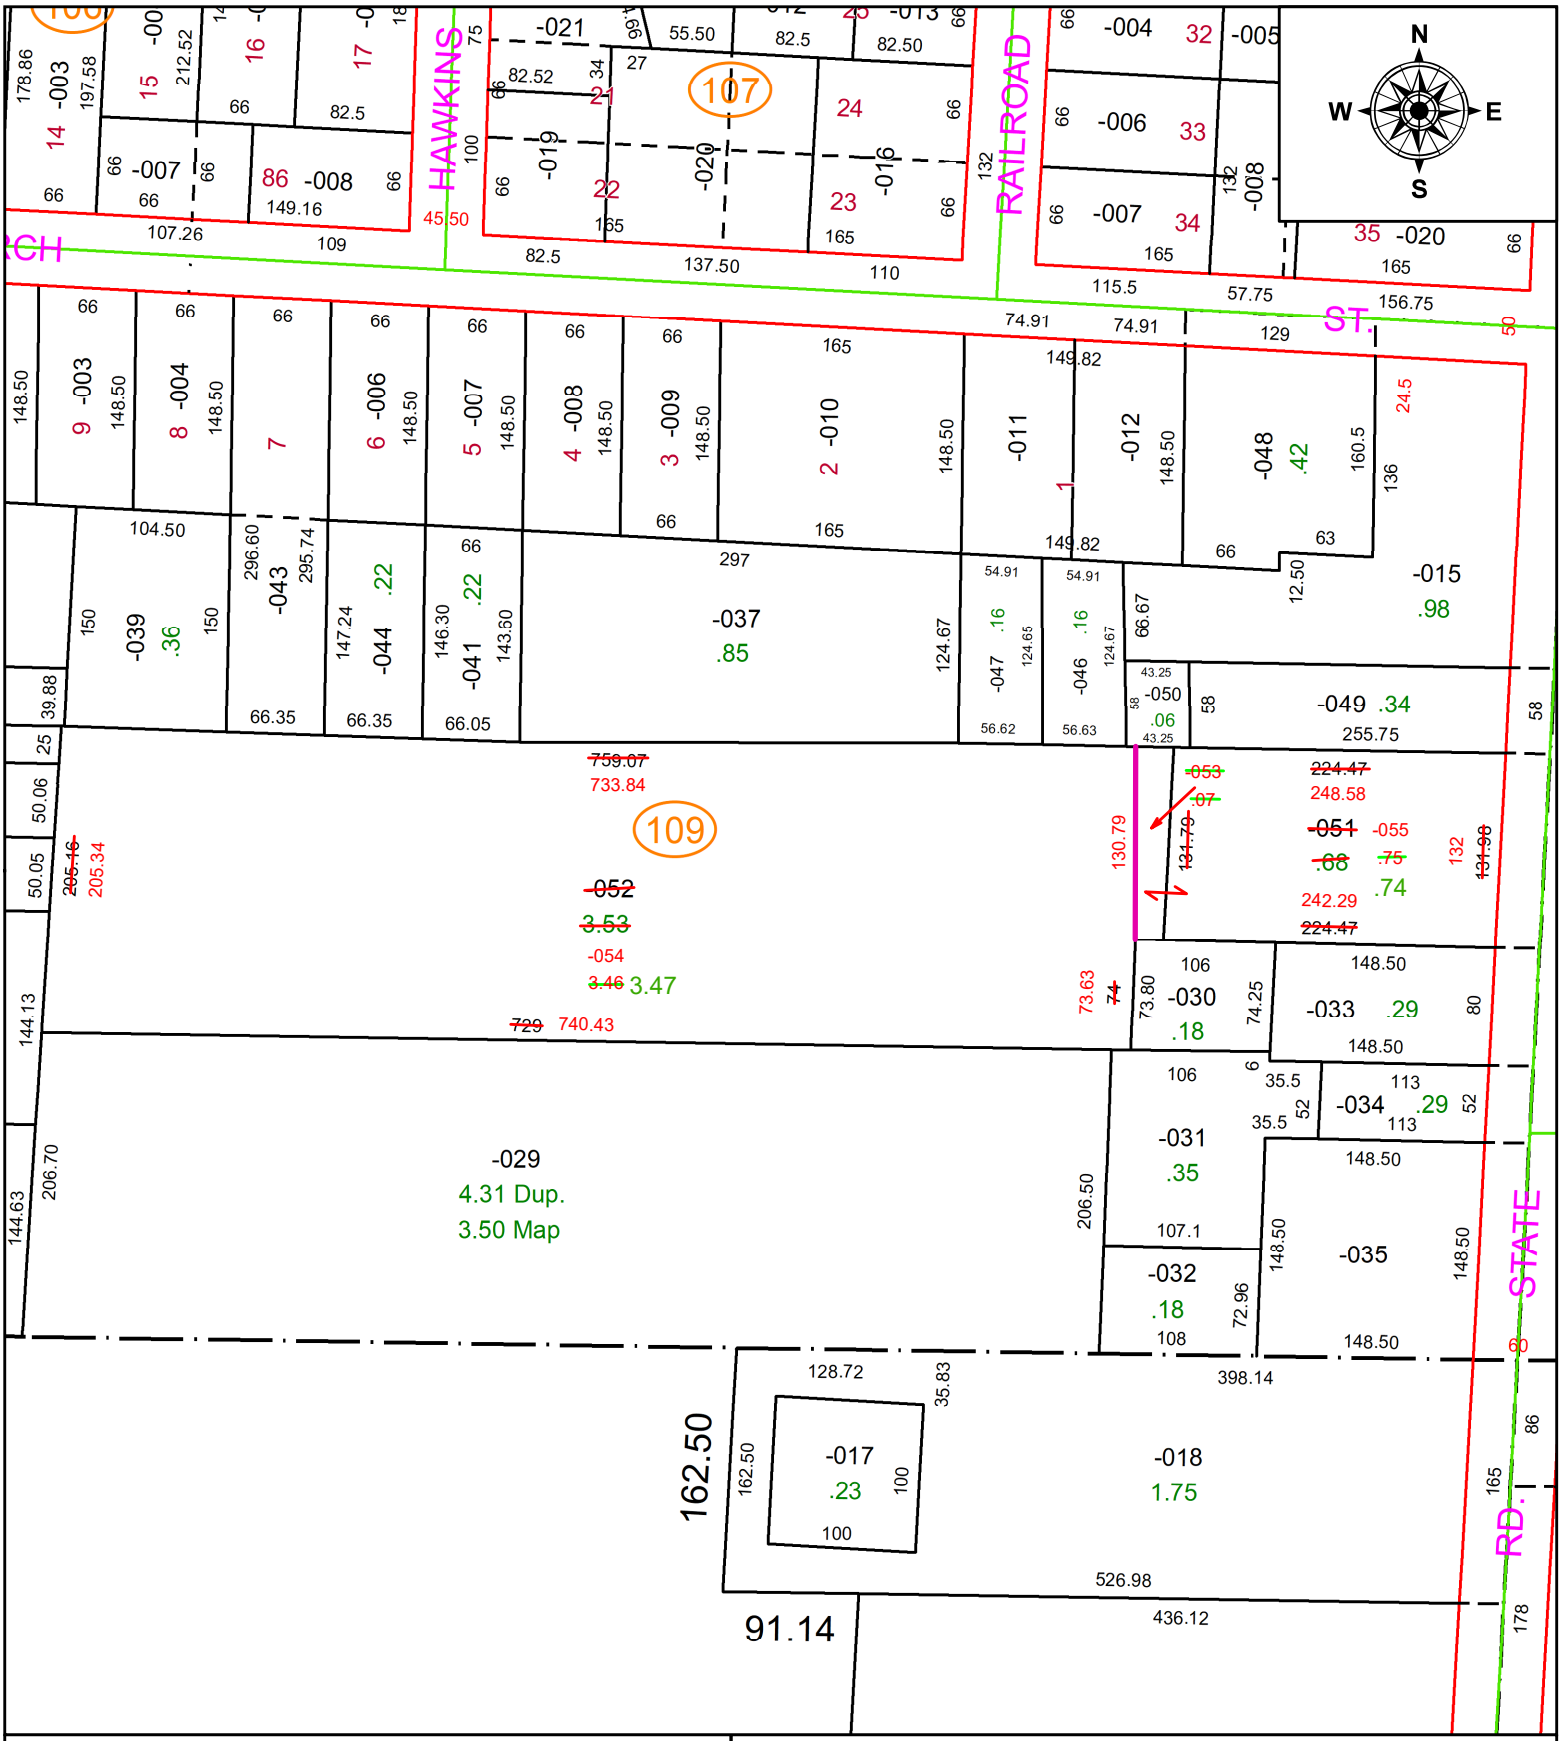

SPLITS/DEEDS PROCESSED

LORAIN COUNTY TAX MAP DEPARTMENT
226 MIDDLE AVE. ELYRIA, OH

SURVEYED BY: TIMOTHY D. HOZALSKI **SURV # 50950**

CLOSURE: 1: 37277

MAP PAGE(S): 13-11-016

APPOVED BY: AC **DATE:** July 25, 2023

SCALE: 1 in = 130 ft **PRIOR INSTRUMENT:** 2018- 0680614