PARENT PARCEL: 03-00-107-105-012

CHILD PARCEL: MAP CORRECTION ONLY

STARTING POINT: C/L OF DUNTON RD AND ELYRIA AVE

21-04734-C

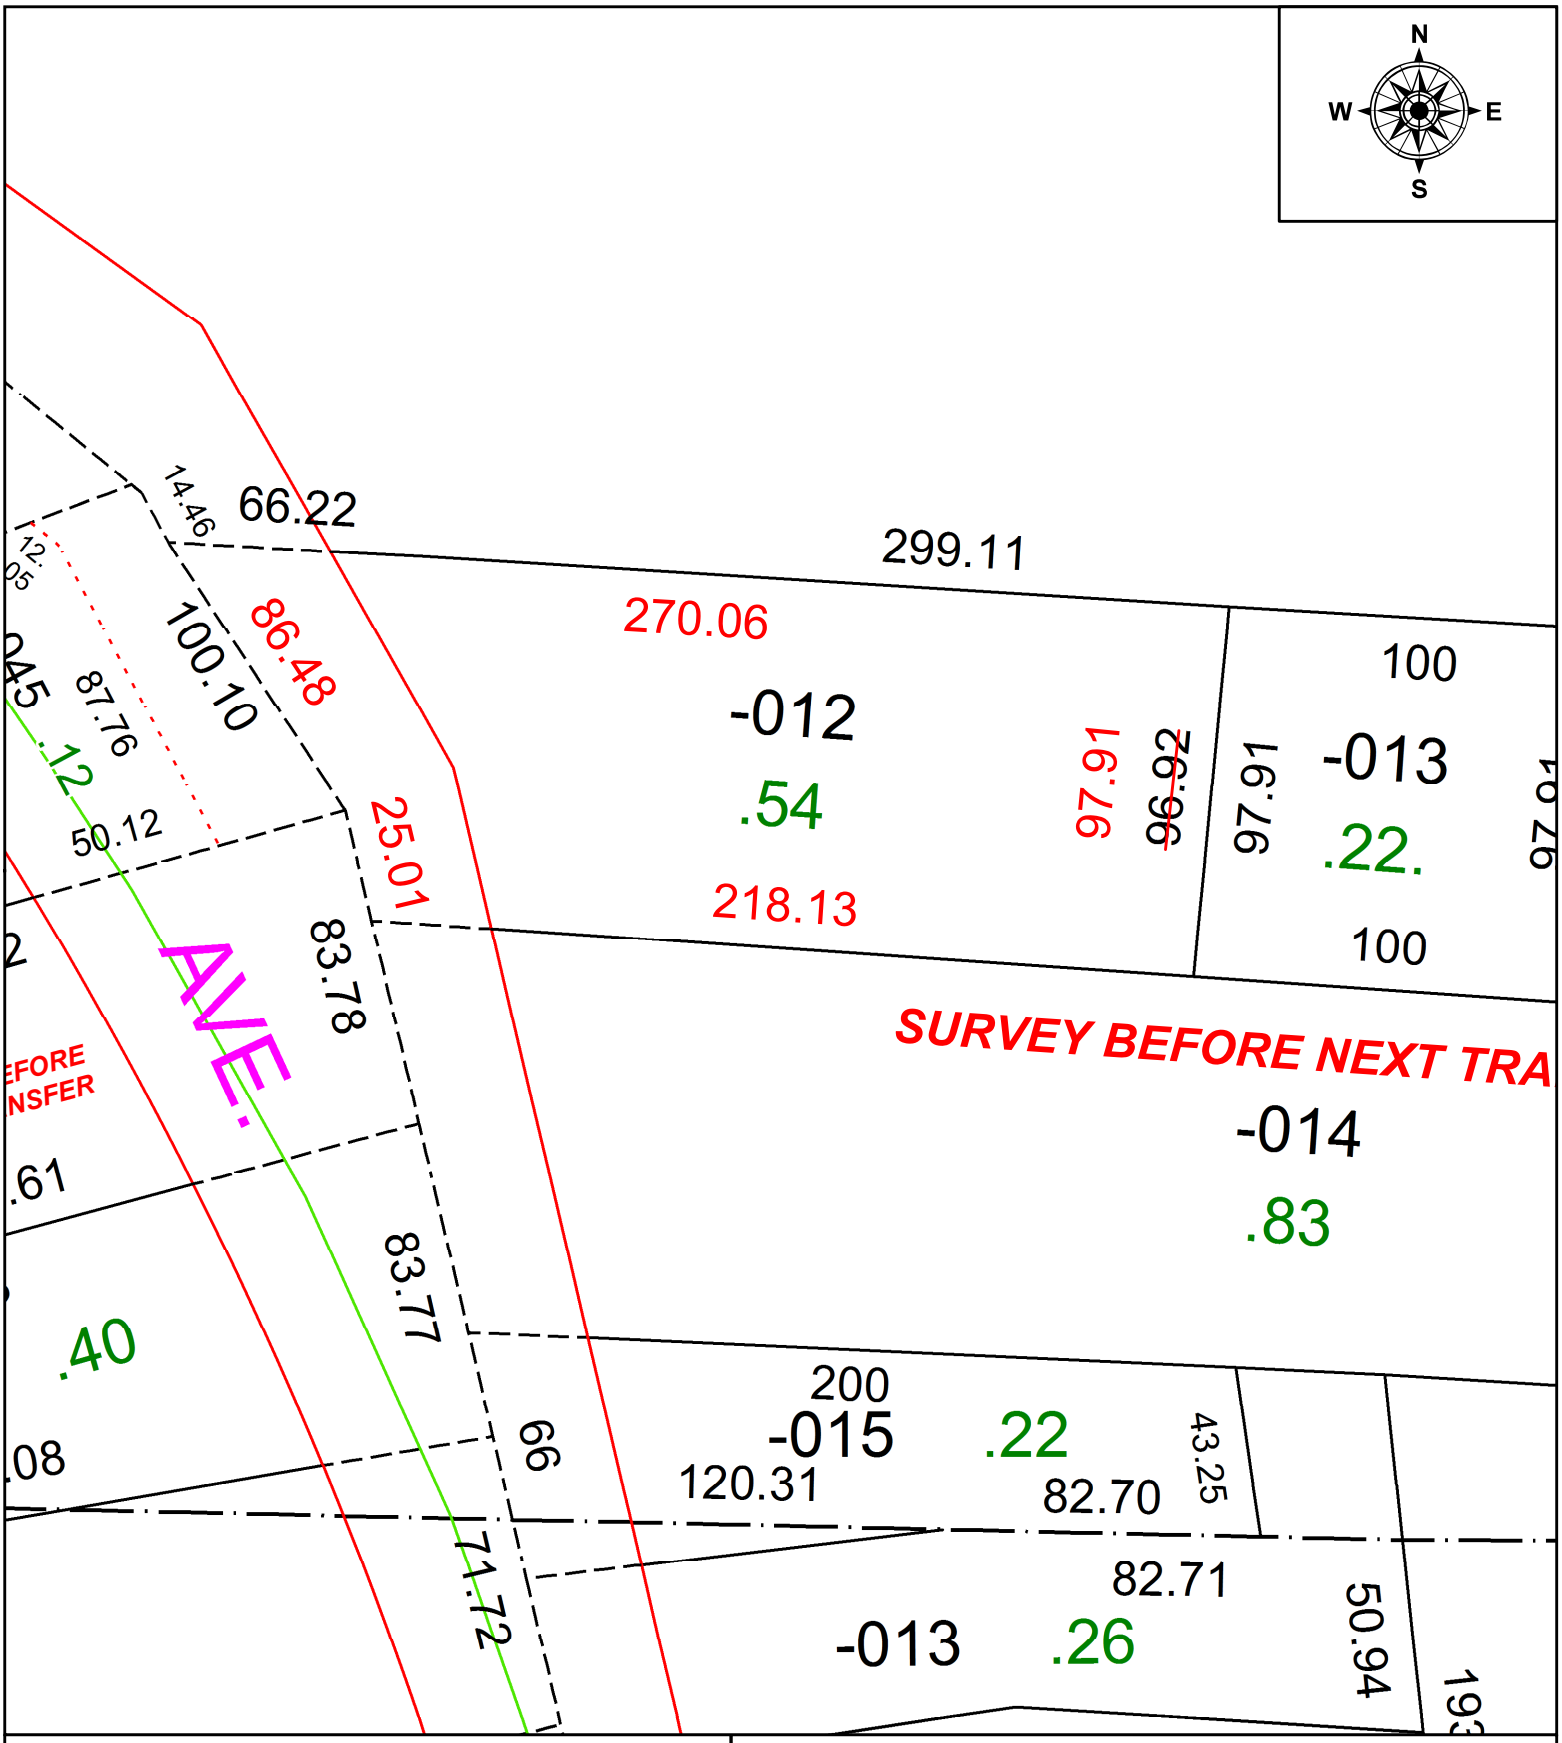

SPLITS/DEEDS PROCESSED

LORAIN COUNTY TAX MAP DEPARTMENT
226 MIDDLE AVE. ELYRIA, OH

SURVEYED BY: SCOTT J. CASEY
CLOSURE: 1: 74202
MAP PAGE(S): 03-00-107-B
APPOVED BY: AC **DATE:** 11/29/2021
SCALE: 1" = 50 **PRIOR INSTRUMENT:** 2021- 0819162