PARENT PARCEL: 03-00-075-112-020, 03-00-076-112-003, -005, & -006

CHILD PARCEL: 03-00-075-112-031, 03-00-076-112-014, -015, & -016

STARTING POINT: INTERSECTION OF C/LS OF FARR AVE & NORTH RIDGE RD

23-04734

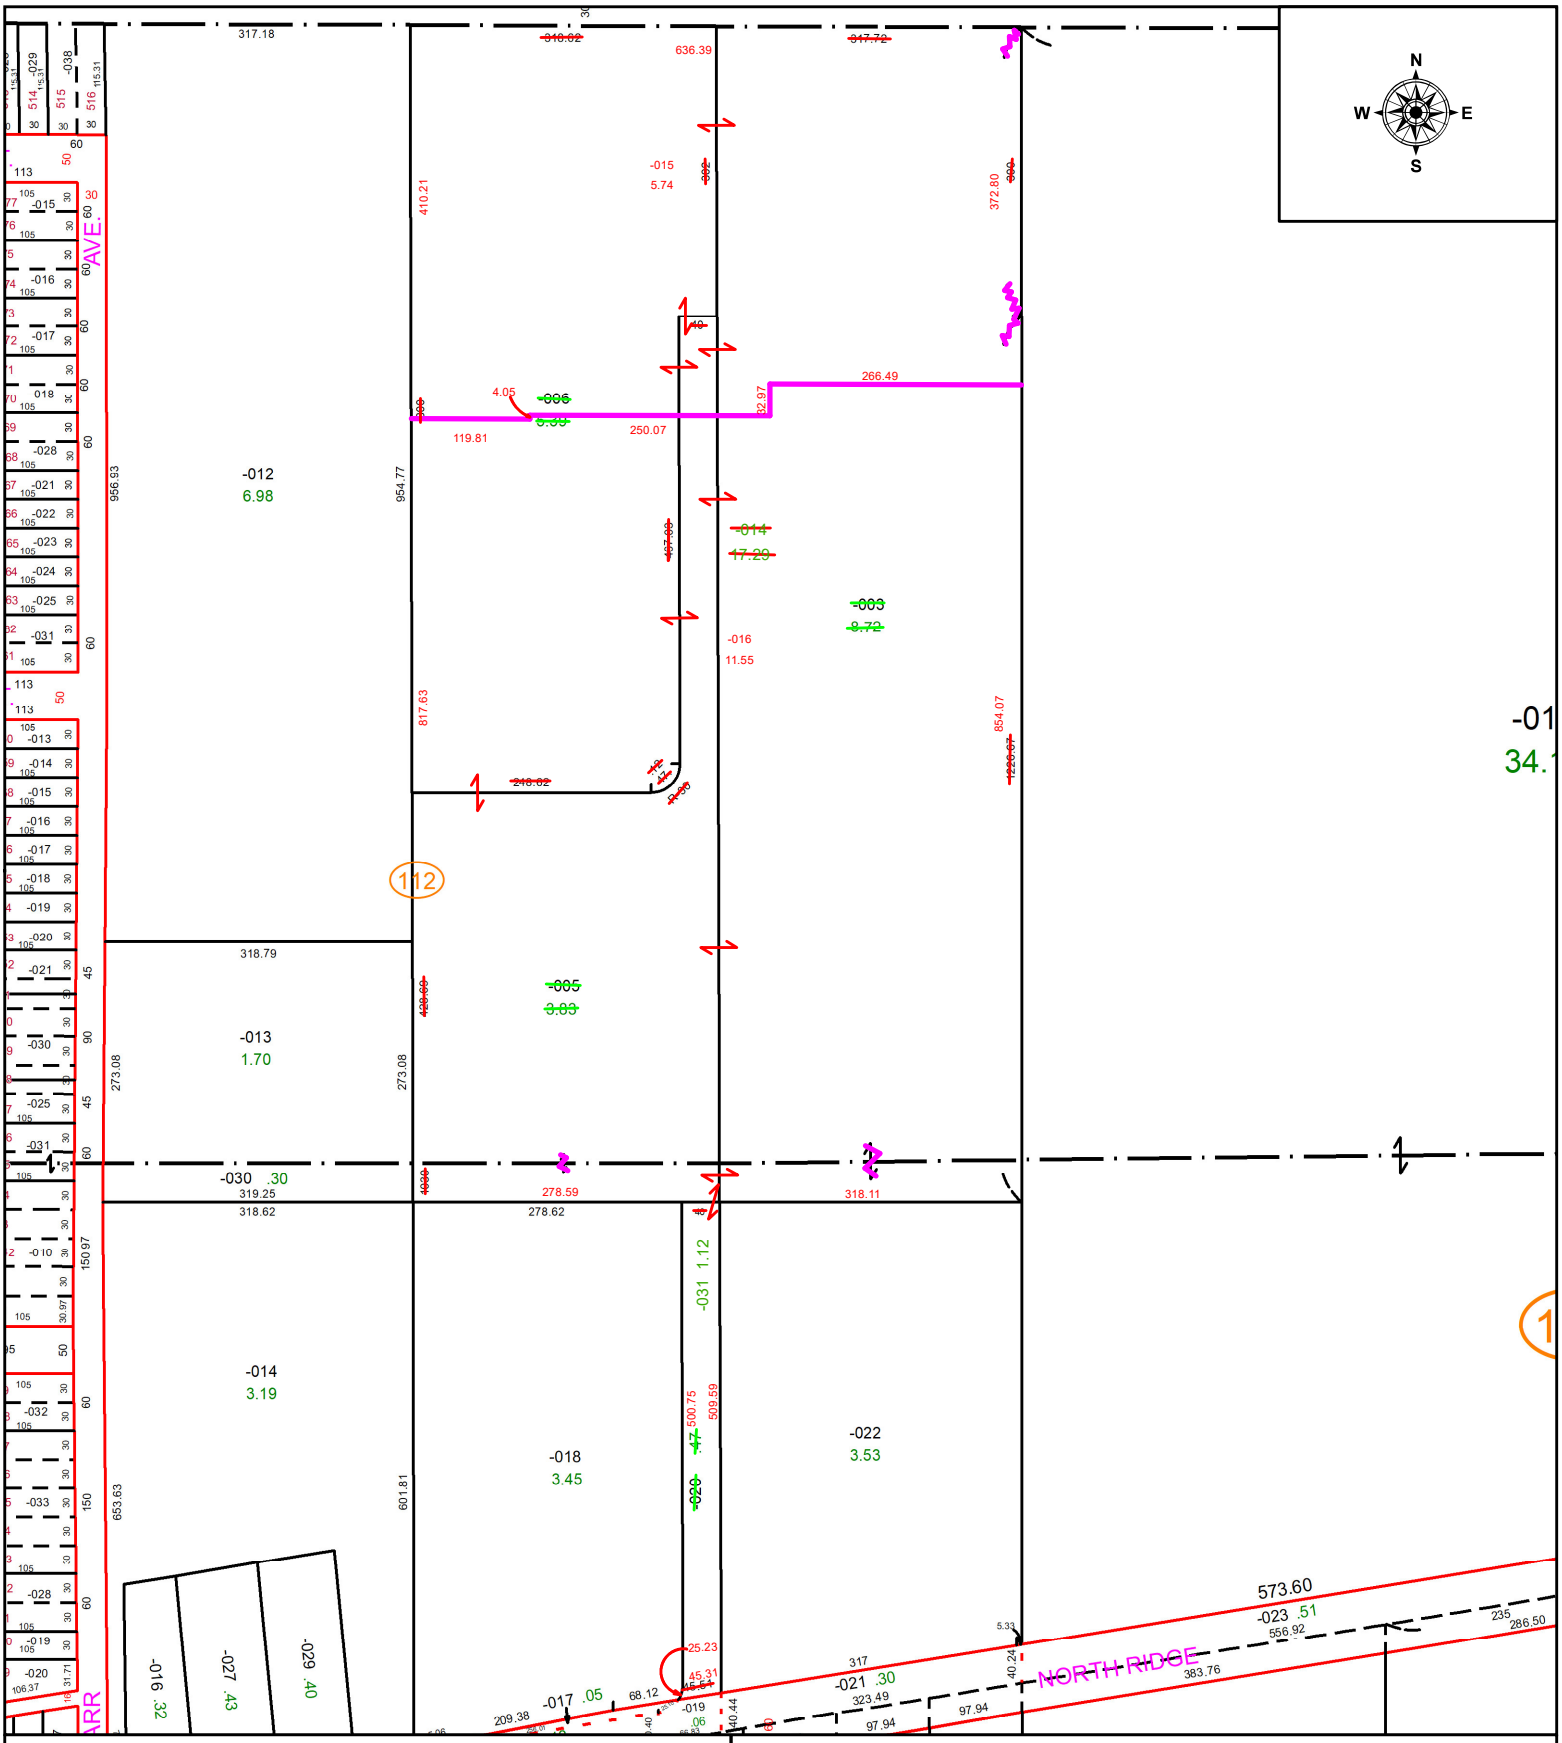

SPLITS/DEEDS PROCESSED

LORAIN COUNTY TAX MAP DEPARTMENT
226 MIDDLE AVE. ELYRIA, OH

SURVEYED BY: AMY KELLY SURVEY # 50955

CLOSURE: 1: 65983

MAP PAGE(S): 03-00-075 & 03-00-076

APPOVED BY: WRZ **DATE:** 7/31/2023

SCALE: 1" = 200 **PRIOR INSTRUMENT:** #1995-0369490