PARENT PARCEL: 05-00-061-101-057 & -045
CHILD PARCEL: 05-00-061-101-058, -059, -060
STARTING POINT: CENTERLINE INTERSECTION OF OBERLIN RD & COOPER FOSTER RD

23-04735

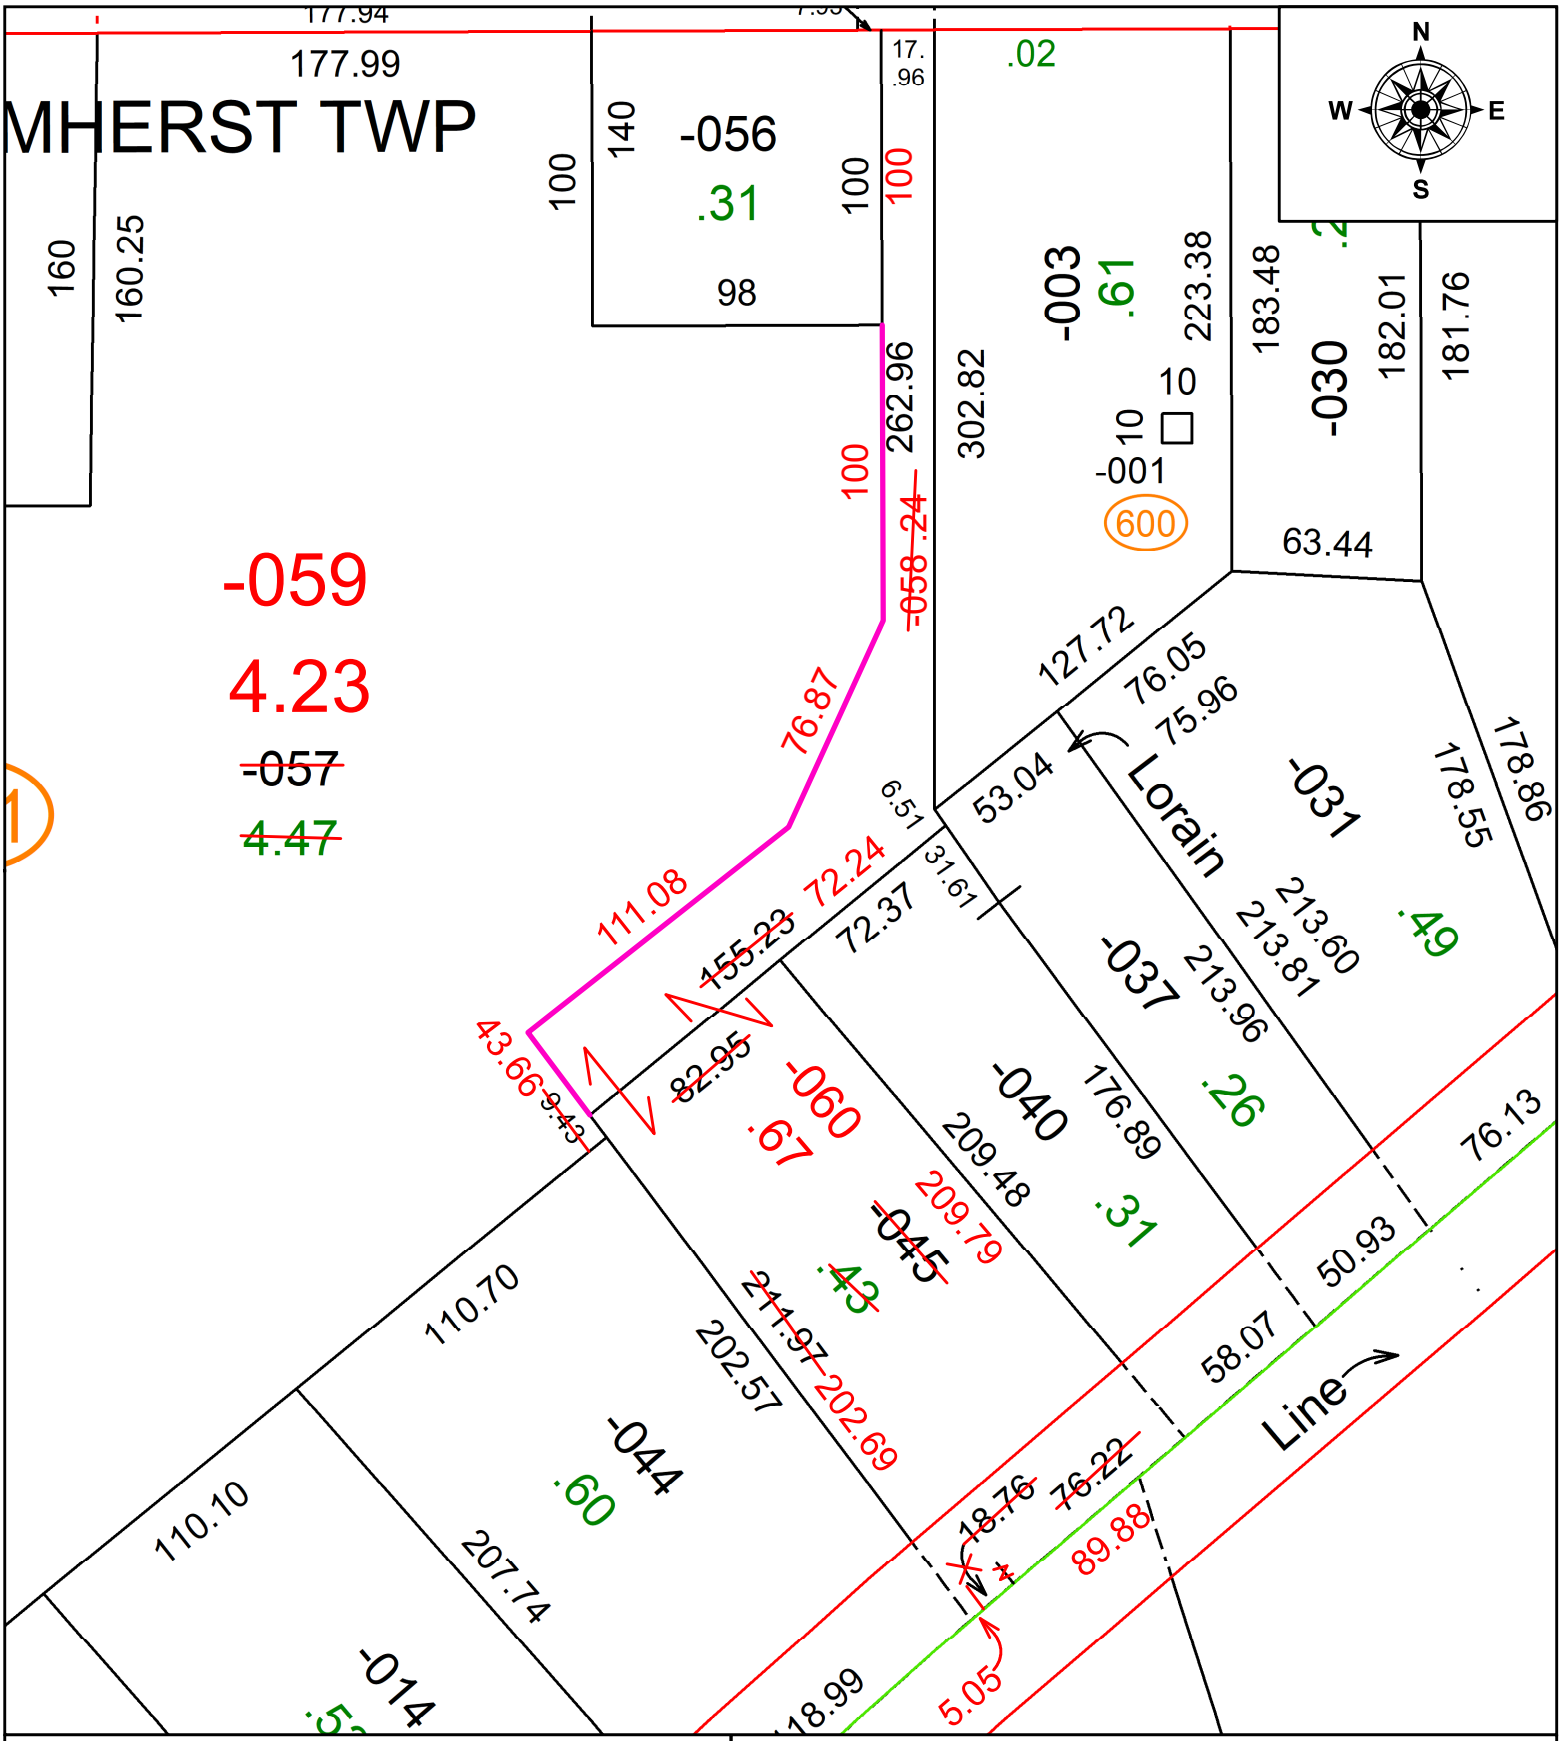

SPLITS/DEEDS PROCESSED
LORAIN COUNTY TAX MAP DEPARTMENT
226 MIDDLE AVE. ELYRIA, OH

SURVEYED BY: TIMOTHY D. HOZALSKI **SURVEY #:** 50957
CLOSURE: 1: 125,943
MAP PAGE(S): 05-00-061
APPOVED BY: SP **DATE:** 8/14/2023
SCALE: 1" = 65' **PRIOR INSTRUMENT:** 2023-0924793