PARENT PARCEL: 05-00-048-000-041 & -076
CHILD PARCEL: 05-00-048-000-082, -083, & -084
STARTING POINT: C/L OF TELEGRAPH AND LEAVITT RD

23-04736

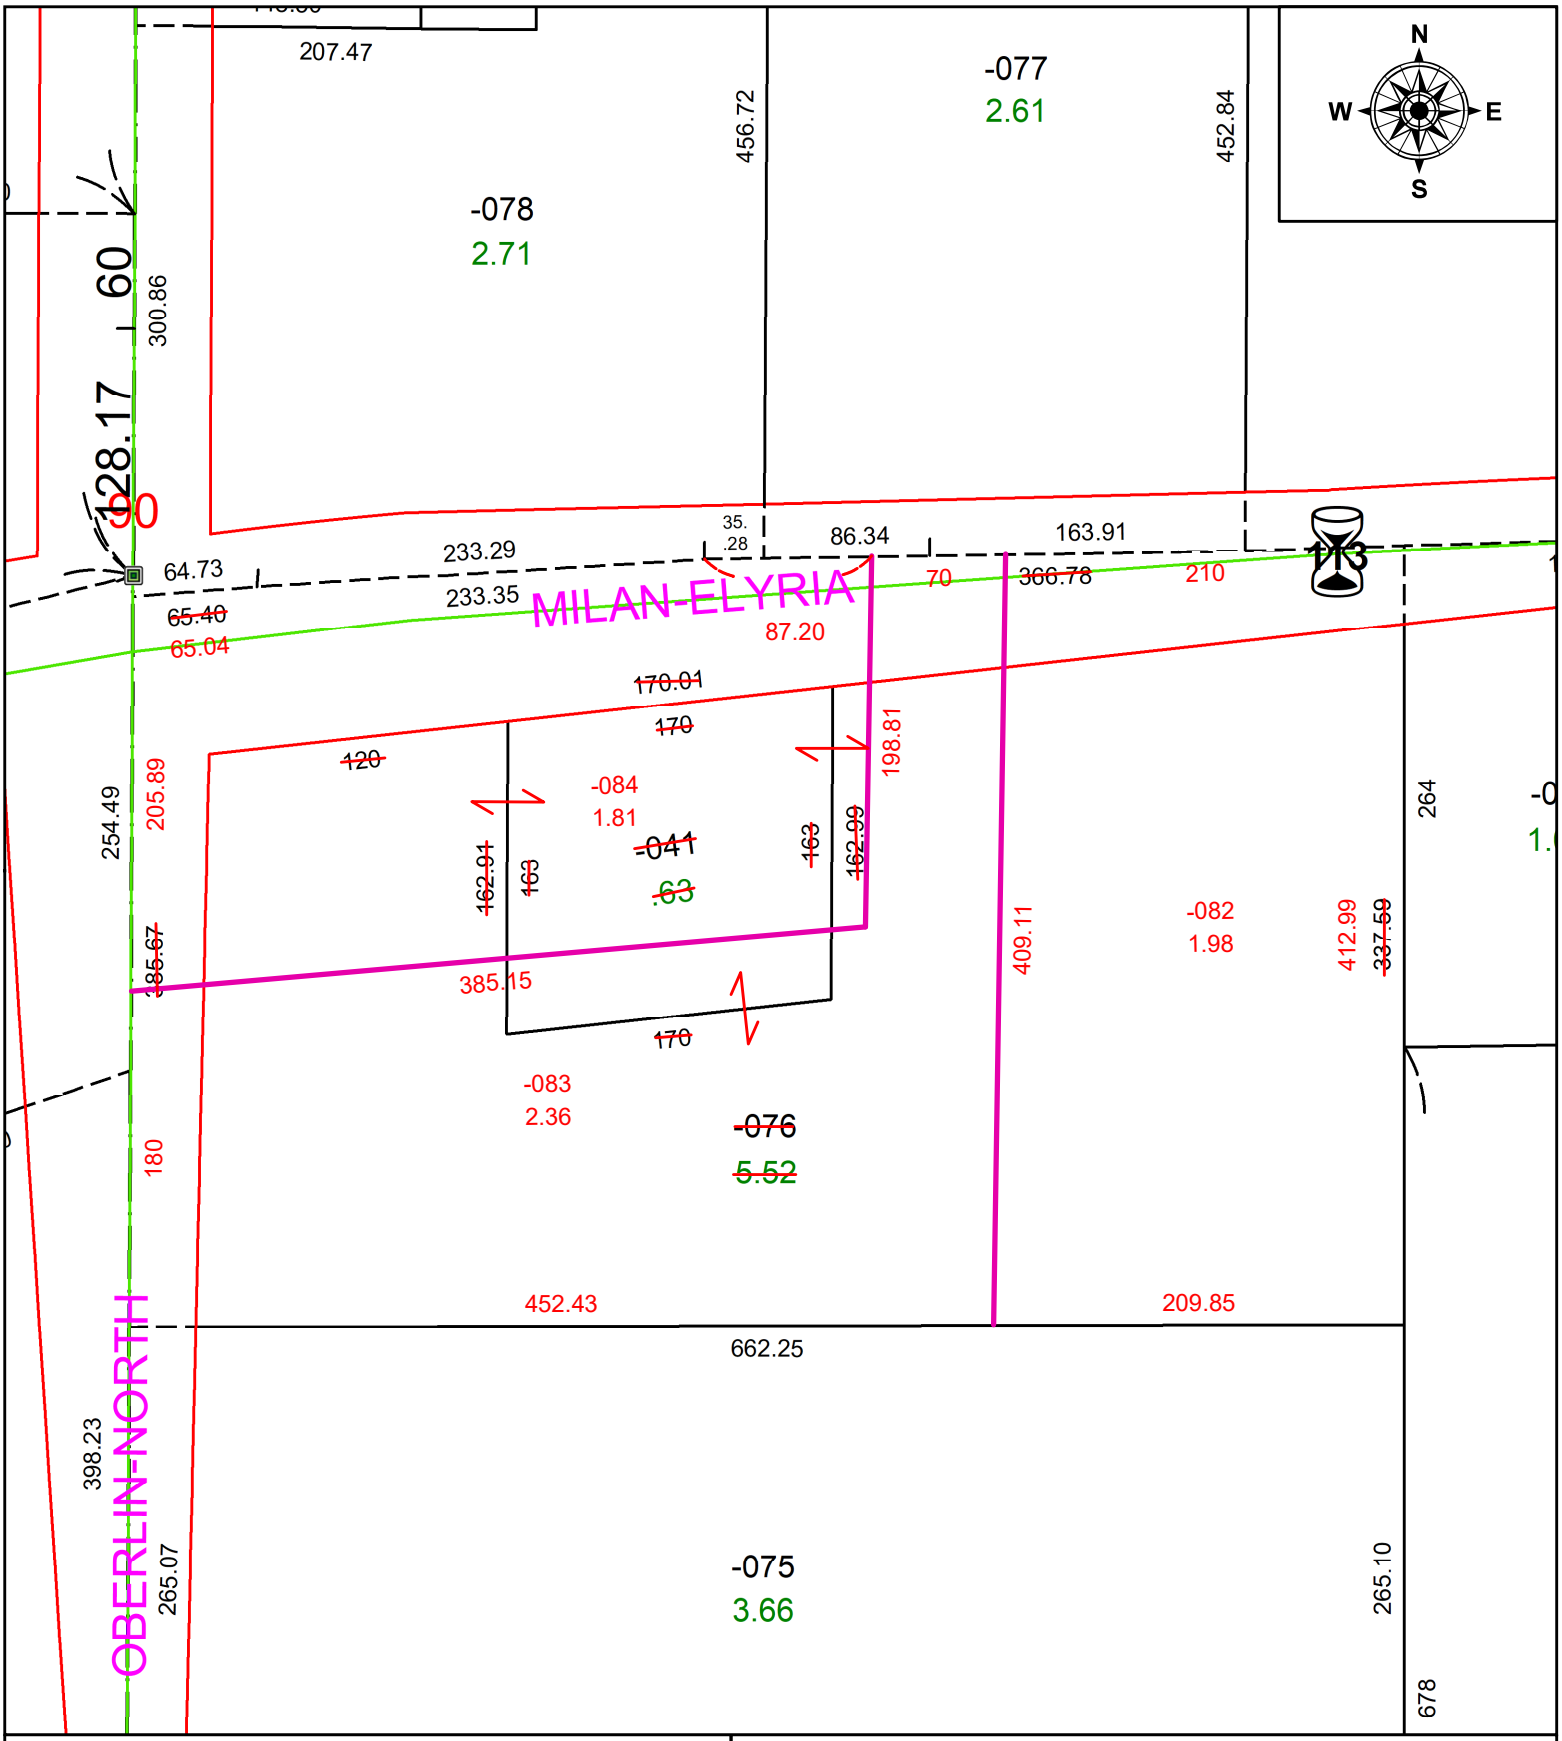

SPLITS/DEEDS PROCESSED
LORAIN COUNTY TAX MAP DEPARTMENT
226 MIDDLE AVE. ELYRIA, OH

SURVEYED BY: CHRISTOPHER J. DEMPSEY **SURV # 50973**
CLOSURE: 1: 131316
MAP PAGE(S): 05-00-048
APPOVED BY: AC **DATE:** August 16, 2023
SCALE: 1 in = 100 ft **PRIOR INSTRUMENT:** 2017- 0629325