PARENT PARCEL: 20-05-021-000-011 & 20-05-022-102-046

CHILD PARCEL: N/A ACREAGE CORRECTION PER LOUIS J. GIFFELS

STARTING POINT: INTERSECTION OF C/Ls OF SR 511 & BURSELY RD

21-04737-C

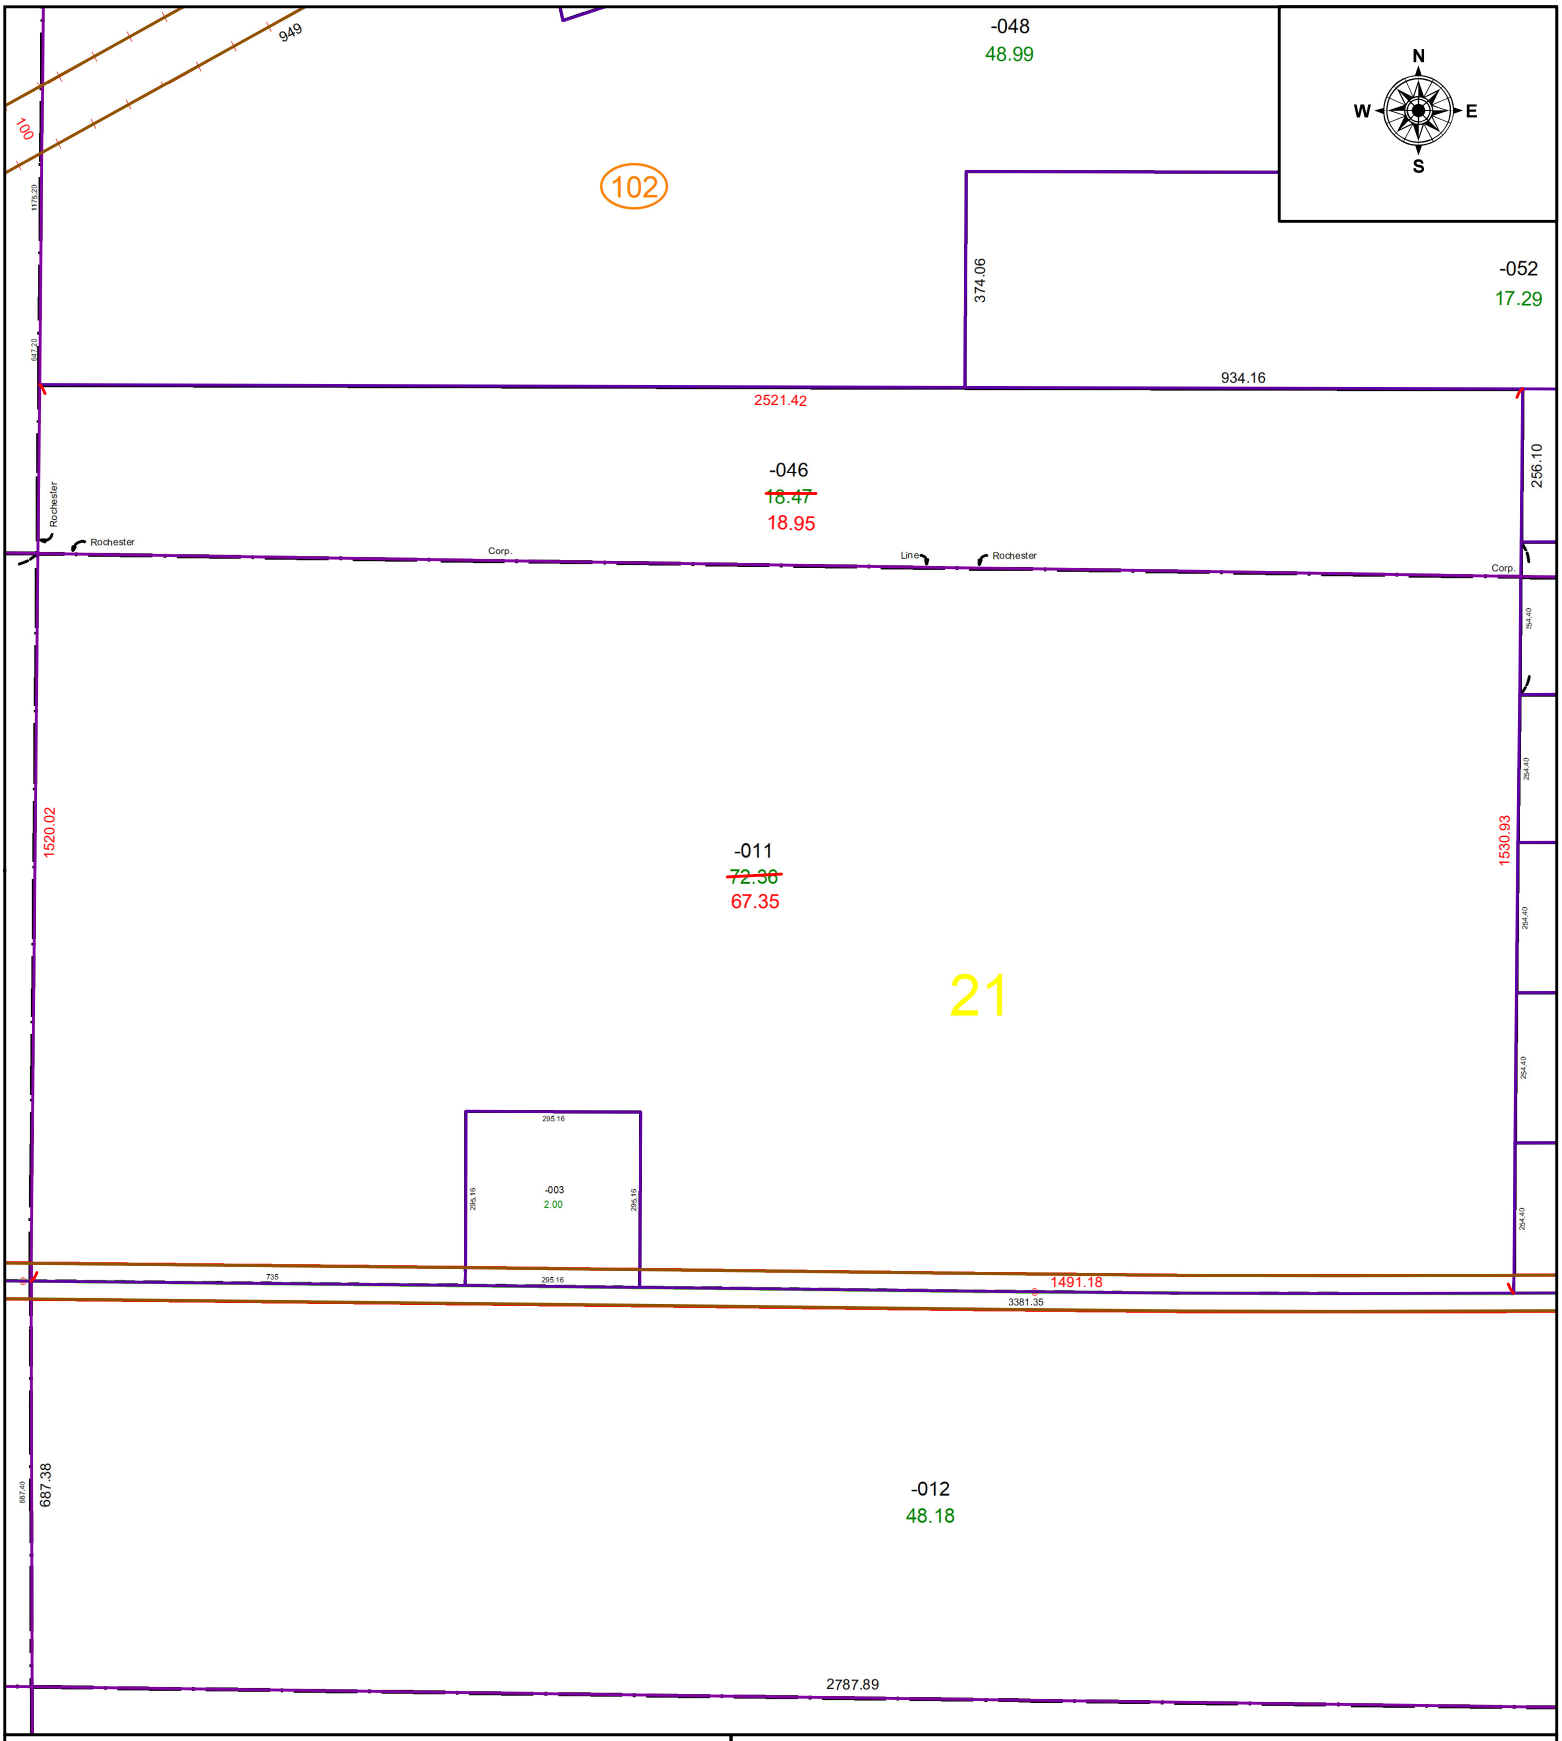

SPLITS/DEEDS PROCESSED

LORAIN COUNTY TAX MAP DEPARTMENT
226 MIDDLE AVE. ELYRIA, OH

SURVEYED BY: LOUIS J. GIFFELS
CLOSURE: 1: 1458163
MAP PAGE(S): 20-05-021
APPOVED BY: WRZ **DATE:** 12/3/2021
SCALE: 1" = 325 **PRIOR INSTRUMENT:** 2021-0815998