PARENT PARCEL: 05-00-016-101-078, -079 & -087

CHILD PARCEL: 05-00-016-101-195

STARTING POINT: S.E. CORNER OF S/L 17 OAK POINT ESTATES # 2 P.V. 25 PG. 64

23-04748

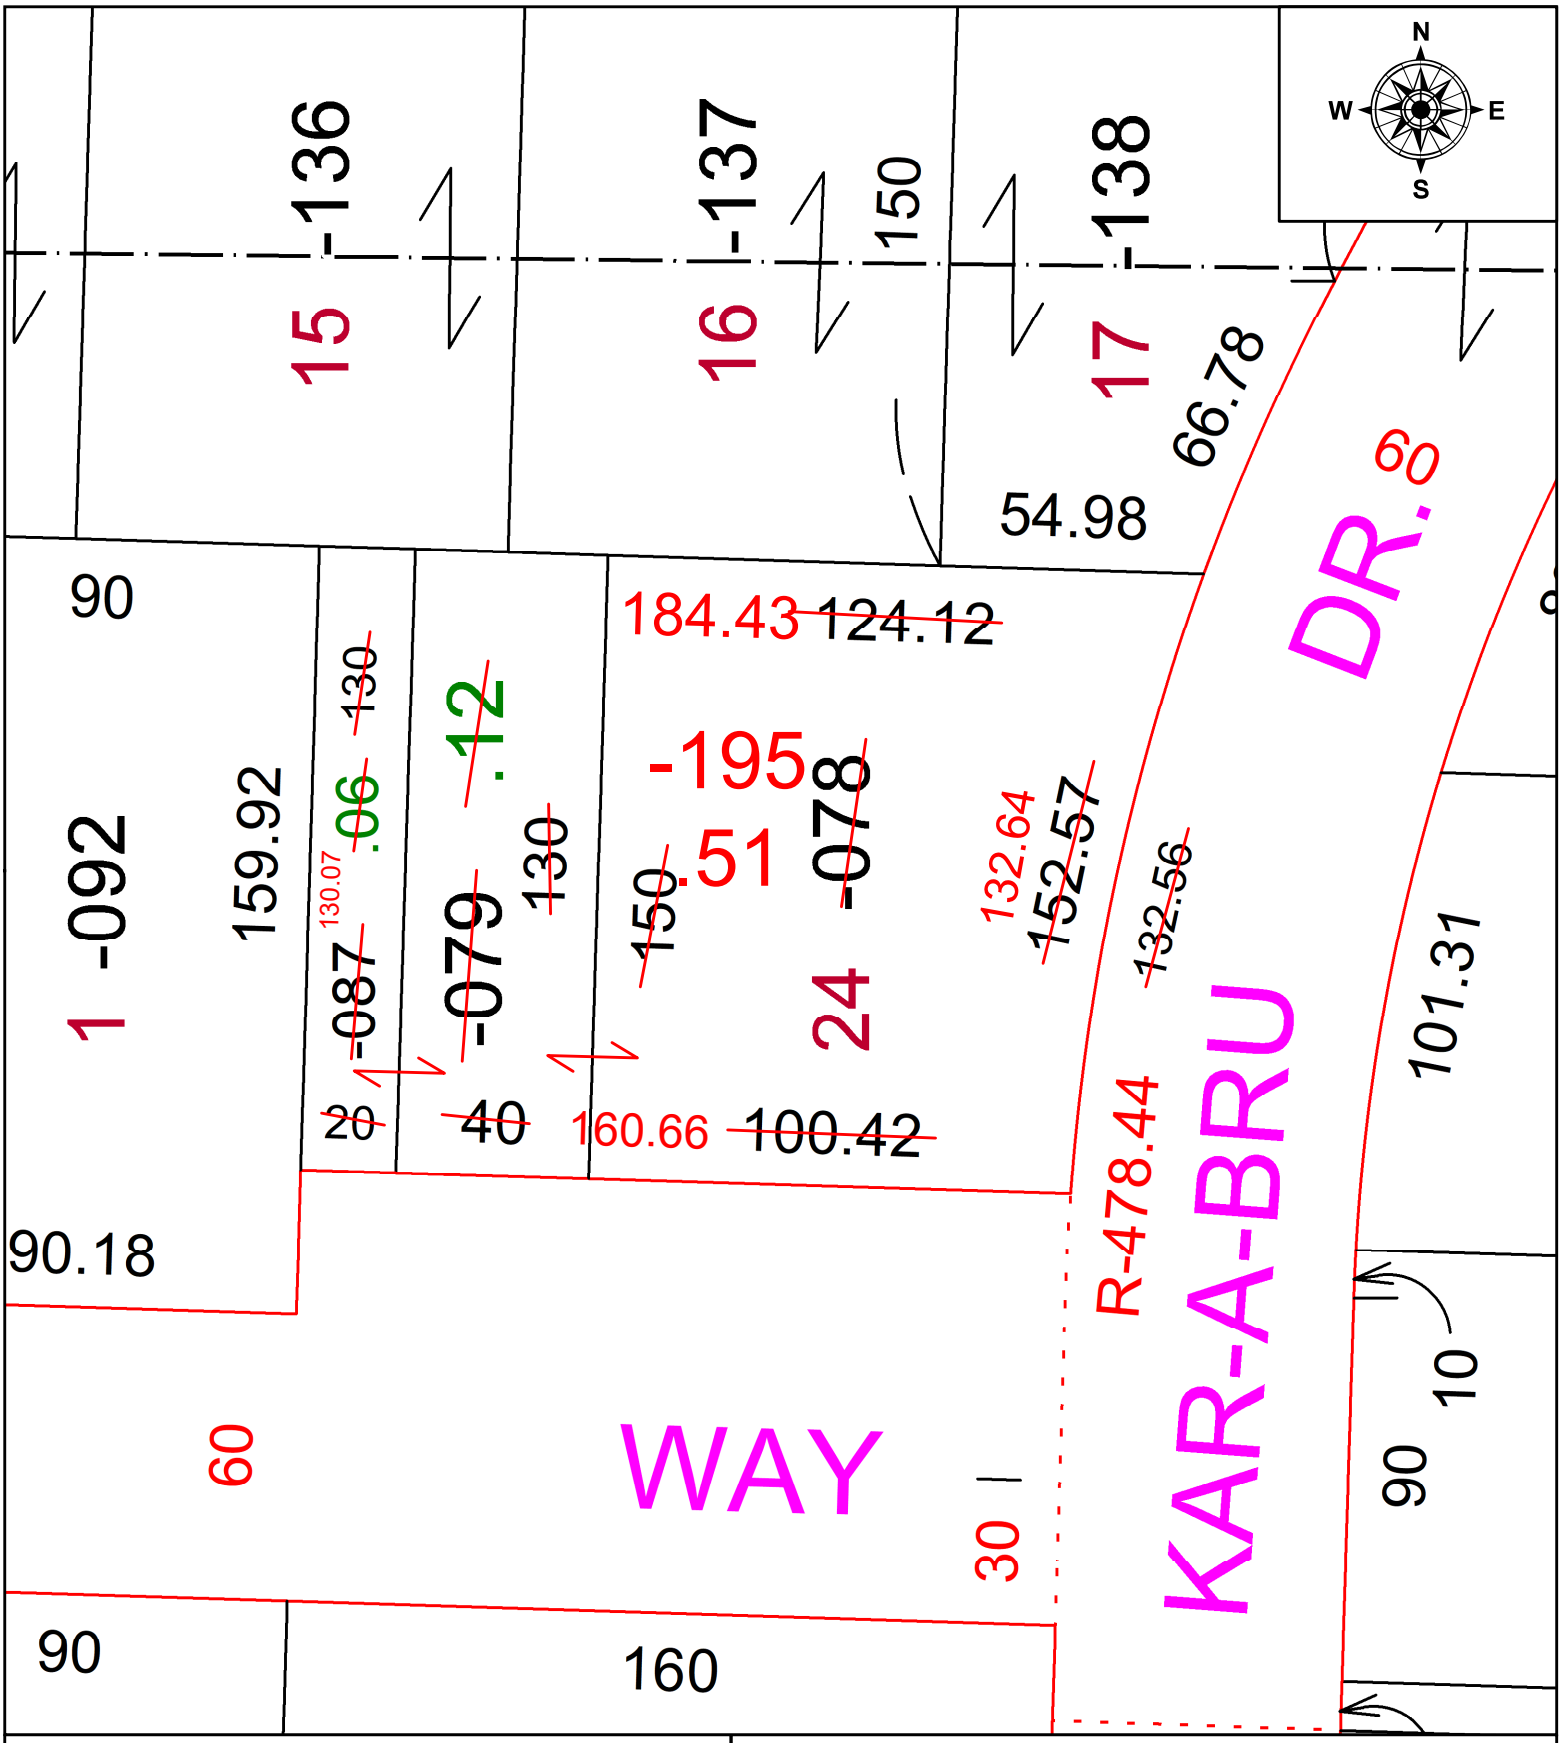

SPLITS/DEEDS PROCESSED

LORAIN COUNTY TAX MAP DEPARTMENT
226 MIDDLE AVE. ELYRIA, OH

SURVEYED BY: THOMAS SIMON **SURVEY #:** 51010
CLOSURE: 1:92287
MAP PAGE(S): 06-25-003
APPOVED BY: DMA **DATE:** 9/12/2023
SCALE: 1" = 40' **PRIOR INSTRUMENT:** D.V. 1373 PG. 52