PARENT PARCEL: 18-00-031-000-007

CHILD PARCEL: 18-00-031-000-060 & -061

STARTING POINT: AC CORR PER SURV BY THOMAS A. SIMON

23-04751

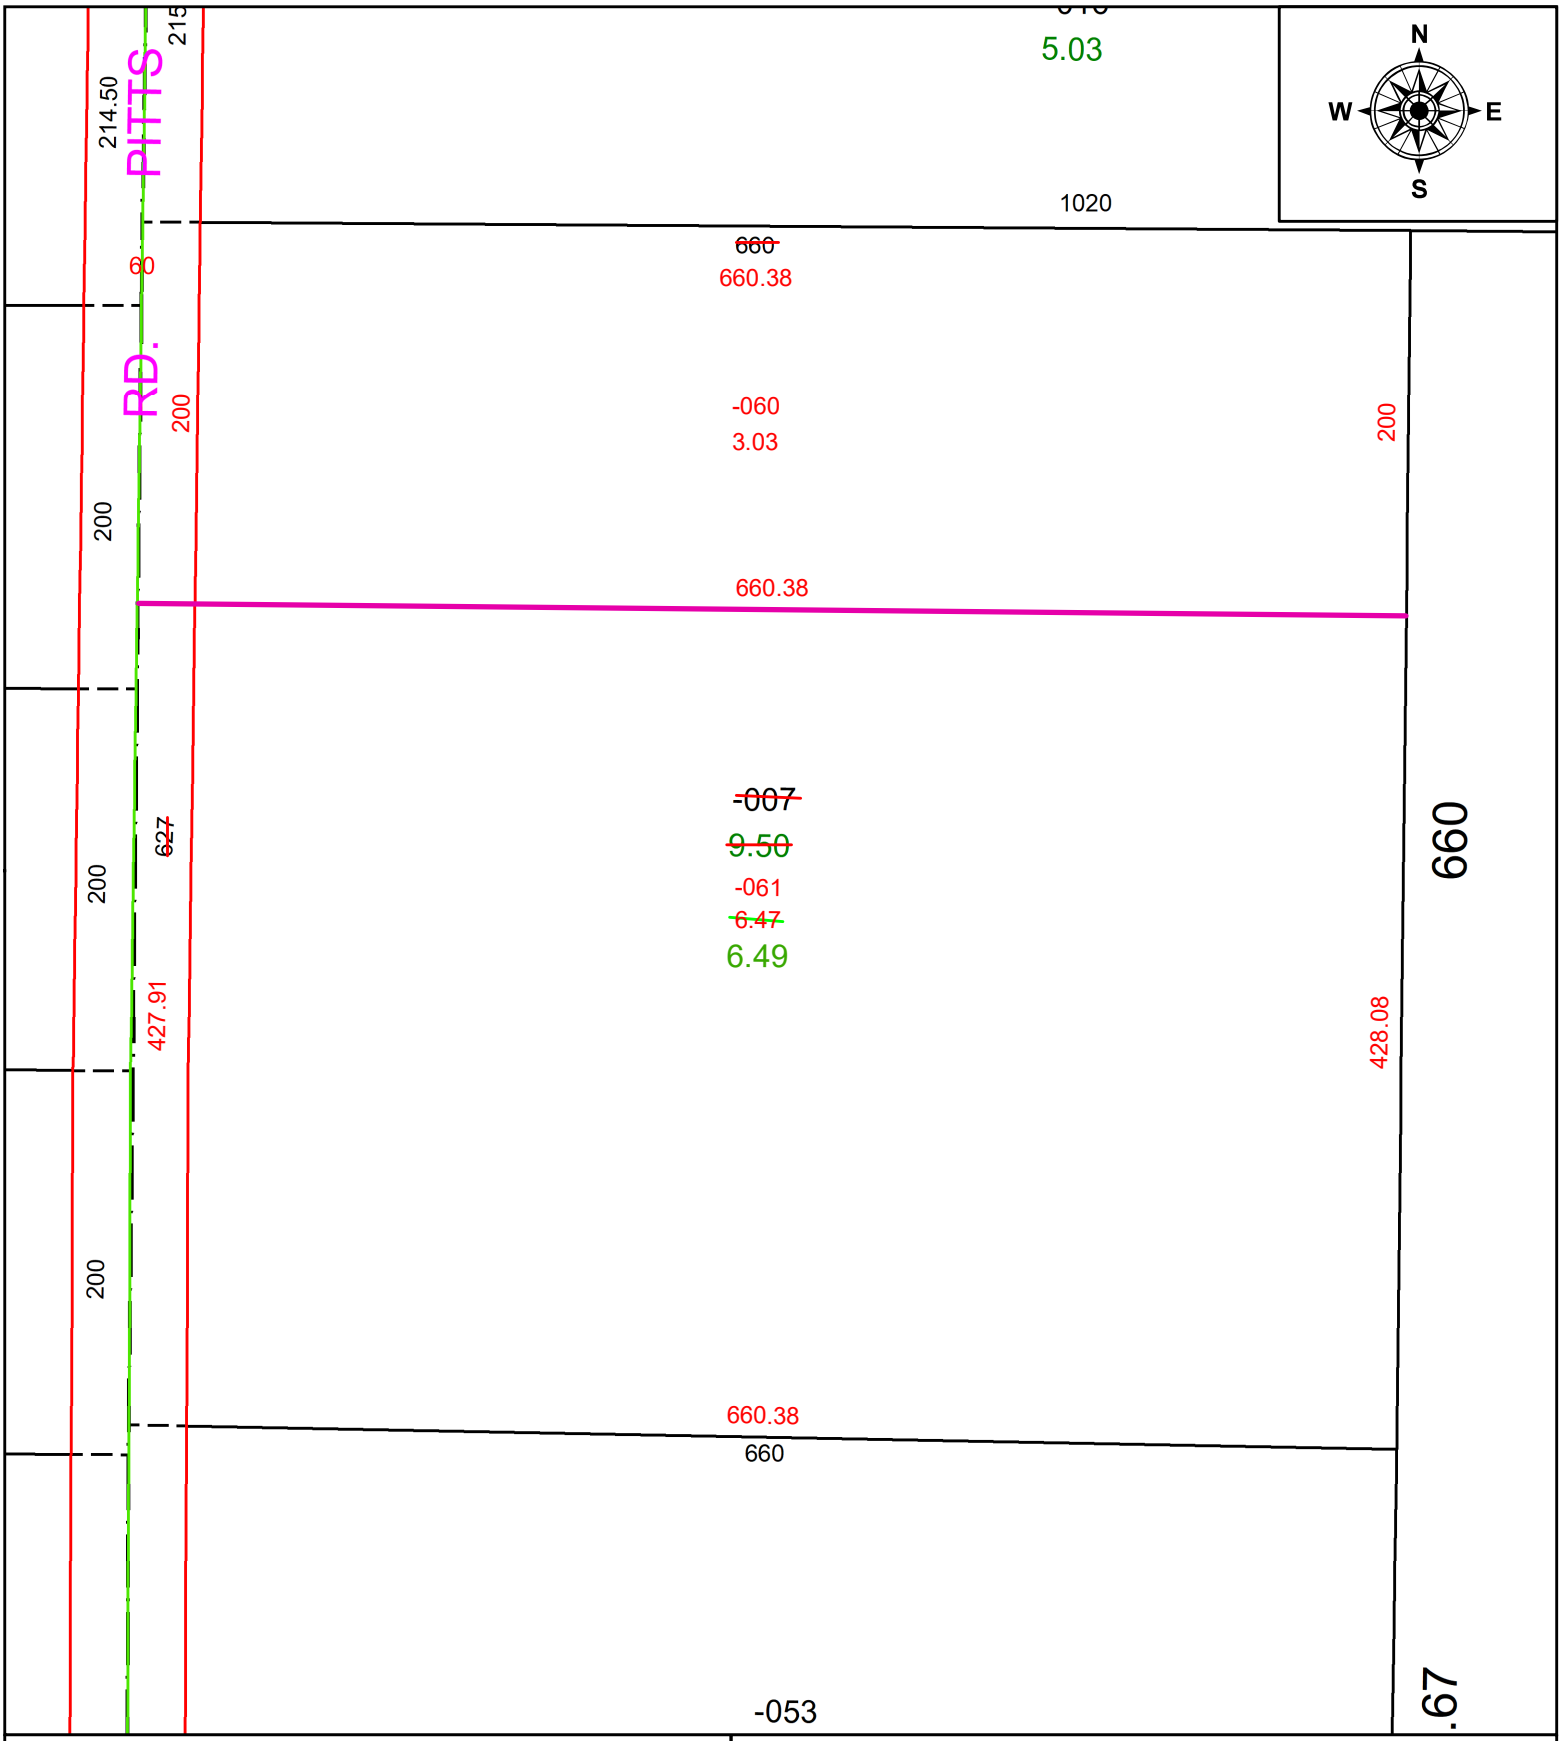

SPLITS/DEEDS PROCESSED

LORAIN COUNTY TAX MAP DEPARTMENT
226 MIDDLE AVE. ELYRIA, OH

SURVEYED BY: THOMAS A. SIMON **SURV # 51015**

CLOSURE: 1: 2147483648

MAP PAGE(S): 18-00-031

APPOVED BY: AC **DATE:** September 20, 2023

SCALE: 1 in = 100 ft **PRIOR INSTRUMENT:** 2021- 0853109