PARENT PARCEL: 19-05-016-000-008, 19-05-017-000-010

CHILD PARCEL: AC CORR PER SURV BY LOUIS J. GIFFELS

STARTING POINT: NW CORNER OF LOT 17, TRACT 5

21-04753-D

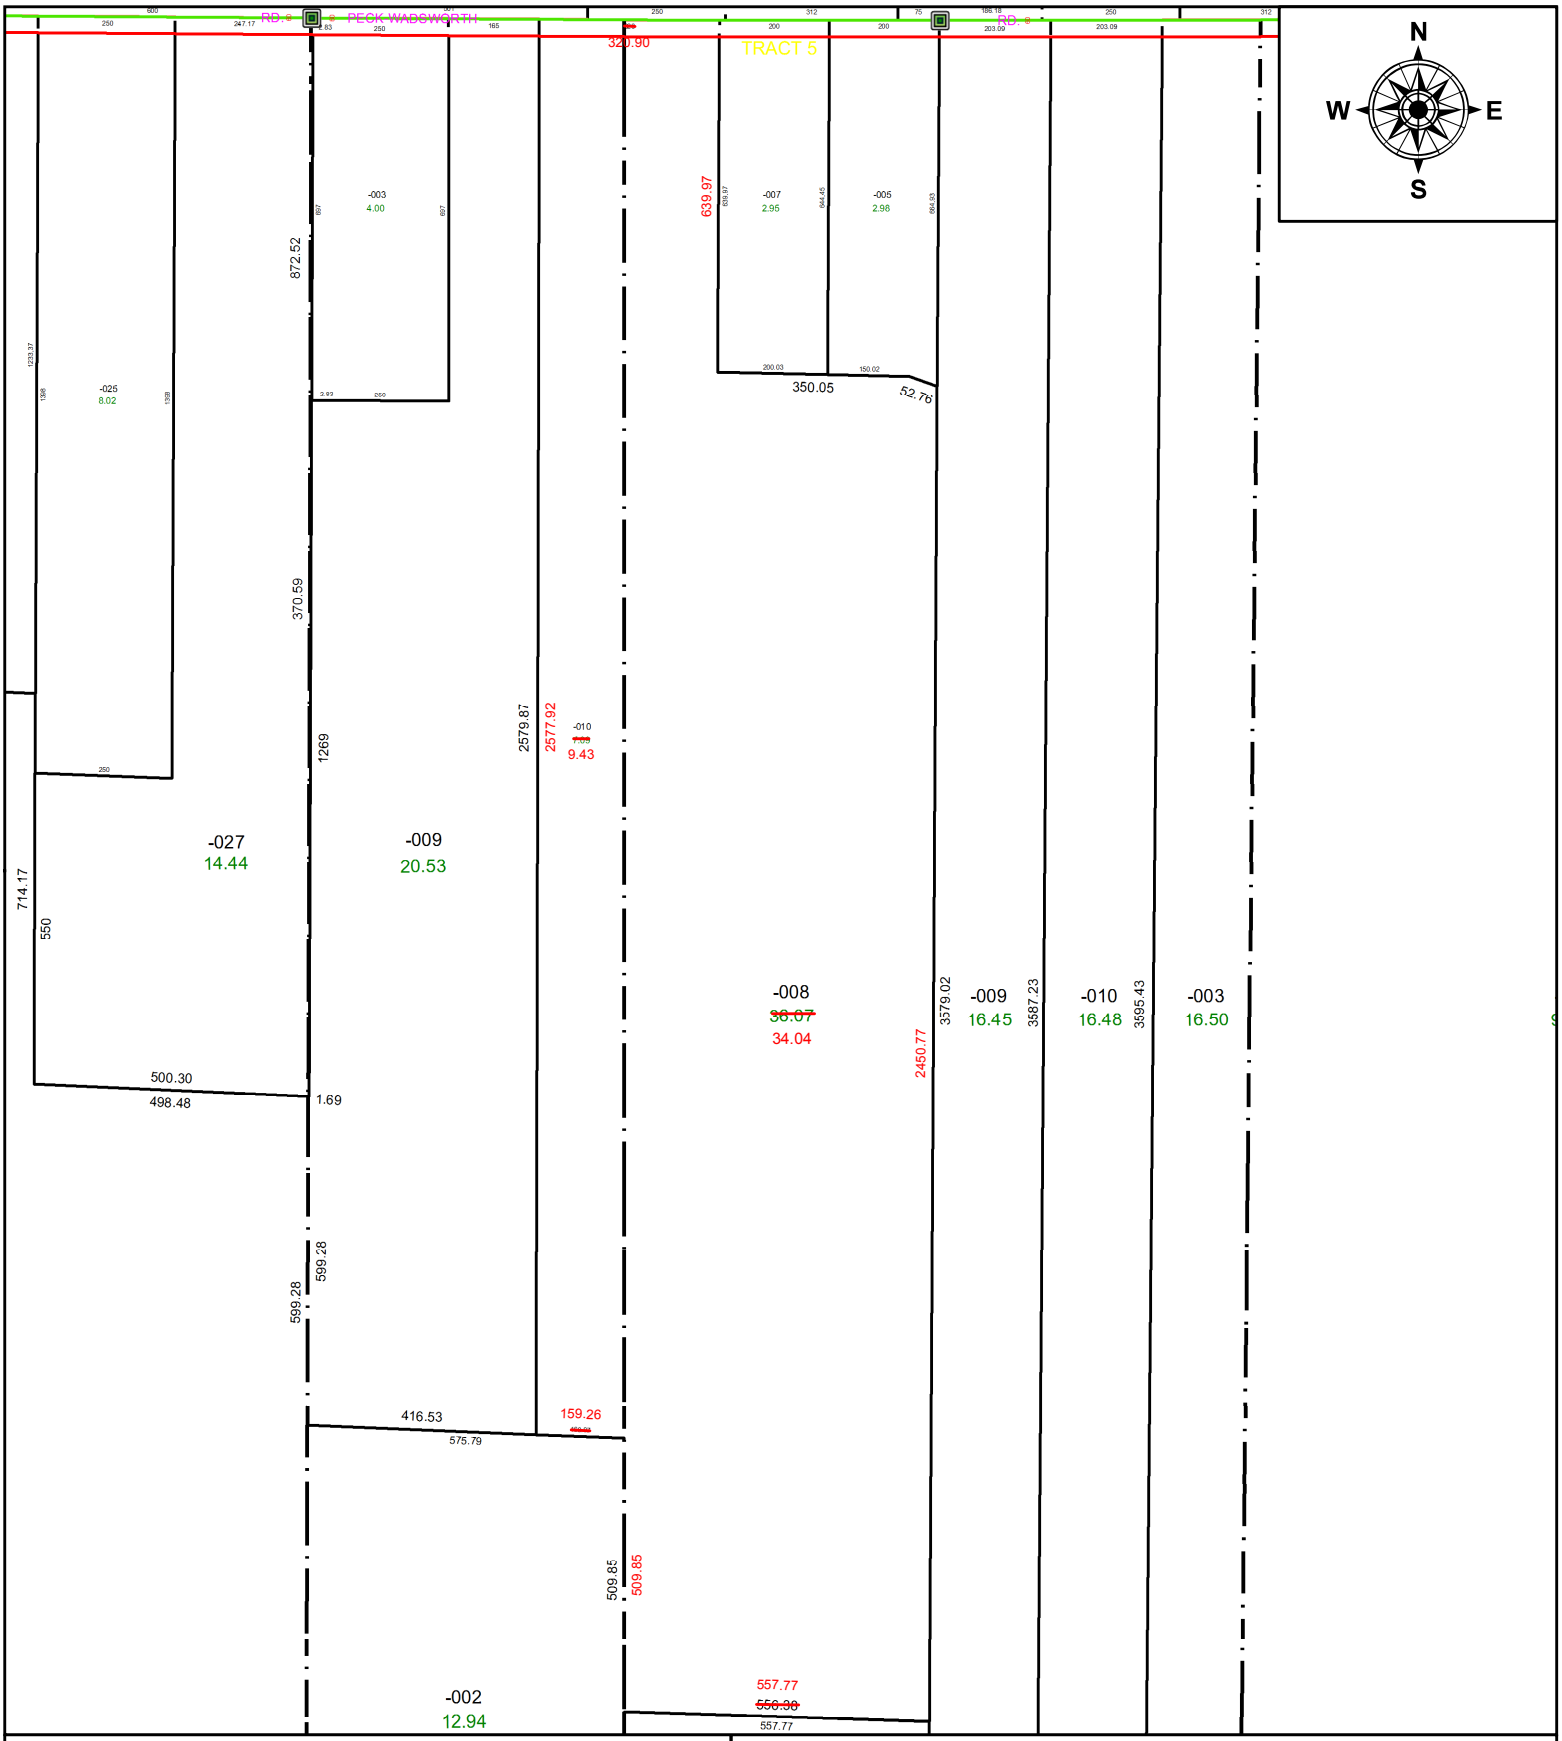

SPLITS/DEEDS PROCESSED

LORAIN COUNTY TAX MAP DEPARTMENT
226 MIDDLE AVE. ELYRIA, OH

SURVEYED BY: LOUIS J. GIFFELS
CLOSURE: 1: 36259
MAP PAGE(S): 19-05-016-A
APPOVED BY: AC **DATE:** 12/21/2021
SCALE: 1" = 50 **PRIOR INSTRUMENT:** 2015- 0551103