PARENT PARCEL: 05-00-052-000-024, -054, & 05-00-069-000-003(S.T.)

CHILD PARCEL: AC CORR PER SURVEYOR THEODORE SPILLMAN

STARTING POINT: MONUMENT BOX @ INTERSECTION OF C/L OBERLIN RD & SOUTH LINE OF O.L. 52

23-04753

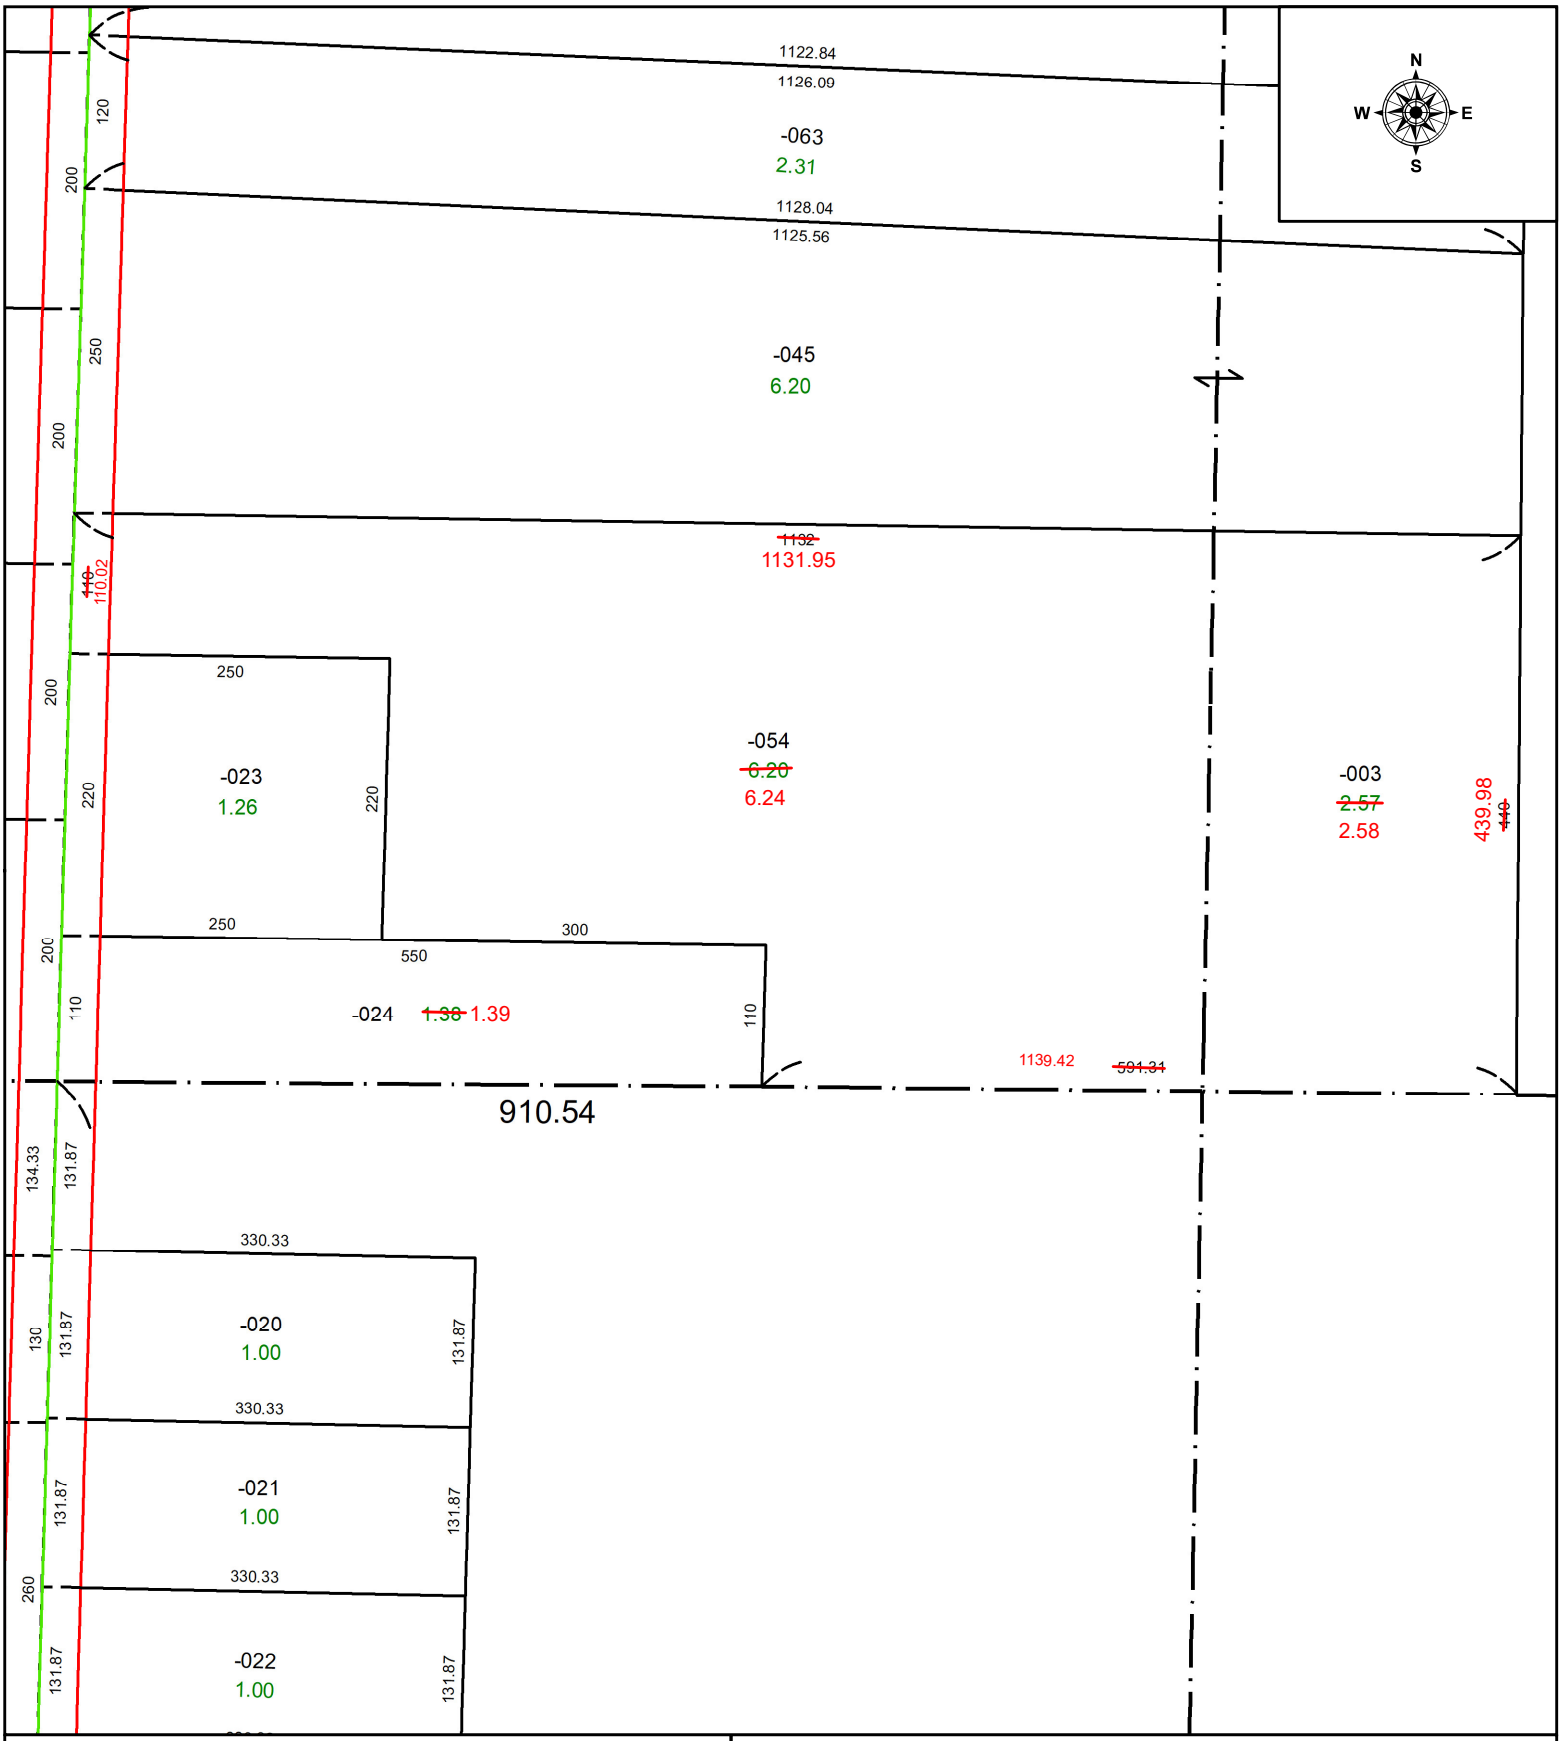

SPLITS/DEEDS PROCESSED

LORAIN COUNTY TAX MAP DEPARTMENT
226 MIDDLE AVE. ELYRIA, OH

SURVEYED BY: THEODORE SPILLMAN — SURVEY # 51018

CLOSURE: 1: 324662

MAP PAGE(S): 05-00-052 & 05-00-069

APPOVED BY: WRZ **DATE:** 9/29/2023

SCALE: 1" = 150 **PRIOR INSTRUMENT:** #2008-0263428