PARENT PARCEL: 03-00-024-000-038, -068, & -075

CHILD PARCEL: 03-00-024-000-089

STARTING POINT: IRON PIN FOUND @ C/LS OF HARRIS RD & OSTER RD

23-04754

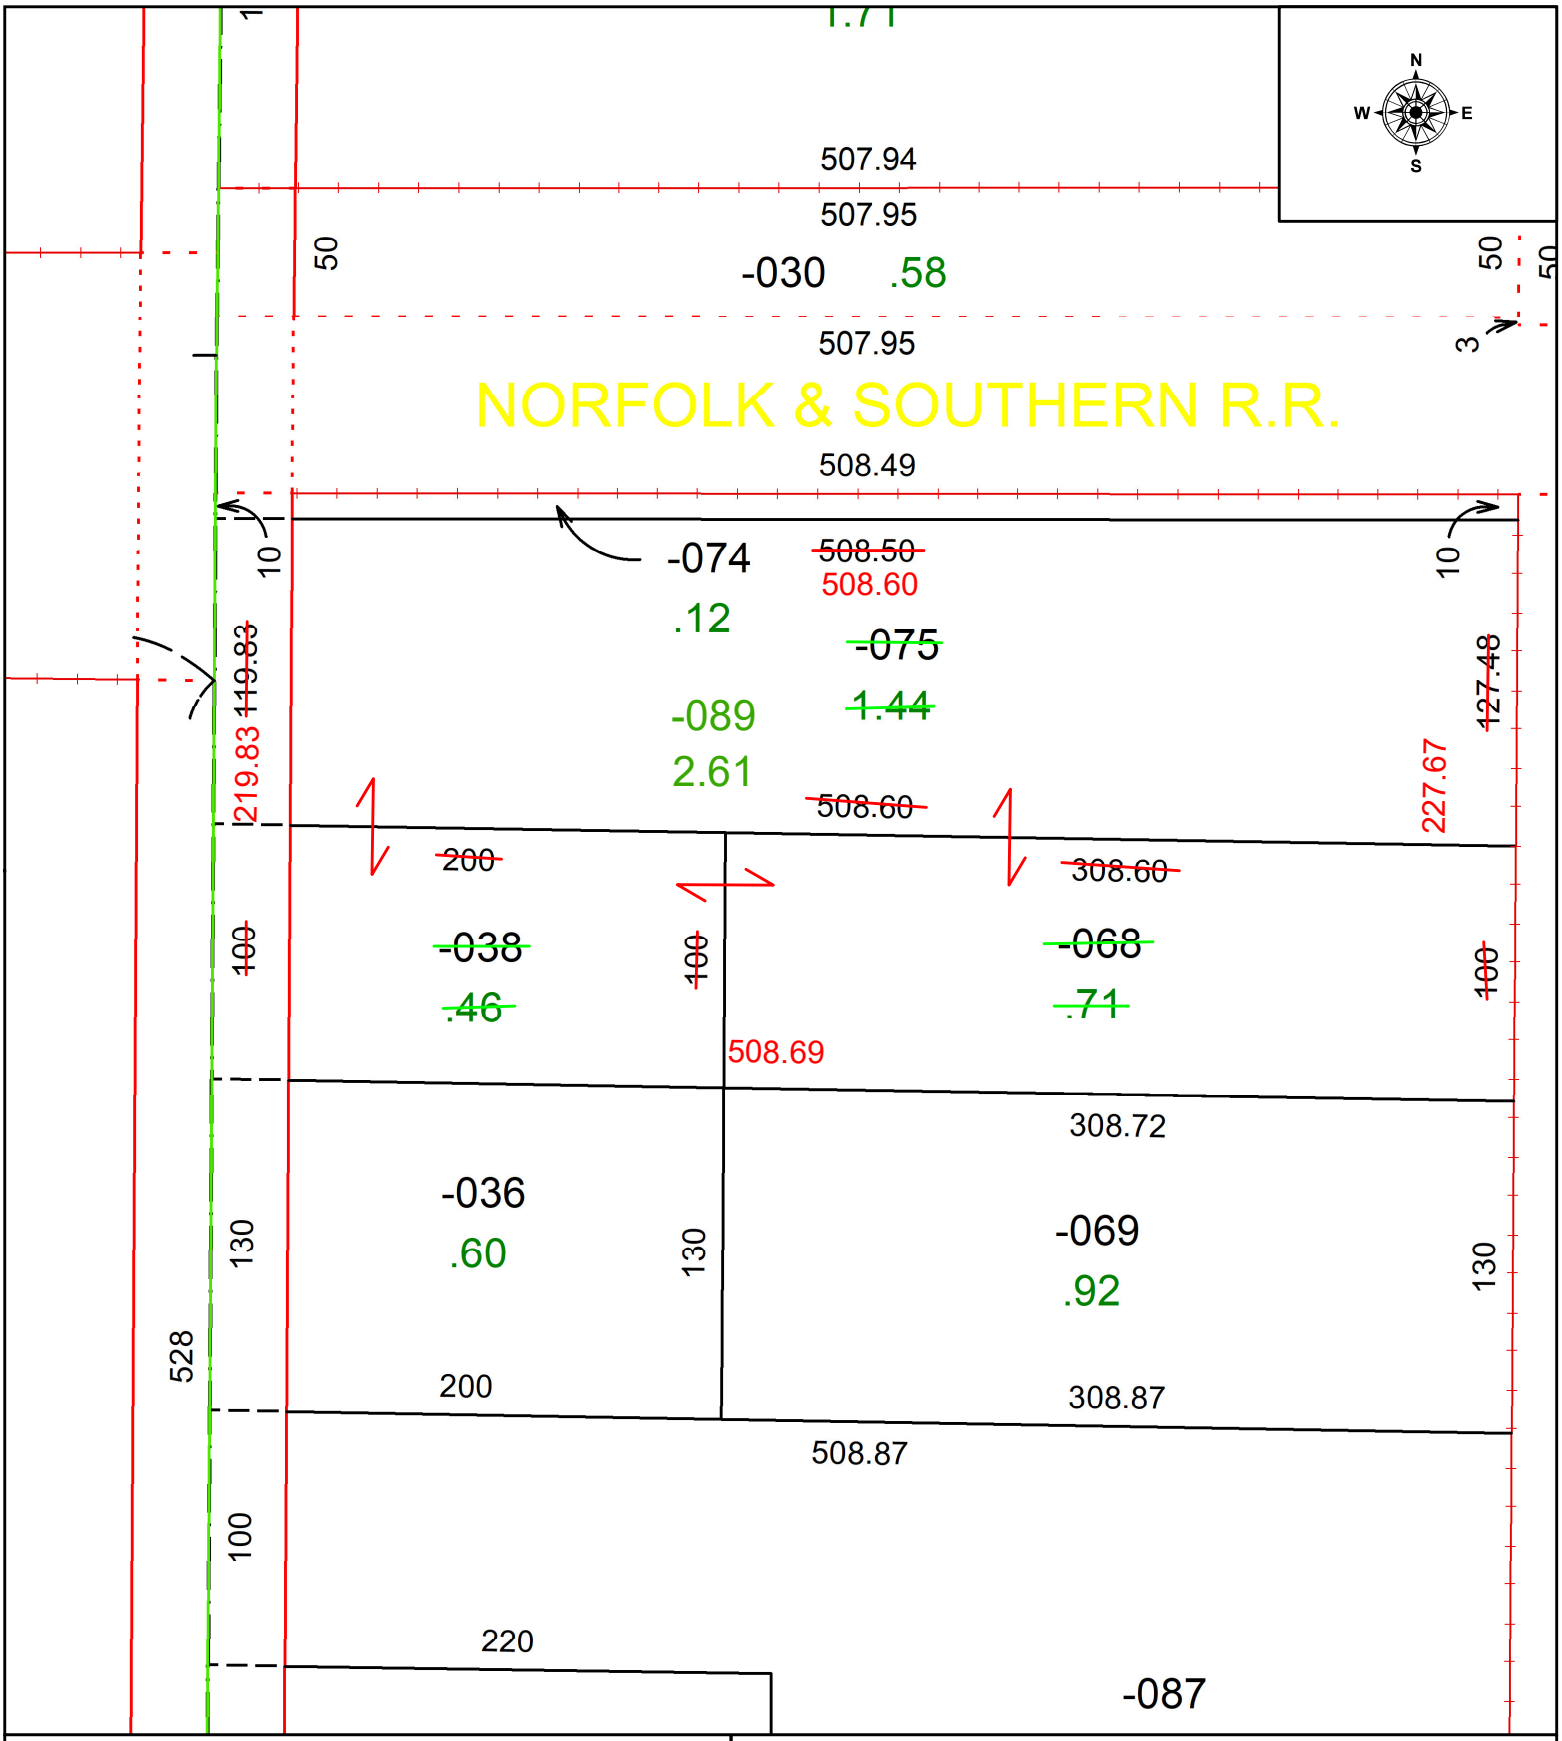

SPLITS/DEEDS PROCESSED

LORAIN COUNTY TAX MAP DEPARTMENT
226 MIDDLE AVE. ELYRIA, OH

SURVEYED BY: PATRICK MCGANNON SURVEY # 51019

CLOSURE: 1: 296367

MAP PAGE(S): 03-00-024

APPOVED BY: WRZ **DATE:** 10/2/2023

SCALE: 1" = 75 **PRIOR INSTRUMENT:** #2011-0385489