PARENT PARCEL: 05-00-071-000-069 & 05-00-090-000-016 (S.T.)

CHILD PARCEL: 05-00-071-000-070, -071, -072, -073

STARTING POINT: INTERSECTION OF THE CENTER-LINES OF BECHTEL AND ALBRECHT ROAD

23-04757

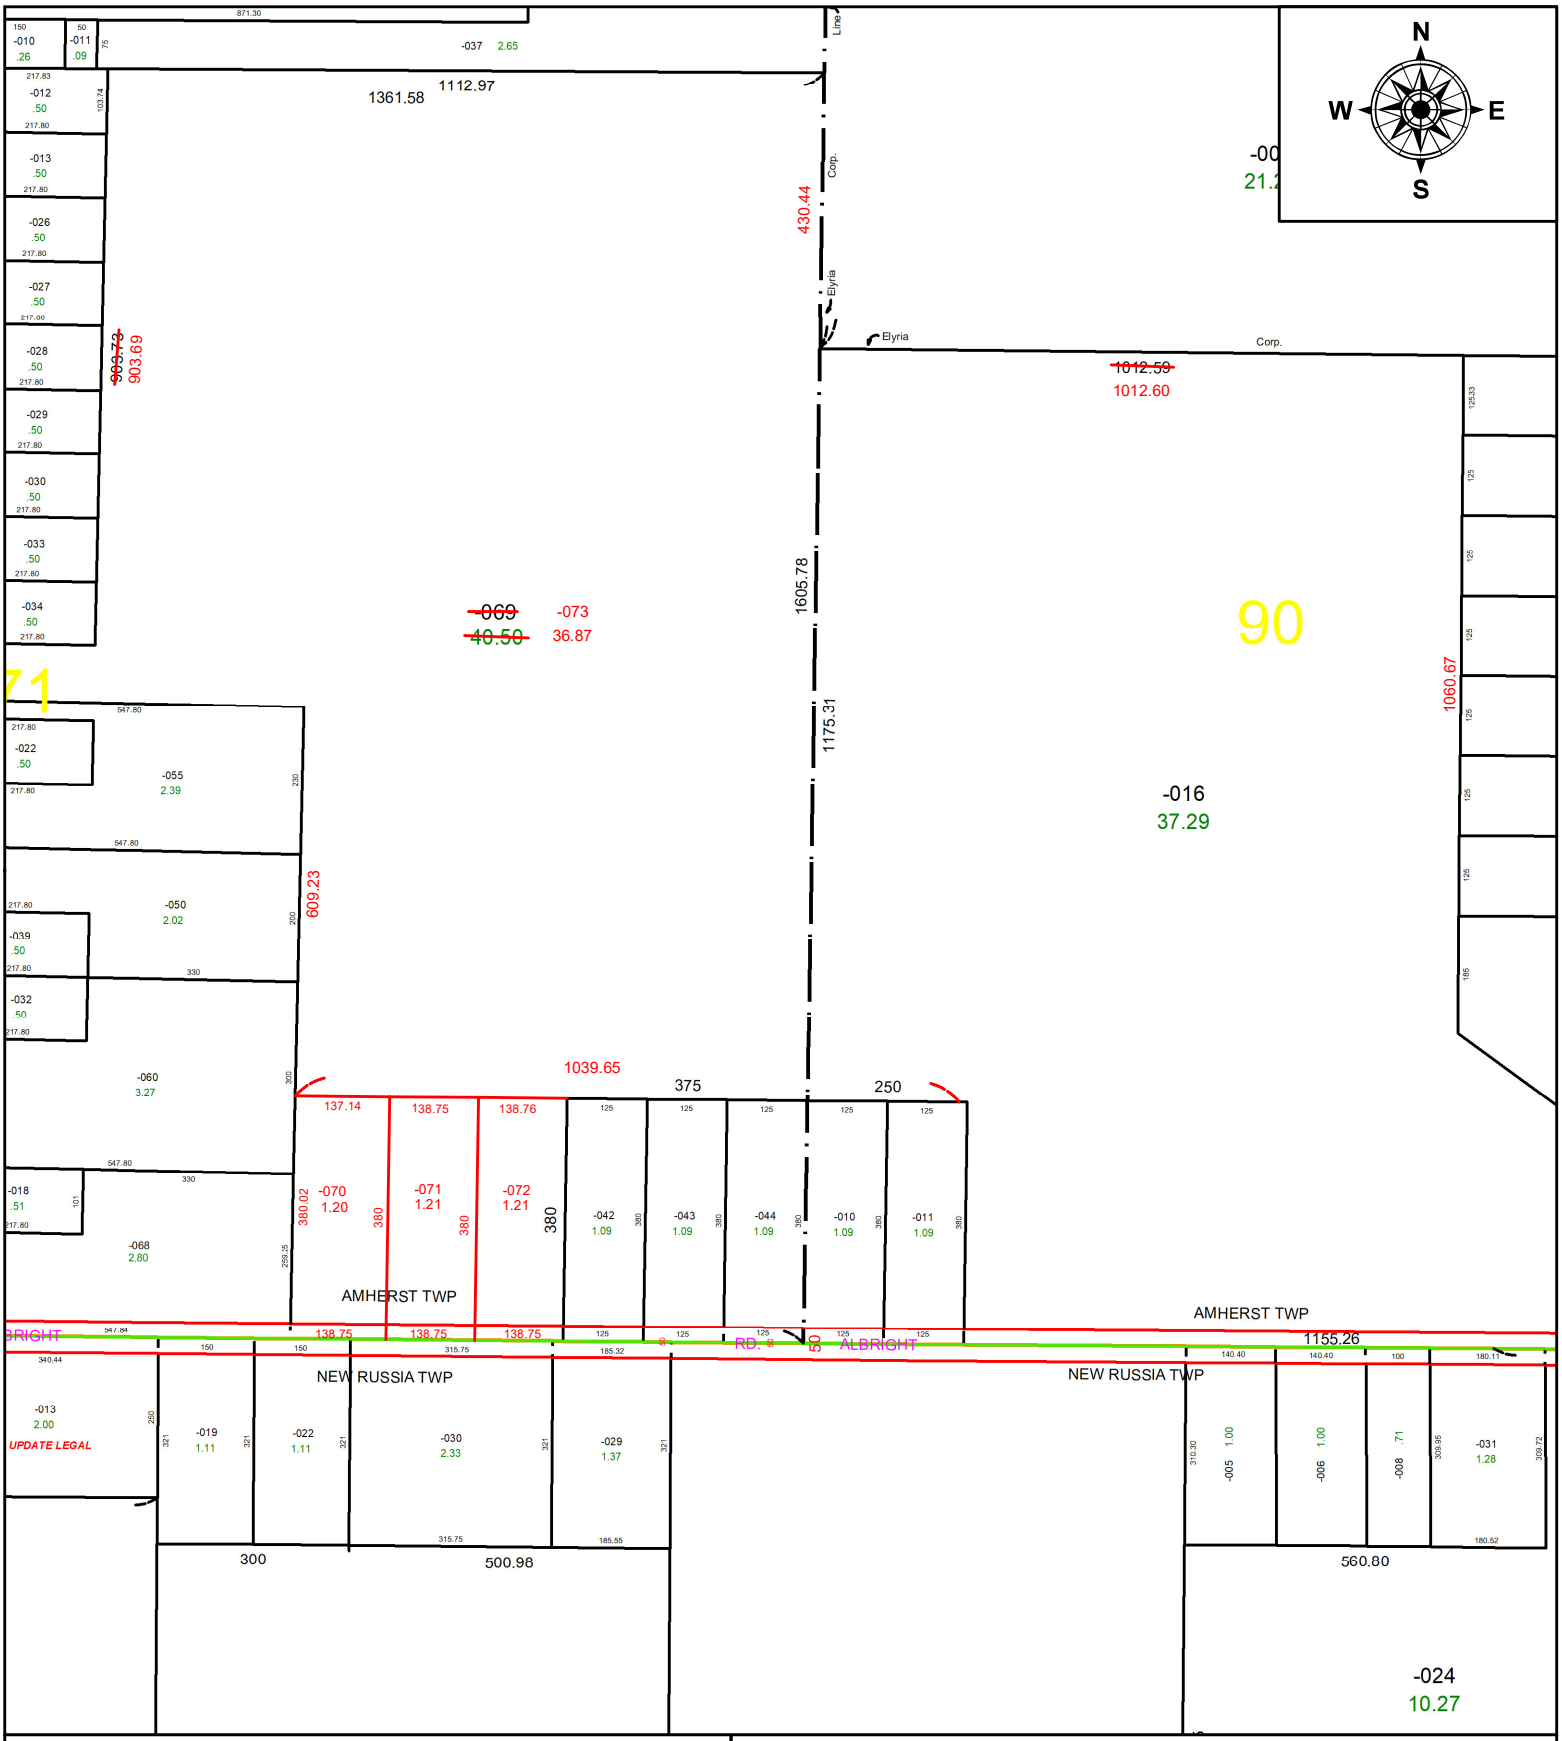

SPLITS/DEEDS PROCESSED

LORAIN COUNTY TAX MAP DEPARTMENT
226 MIDDLE AVE. ELYRIA, OH

SURVEYED BY: THOMAS A. SIMON **SURVEY #:** 51023

CLOSURE: 1: 135,395

MAP PAGE(S): 05-00-071

APPOVED BY: SP **DATE:** 10/5/2023

SCALE: 1" = 150' **PRIOR INSTRUMENT:** 2007-0189435