PARENT PARCEL: 01-00-010-000-006

CHILD PARCEL: AC. CORR. PER PRIOR SURVEY ROGER SIMON

STARTING POINT: CL OF BAUMHART RD. & TERMINAL DR.

22-04762-A

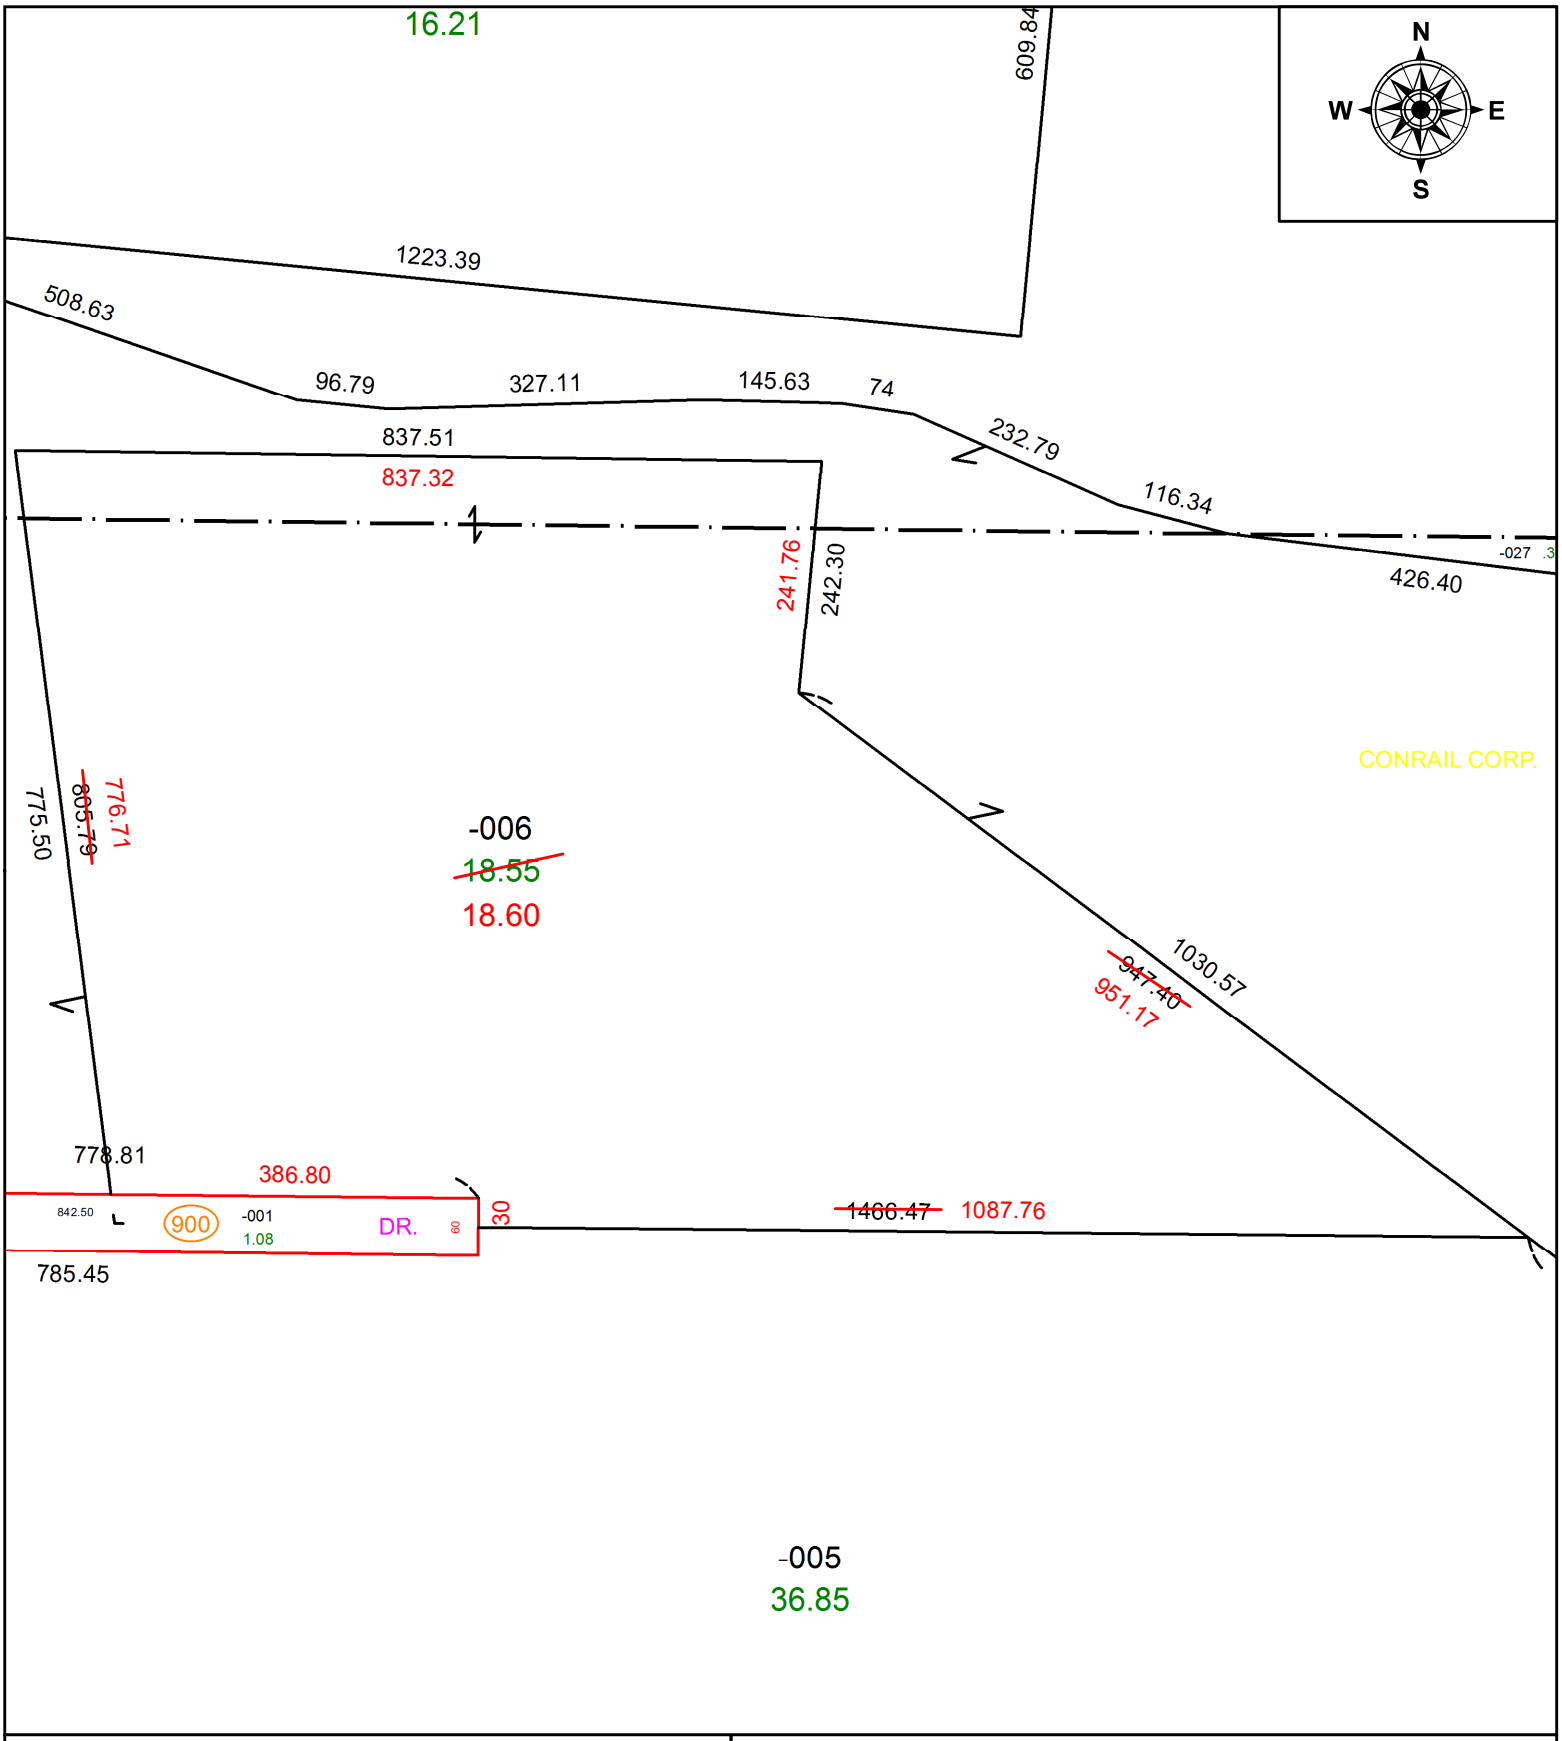

SPLITS/DEEDS PROCESSED

LORAIN COUNTY TAX MAP DEPARTMENT
226 MIDDLE AVE. ELYRIA, OH

SURVEYED BY: ROGER SIMON
CLOSURE: 1: 666,640
MAP PAGE(S): 01-00-010
APPOVED BY: DMA **DATE:** 1/5/2022
SCALE: 1" = 200' **PRIOR INSTRUMENT:** 2016-0581377