PARENT PARCEL: 18-00-025-000-003

CHILD PARCEL: 18-00-025-000-016 & -017

STARTING POINT: STONE W/ CROSS MONUMENT @ SOUTHWEST CORNER OF O.L. 25

23-04762

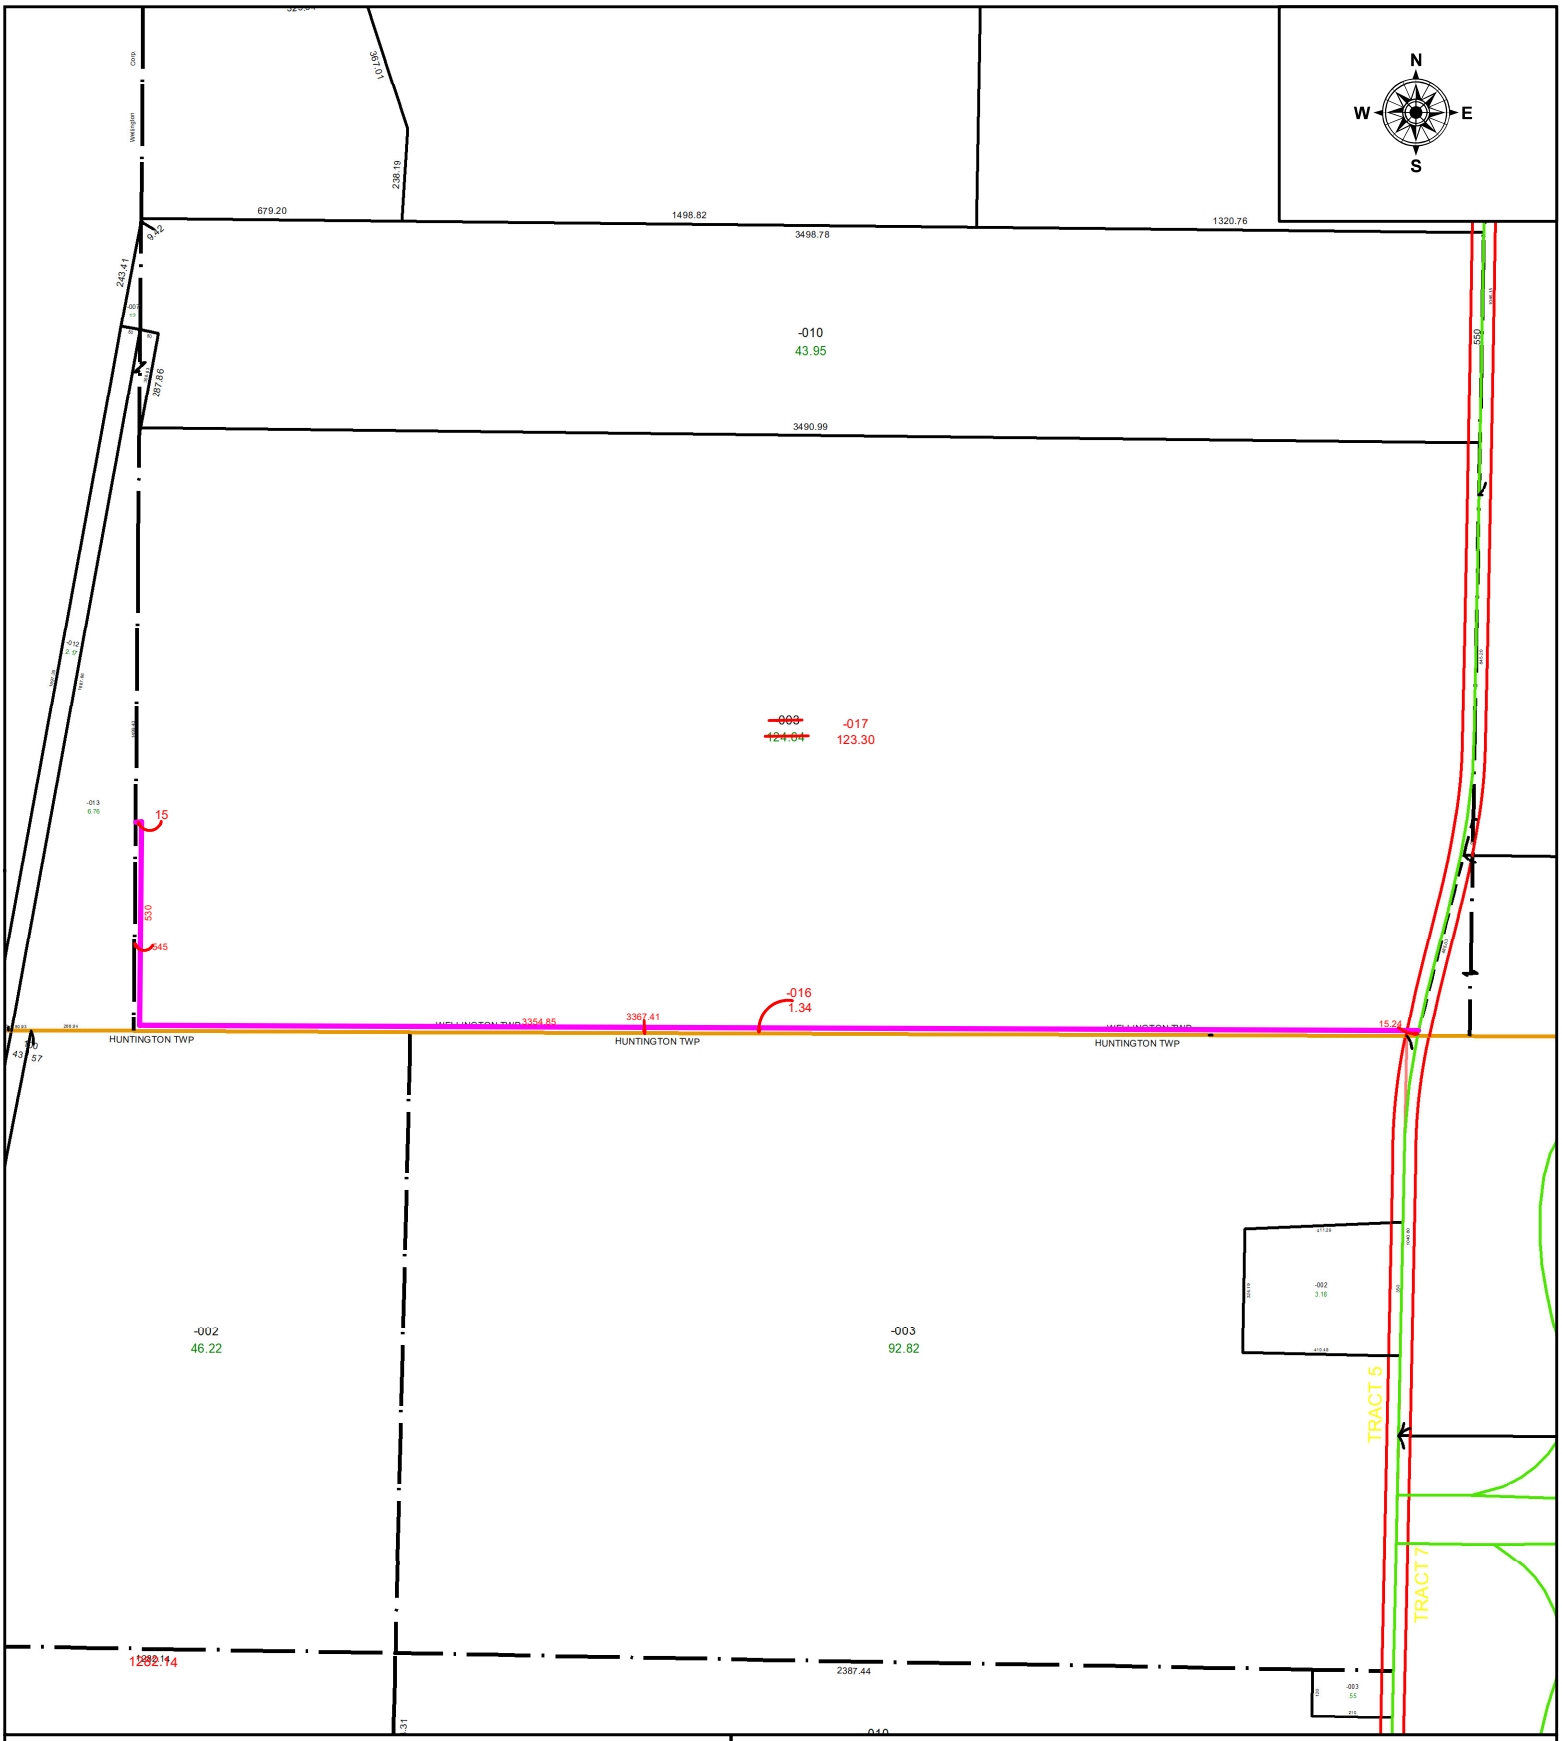

SPLITS/DEEDS PROCESSED

LORAIN COUNTY TAX MAP DEPARTMENT
226 MIDDLE AVE. ELYRIA, OH

SURVEYED BY: ANDREW PLANET SURVEY #51029

CLOSURE: 1: 1500406

MAP PAGE(S): 18-00-025

APPOVED BY: WRZ **DATE:** 10/19/2023

SCALE: 1" = 500 **PRIOR INSTRUMENT:** #2021-0815054