PARENT PARCEL: 06-24-073-000-009, 06-24-082-000-004, & -005

CHILD PARCEL: 06-24-073-000-014 & 06-24-082-000-007

STARTING POINT: COMBINATION PER SURV BY JOHN A. DECHANT JR.

23-04764

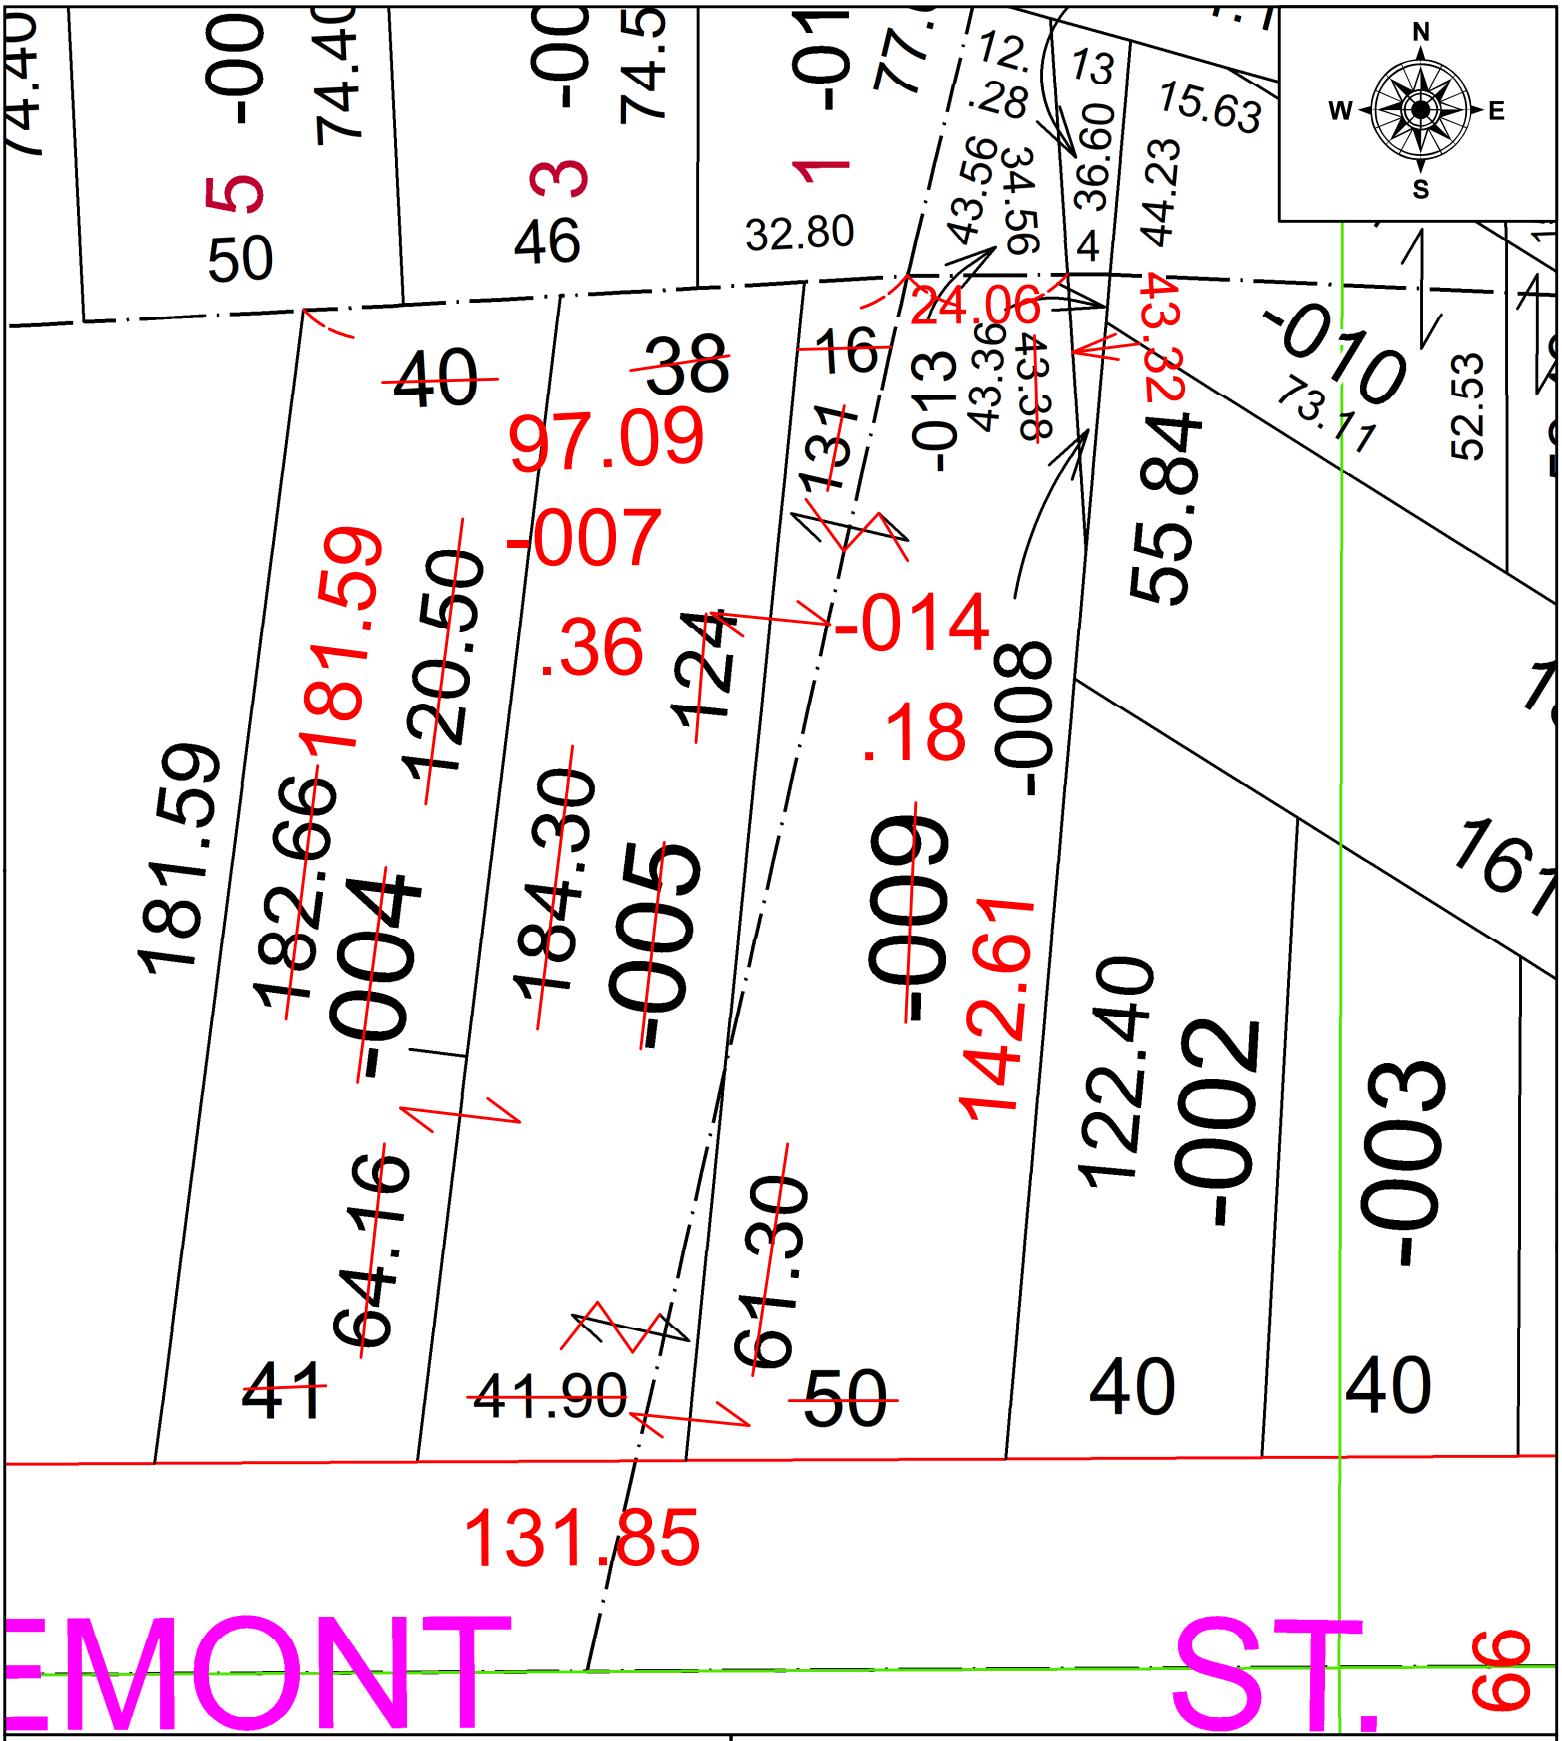

SPLITS/DEEDS PROCESSED

LORAIN COUNTY TAX MAP DEPARTMENT
226 MIDDLE AVE. ELYRIA, OH

SURVEYED BY: JOHN A. DECHANT JR. **SURV # 51030**

CLOSURE: 1: 70659

MAP PAGE(S): 06-22-073, -082

APPOVED BY: AC **DATE:** October 19, 2023

SCALE: 1 in = 30 ft **PRIOR INSTRUMENT:** 2022- 0890353