PARENT PARCEL: 06-24-107-000-011

CHILD PARCEL: 06-24-107-000-012 & -013

STARTING POINT: INTERSECTION POINT OF C/L OF WEST RIVER RD. & STATION 118+44.53 OF P.V. 30 PG. 78

23-04765

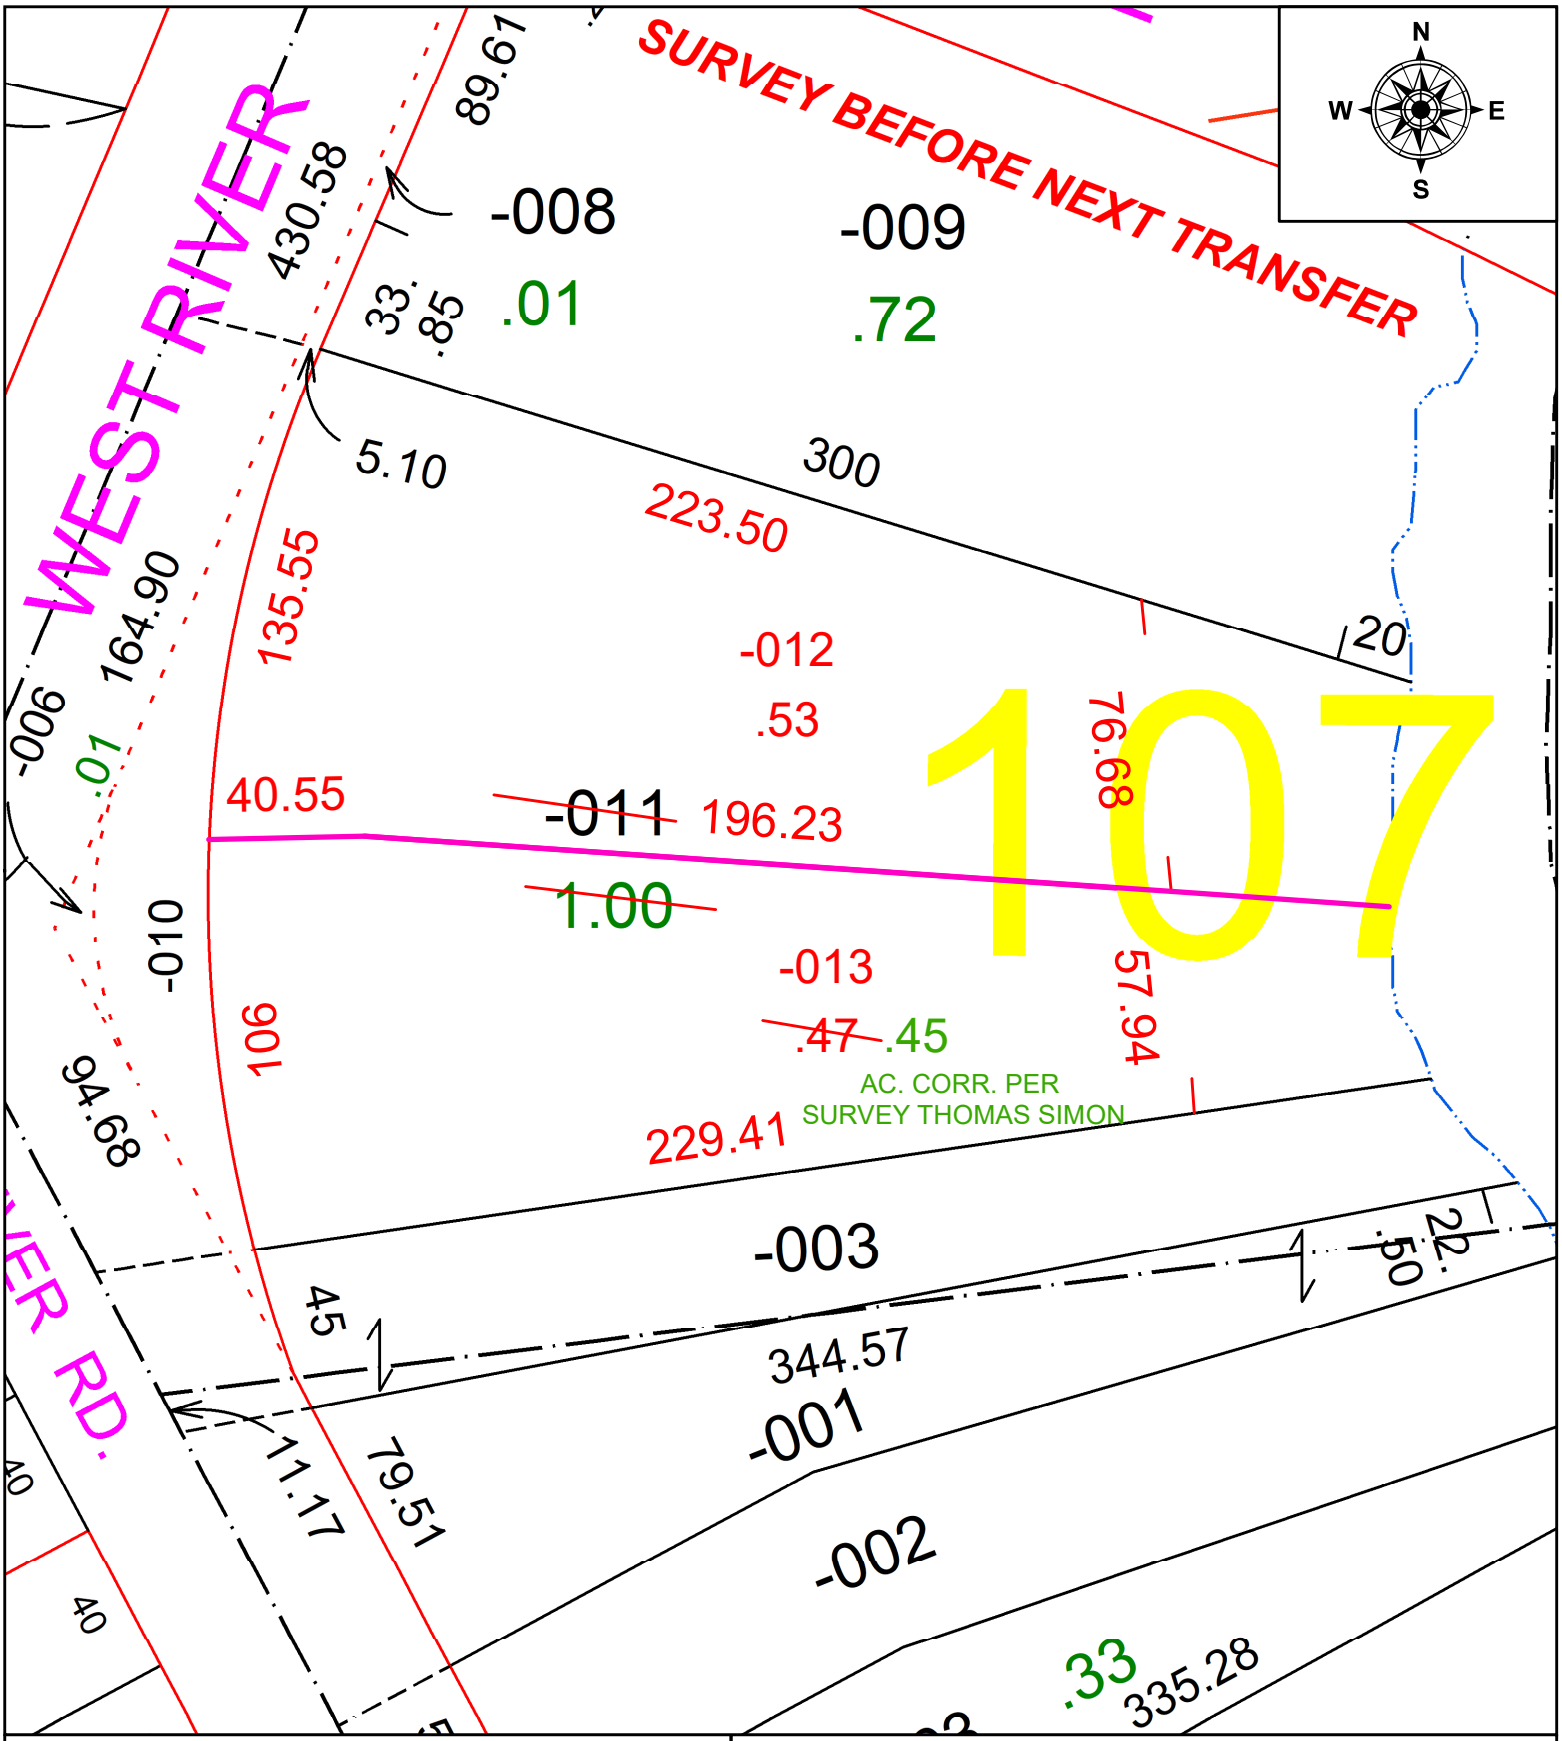

SPLITS/DEEDS PROCESSED

LORAIN COUNTY TAX MAP DEPARTMENT
226 MIDDLE AVE. ELYRIA, OH

SURVEYED BY: THOMAS SIMON **SURVEY #:** 51048

CLOSURE: 1:78345

MAP PAGE(S): 06-24-107

APPOVED BY: DMA **DATE:** 11/1/2023

SCALE: 1" = 50' **PRIOR INSTRUMENT:** 2016-0575569