PARENT PARCEL: 04-00-026-108-019

CHILD PARCEL: AC. CORR. PER PRIOR INSTRUMENT # 2009-0290014

STARTING POINT: CL OF SCHWARTZ RD. & EASTERLY LINE SECTION 26.

22-04772-A

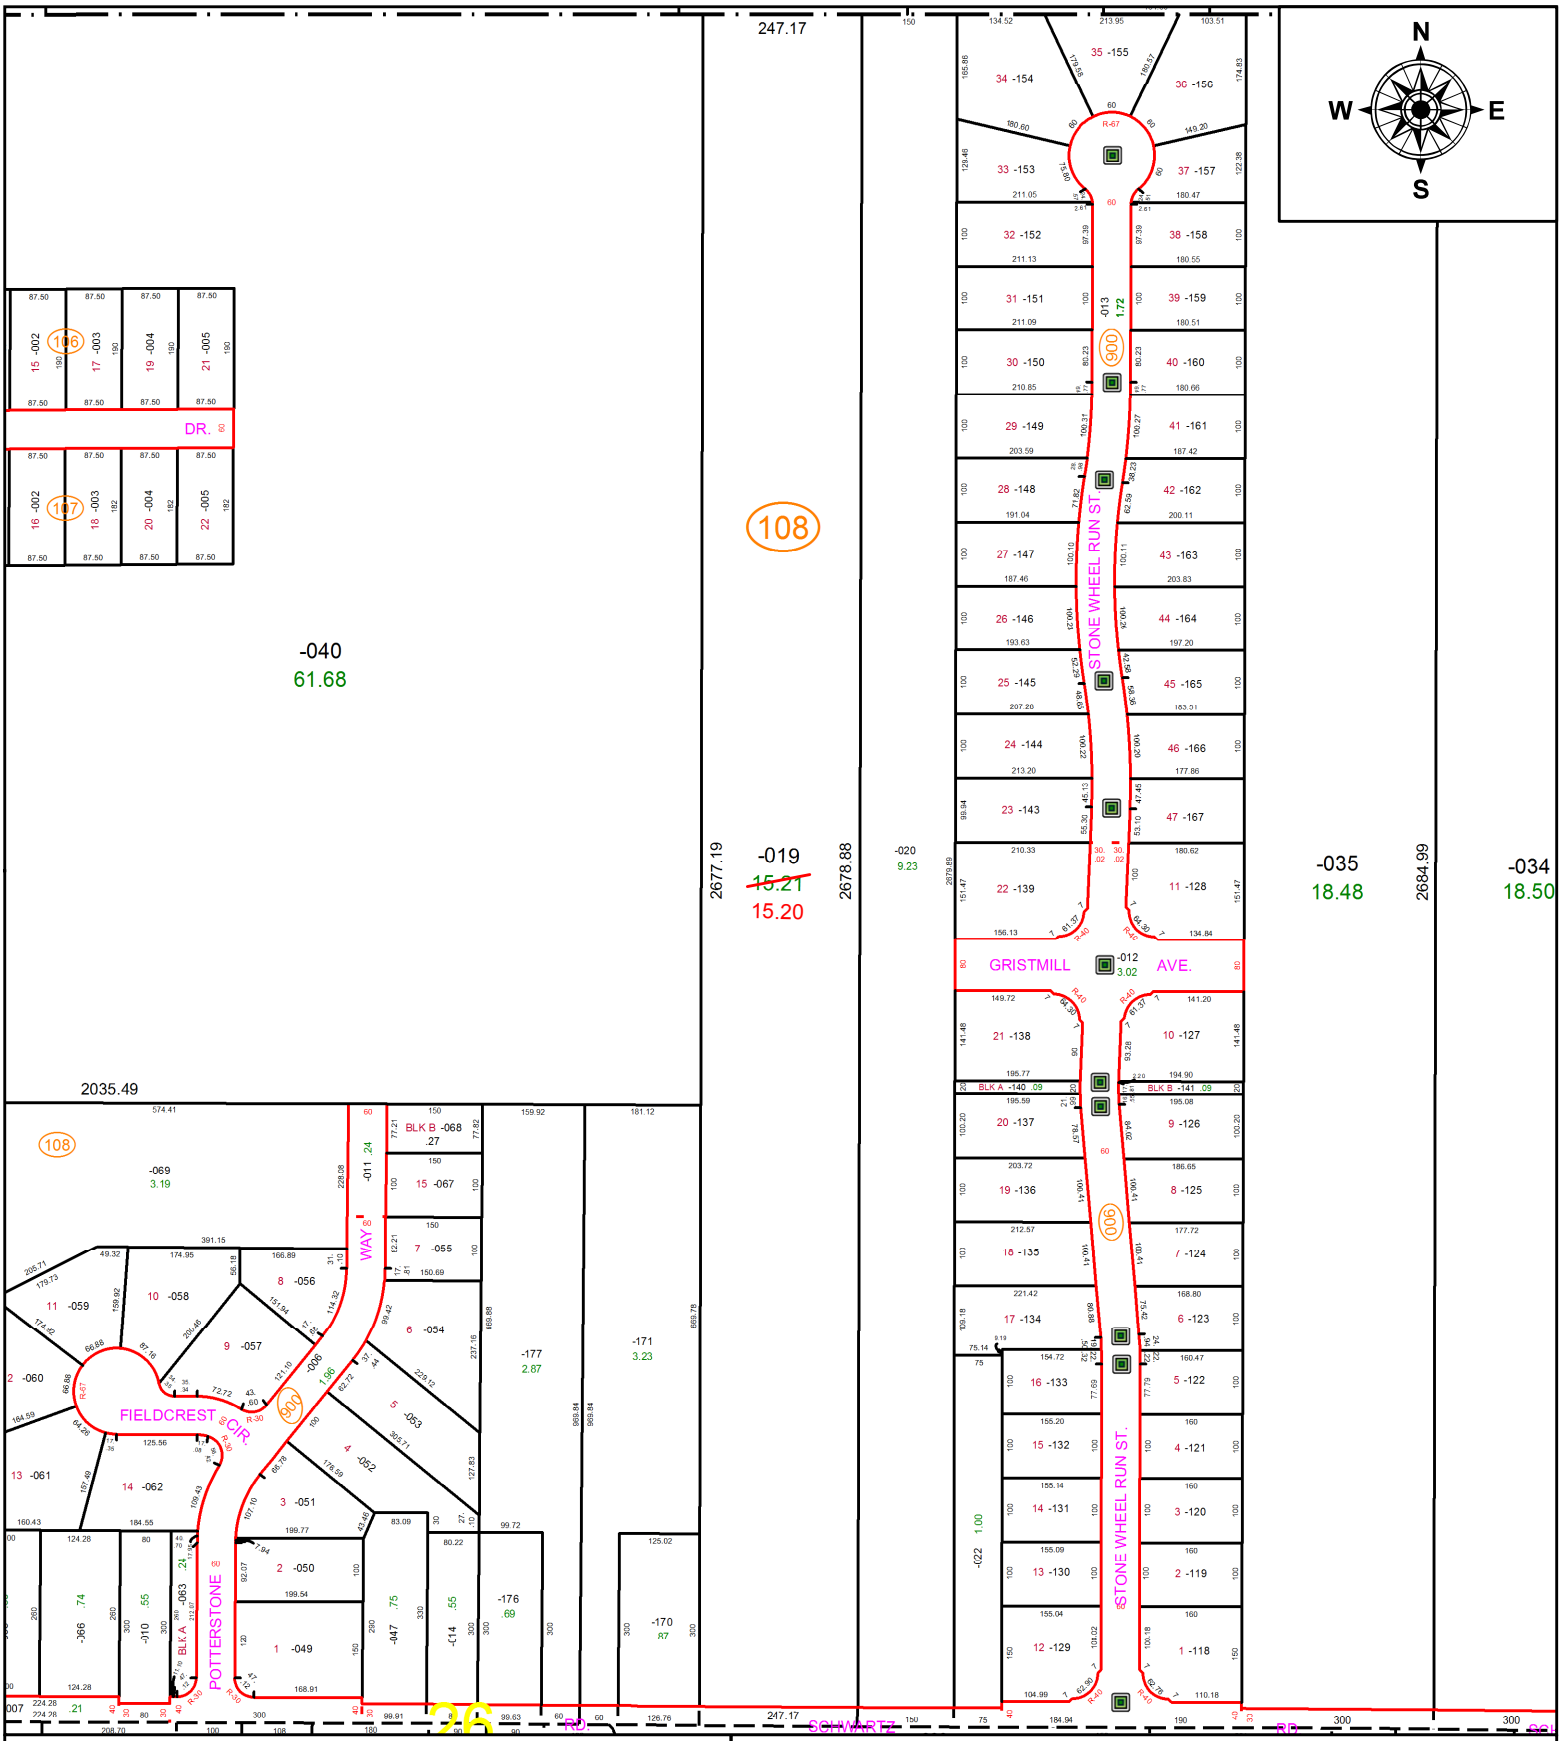

SPLITS/DEEDS PROCESSED

LORAIN COUNTY TAX MAP DEPARTMENT
226 MIDDLE AVE. ELYRIA, OH

SURVEYED BY: N/A
CLOSURE: 1: 657127
MAP PAGE(S): 04-00-026
APPOVED BY: DMA **DATE:** 1/18/2022
SCALE: 1" = 300' **PRIOR INSTRUMENT:** 2009-0290014