PARENT PARCEL: 08-00-102-000-006, ST: -007

CHILD PARCEL: 08-00-102-000-018, -019

STARTING POINT: AC CORR PER SURV BY BRENT D. ANDERSON

23-04772

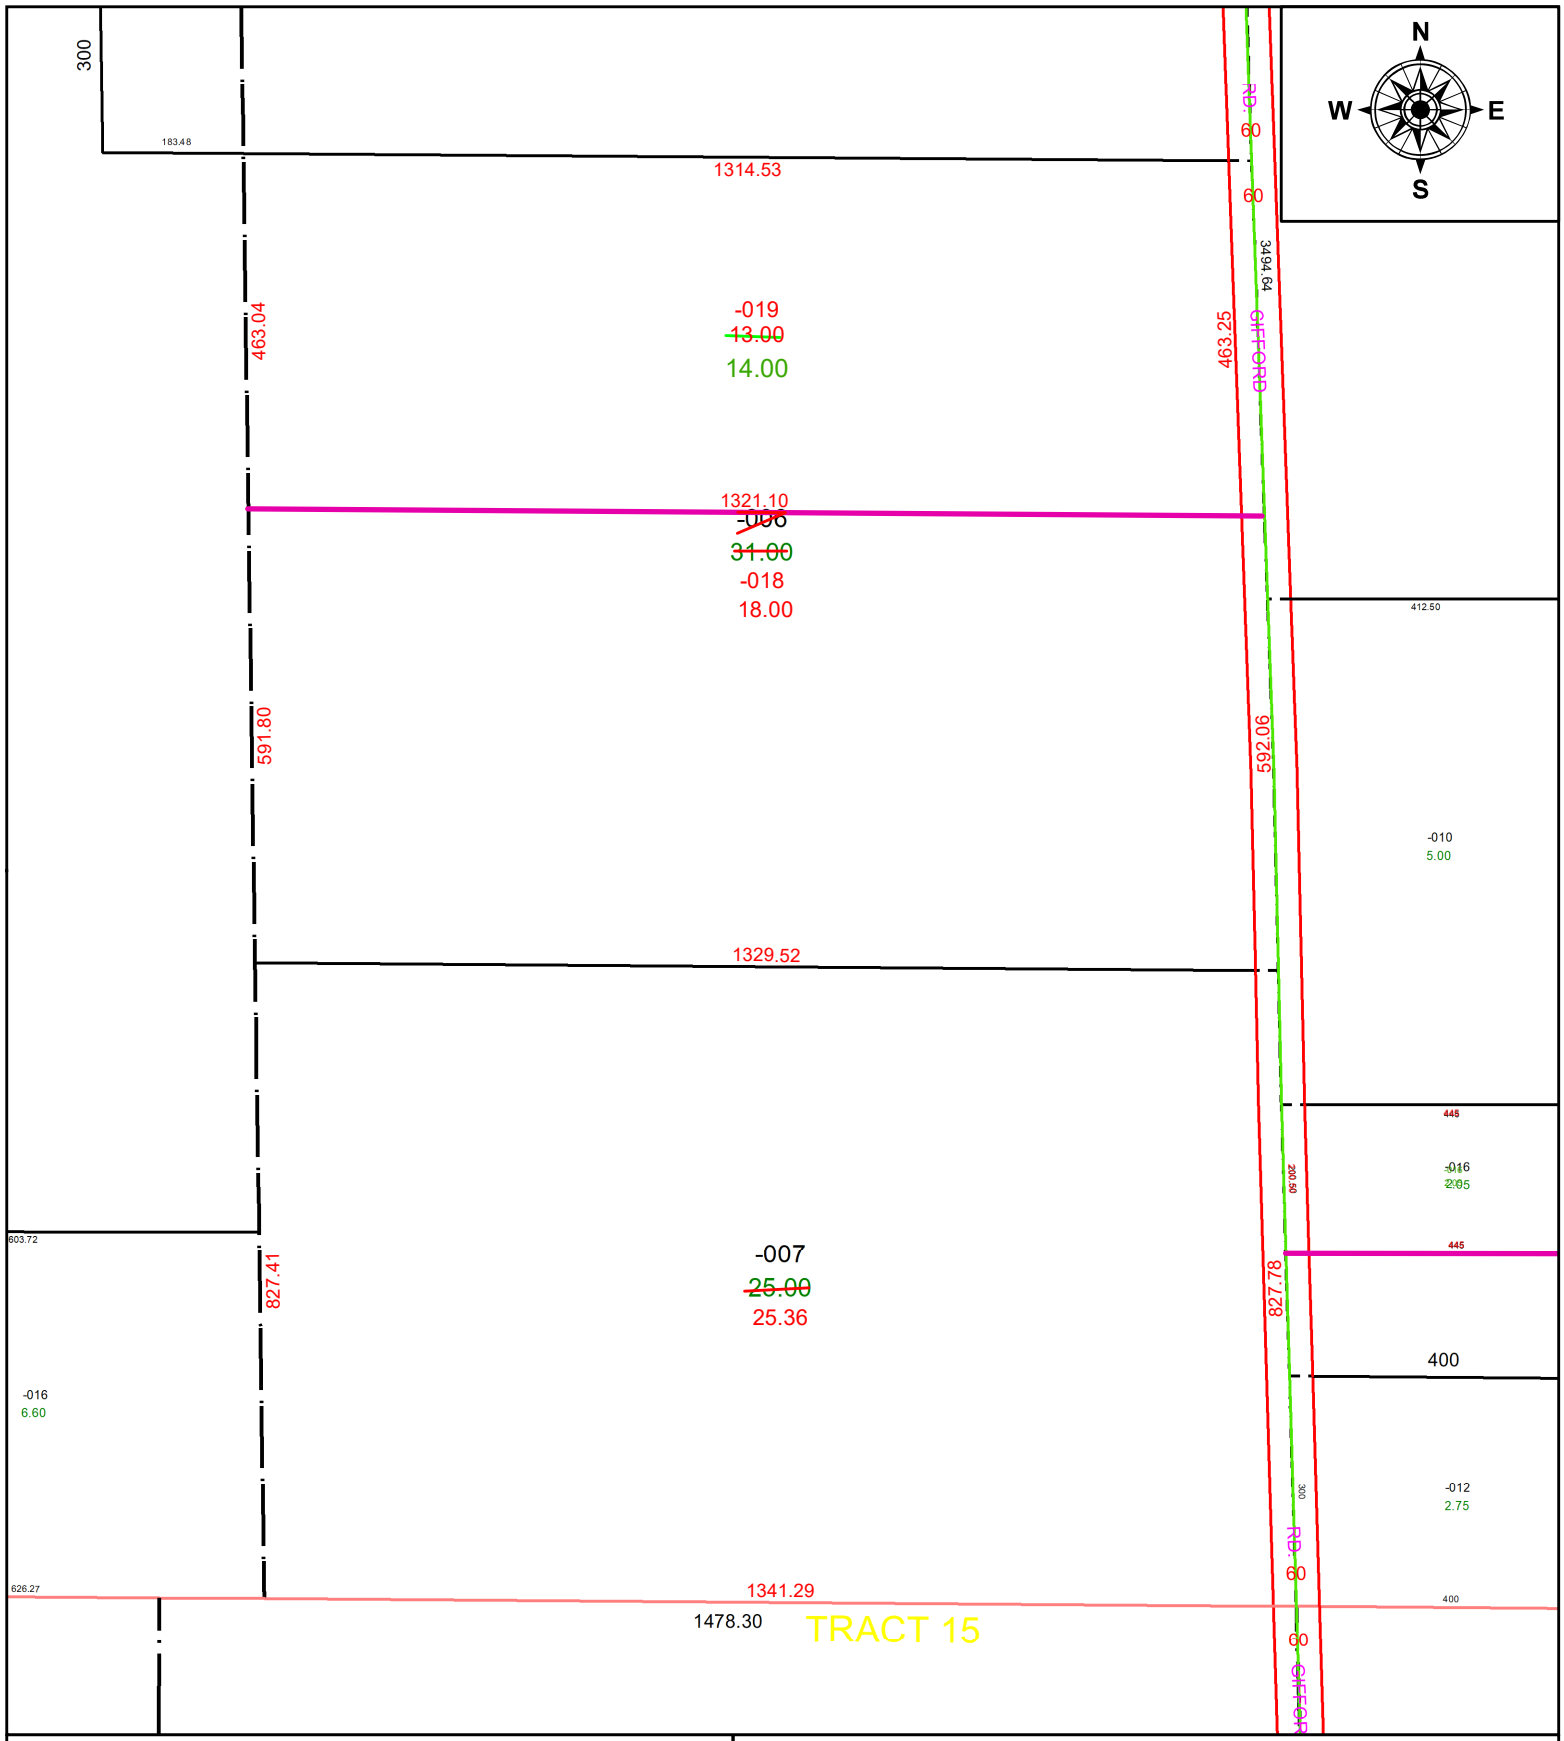

SPLITS/DEEDS PROCESSED

LORAIN COUNTY TAX MAP DEPARTMENT
226 MIDDLE AVE. ELYRIA, OH

SURVEYED BY: BRENT D. ANDERSON **SURV # 51038**

CLOSURE: 1: 370878

MAP PAGE(S): 08-00-102

APPOVED BY: AC **DATE:** October 26, 2023

SCALE: 1 in = 250 ft **PRIOR INSTRUMENT:** 2022- 0899851