PARENT PARCEL: 05-00-097-101-018

CHILD PARCEL: AC CORR PER SURV BY THOMAS A. SIMON

STARTING POINT: C/L OF CROSSE RD AND NORTH RIDGE RD

22-04774-C

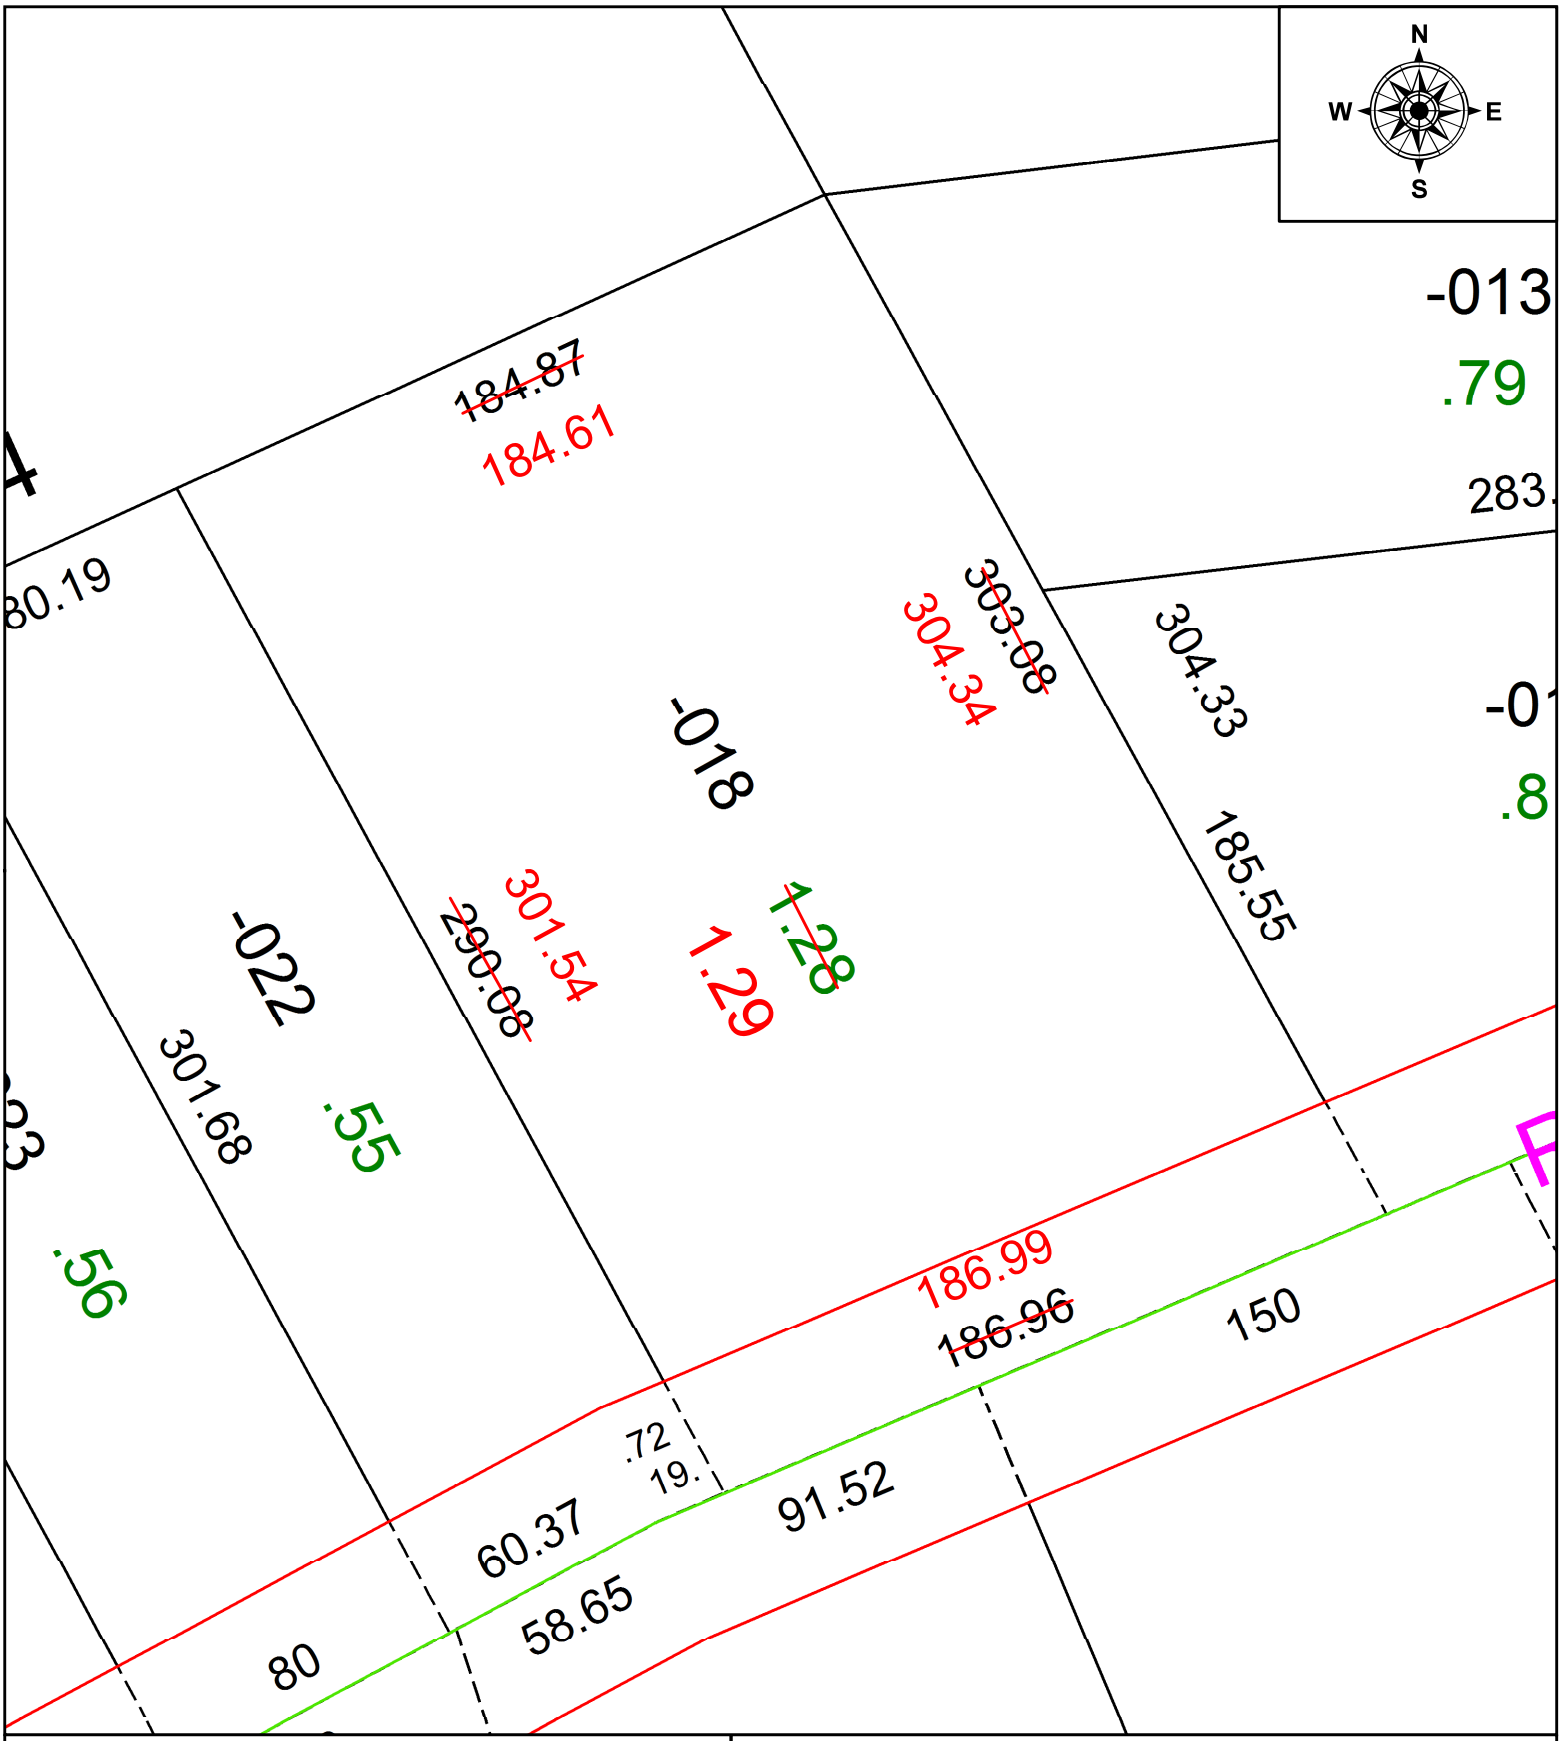

SPLITS/DEEDS PROCESSED

LORAIN COUNTY TAX MAP DEPARTMENT
226 MIDDLE AVE. ELYRIA, OH

SURVEYED BY: THOMAS A. SIMON
CLOSURE: 1: 100789
MAP PAGE(S): 05-00-097-A
APPOVED BY: AC **DATE:** 1/21/2022
SCALE: 1" = 50 **PRIOR INSTRUMENT:** 2021- 0852027