**PARENT PARCEL:** 09-00-096-103-013 & -014

**CHILD PARCEL:** 09-00-096-103-048 THRU -051 AC CORR PER SURVEYOR BRENT ANDERSON

**STARTING POINT:** INSTERSECTION OF C/LS OF SMITH ST & SOUTH PLESANT ST

**23-04776**

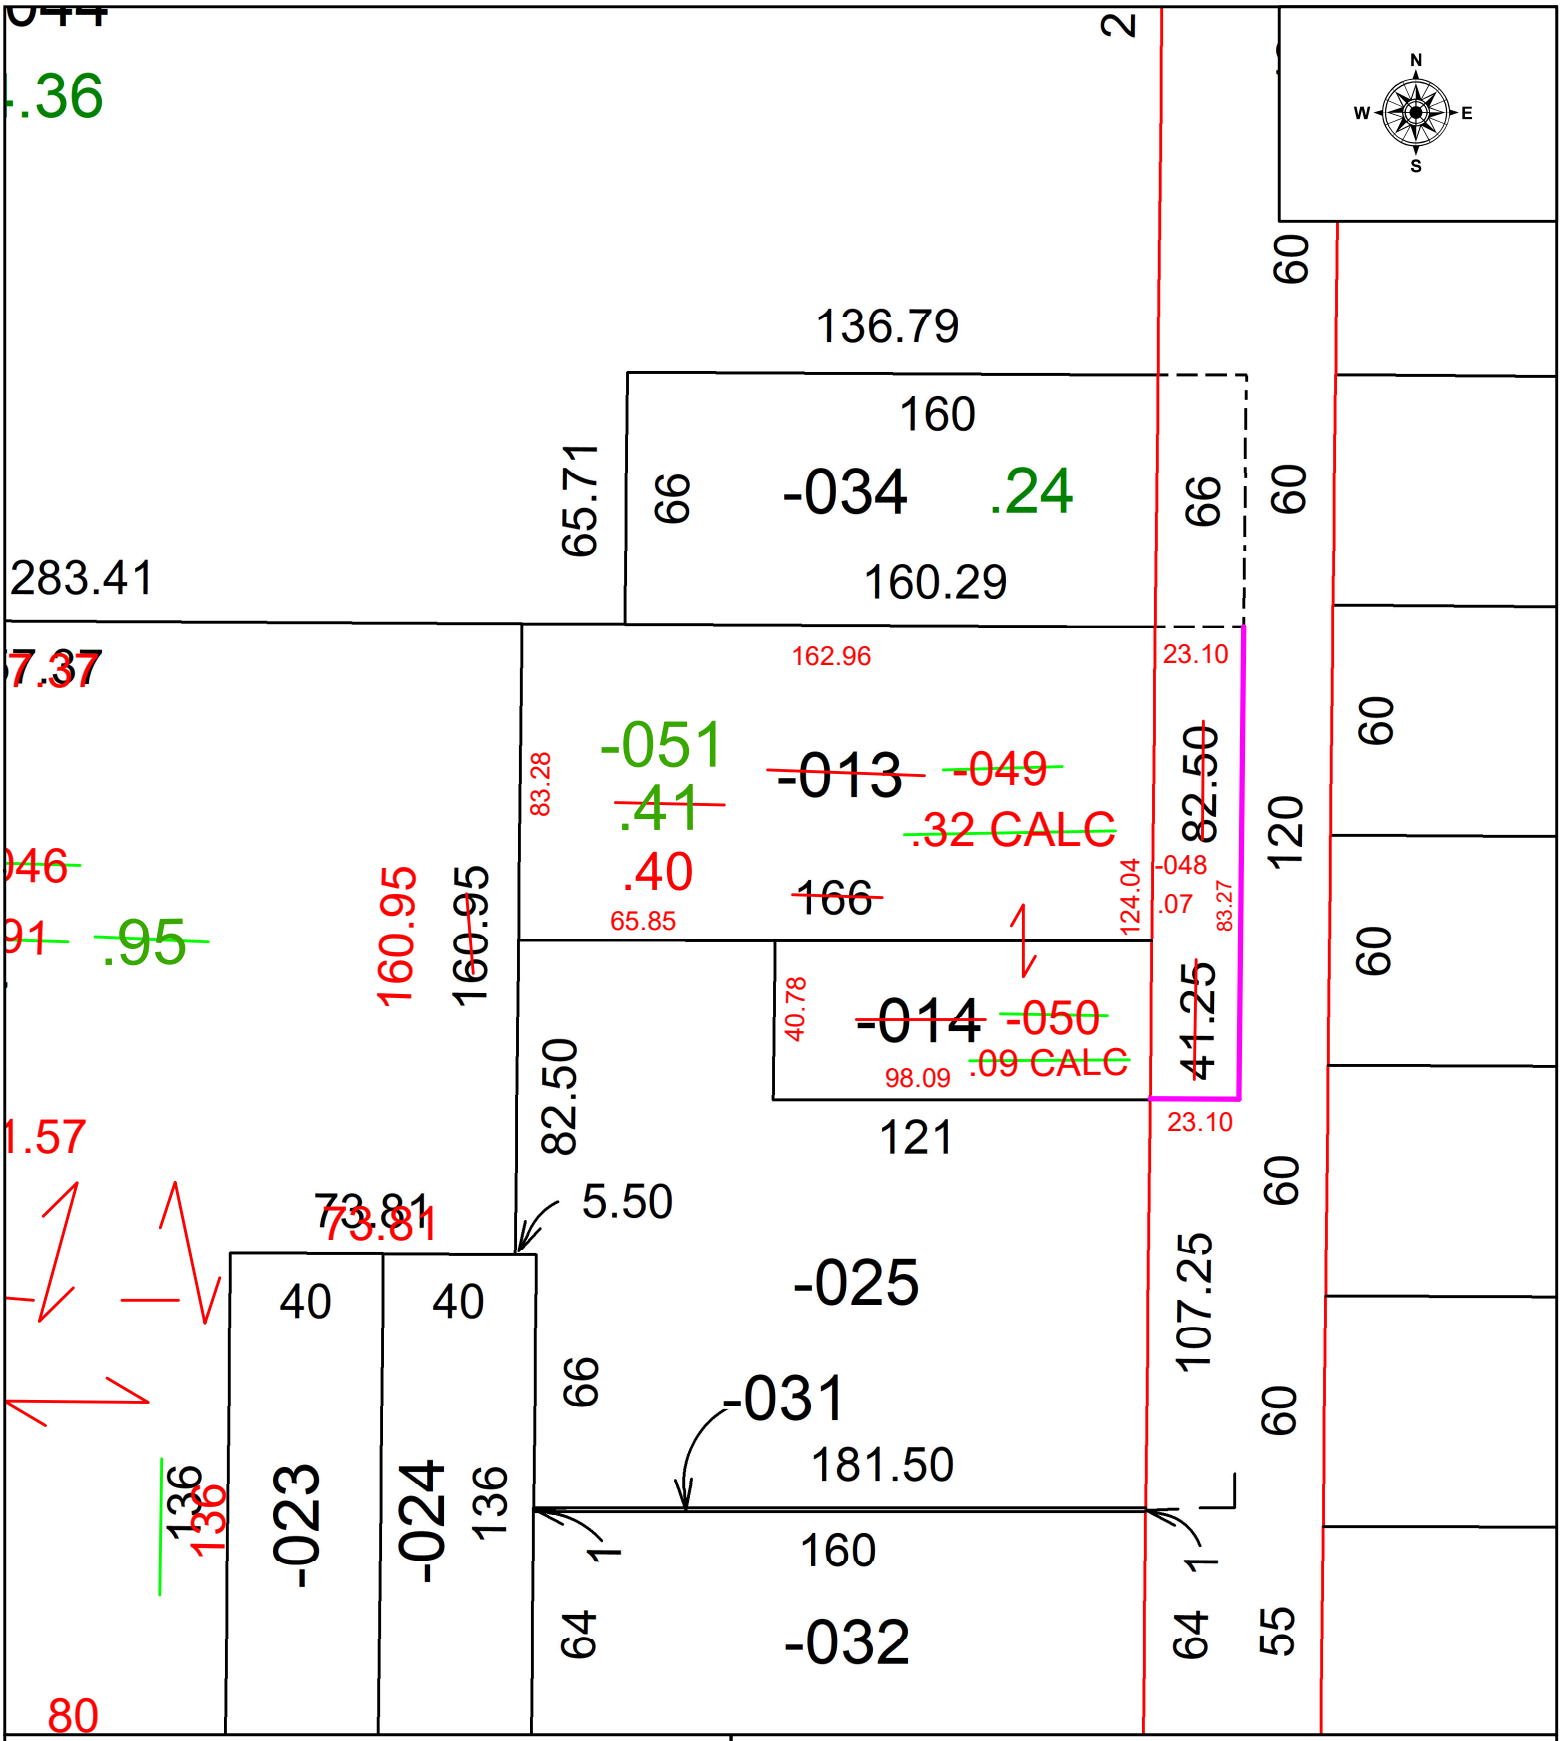


**SPLITS/DEEDS PROCESSED**

LORAIN COUNTY TAX MAP DEPARTMENT
226 MIDDLE AVE. ELYRIA, OH

**SURVEYED BY:** BRENT ANDERSON SURVEY # 51052
**CLOSURE:** 1: INF
**MAP PAGE(S):** 09-00-096
**APPOVED BY:** WRZ **DATE:** 11/7/2023
**SCALE:** 1" = 50 **PRIOR INSTRUMENT:** #2020-0787653