**PARENT PARCEL:** 15-00-099-101-208, -215, & -239
**CHILD PARCEL:** 15-00-099-101-249, -250, & -251
**STARTING POINT:** SW CORNER OF S/L 531

23-04778

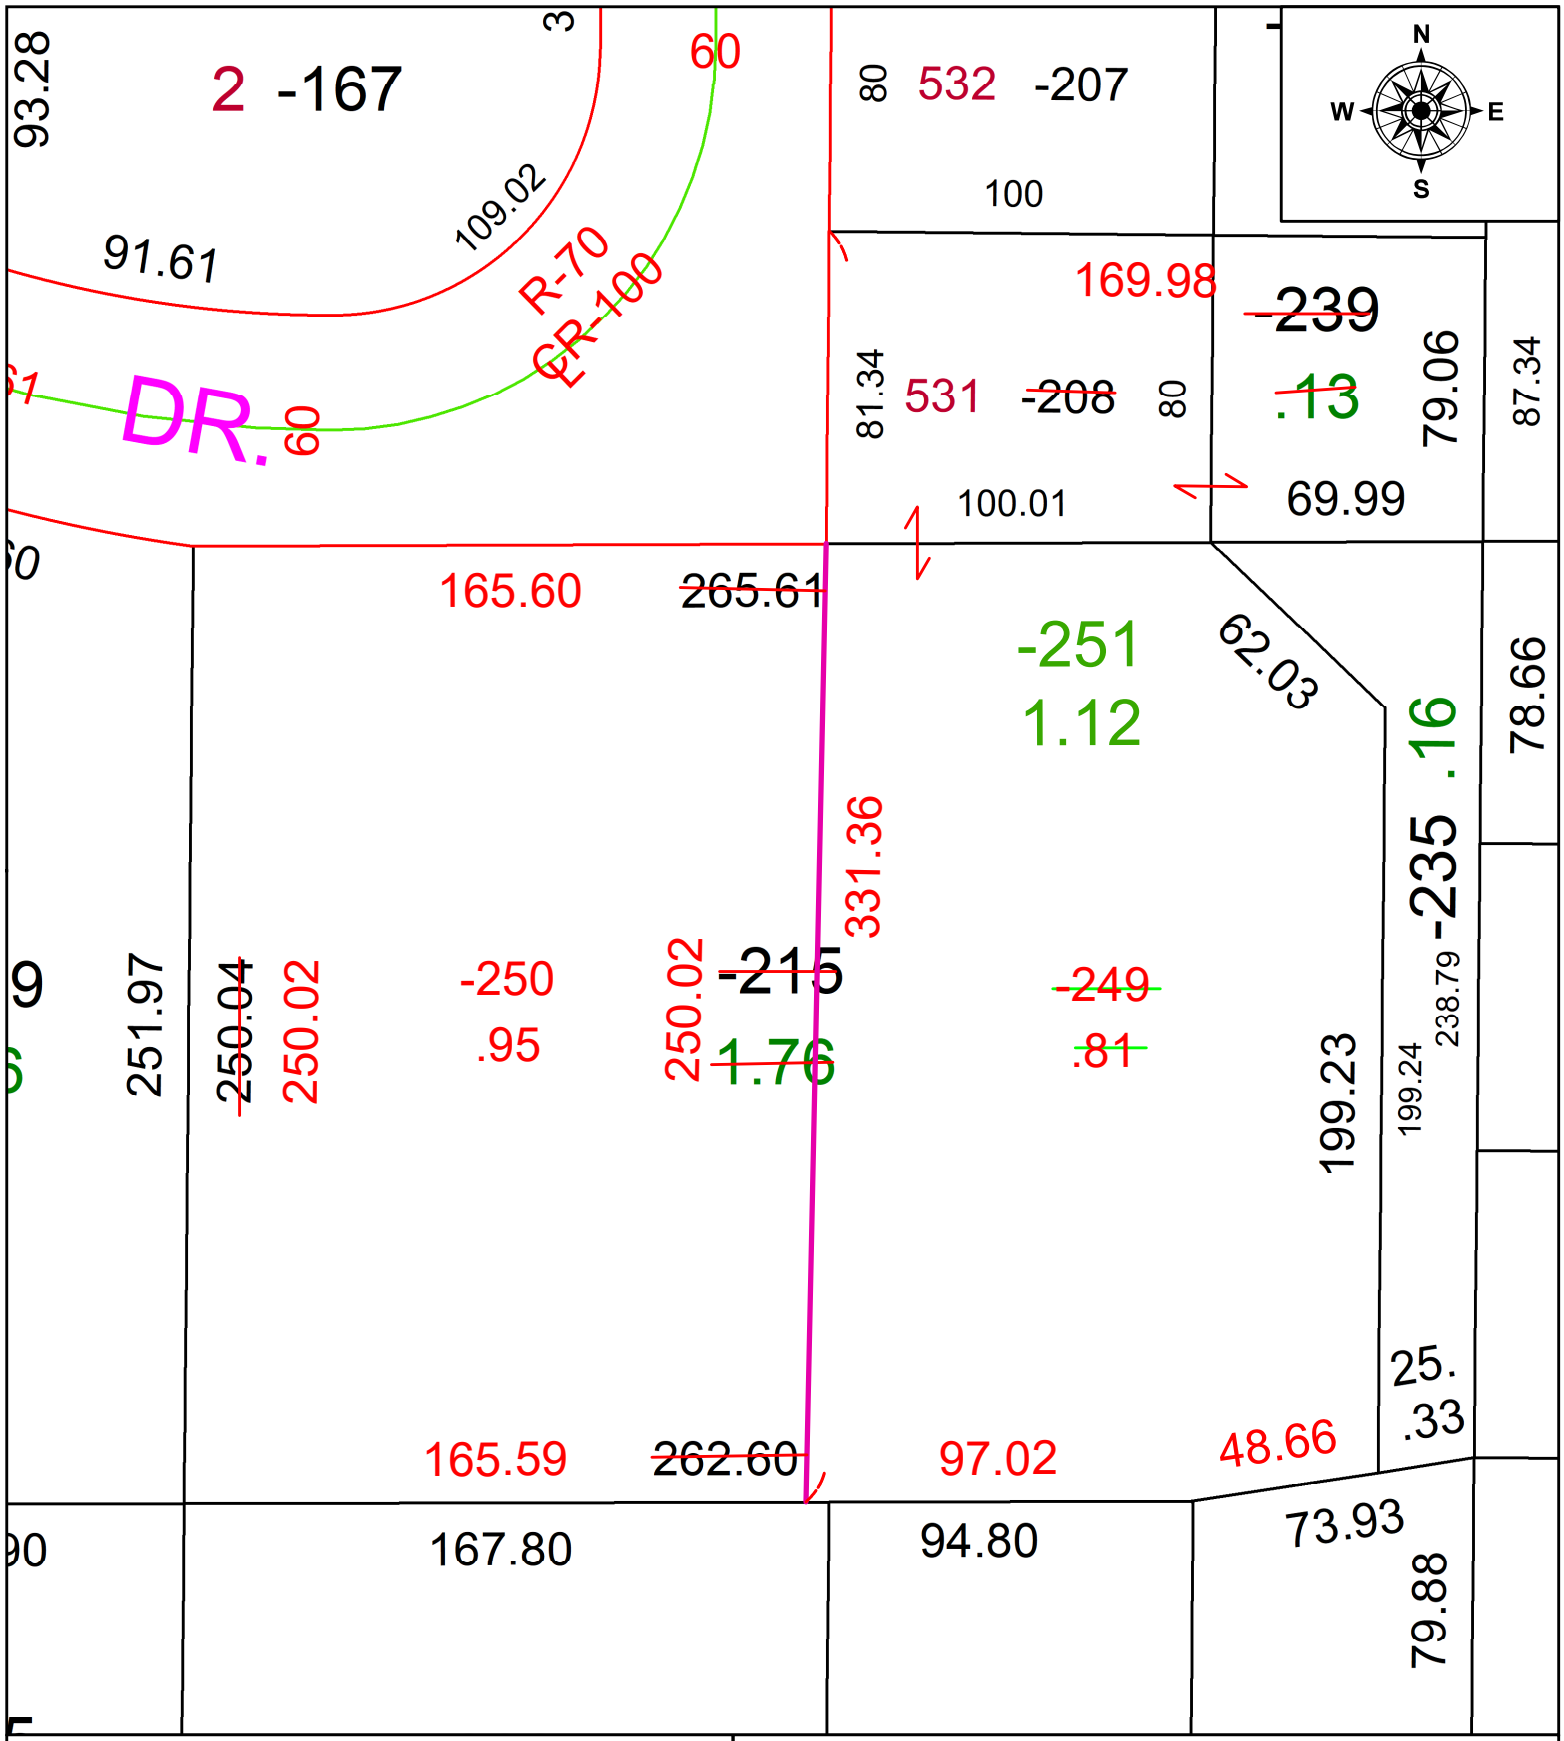


**SPLITS/DEEDS PROCESSED**
LORAIN COUNTY TAX MAP DEPARTMENT
226 MIDDLE AVE. ELYRIA, OH

**SURVEYED BY:** THOMAS A. SIMON **SURV # 51054**
**CLOSURE:** 1: 142613
**MAP PAGE(S):** 15-00-099
**APPOVED BY:** AC **DATE:** November 07, 2023
**SCALE:** 1 in = 50 ft **PRIOR INSTRUMENT:** 2021- 094066