PARENT PARCEL: 04-00-010-111-027

CHILD PARCEL: MAP CORRECTION ONLY PER SURVEY AMY KELLY

STARTING POINT: CL OF COLORADO AVE. & DETROIT RD.

22-04782-A

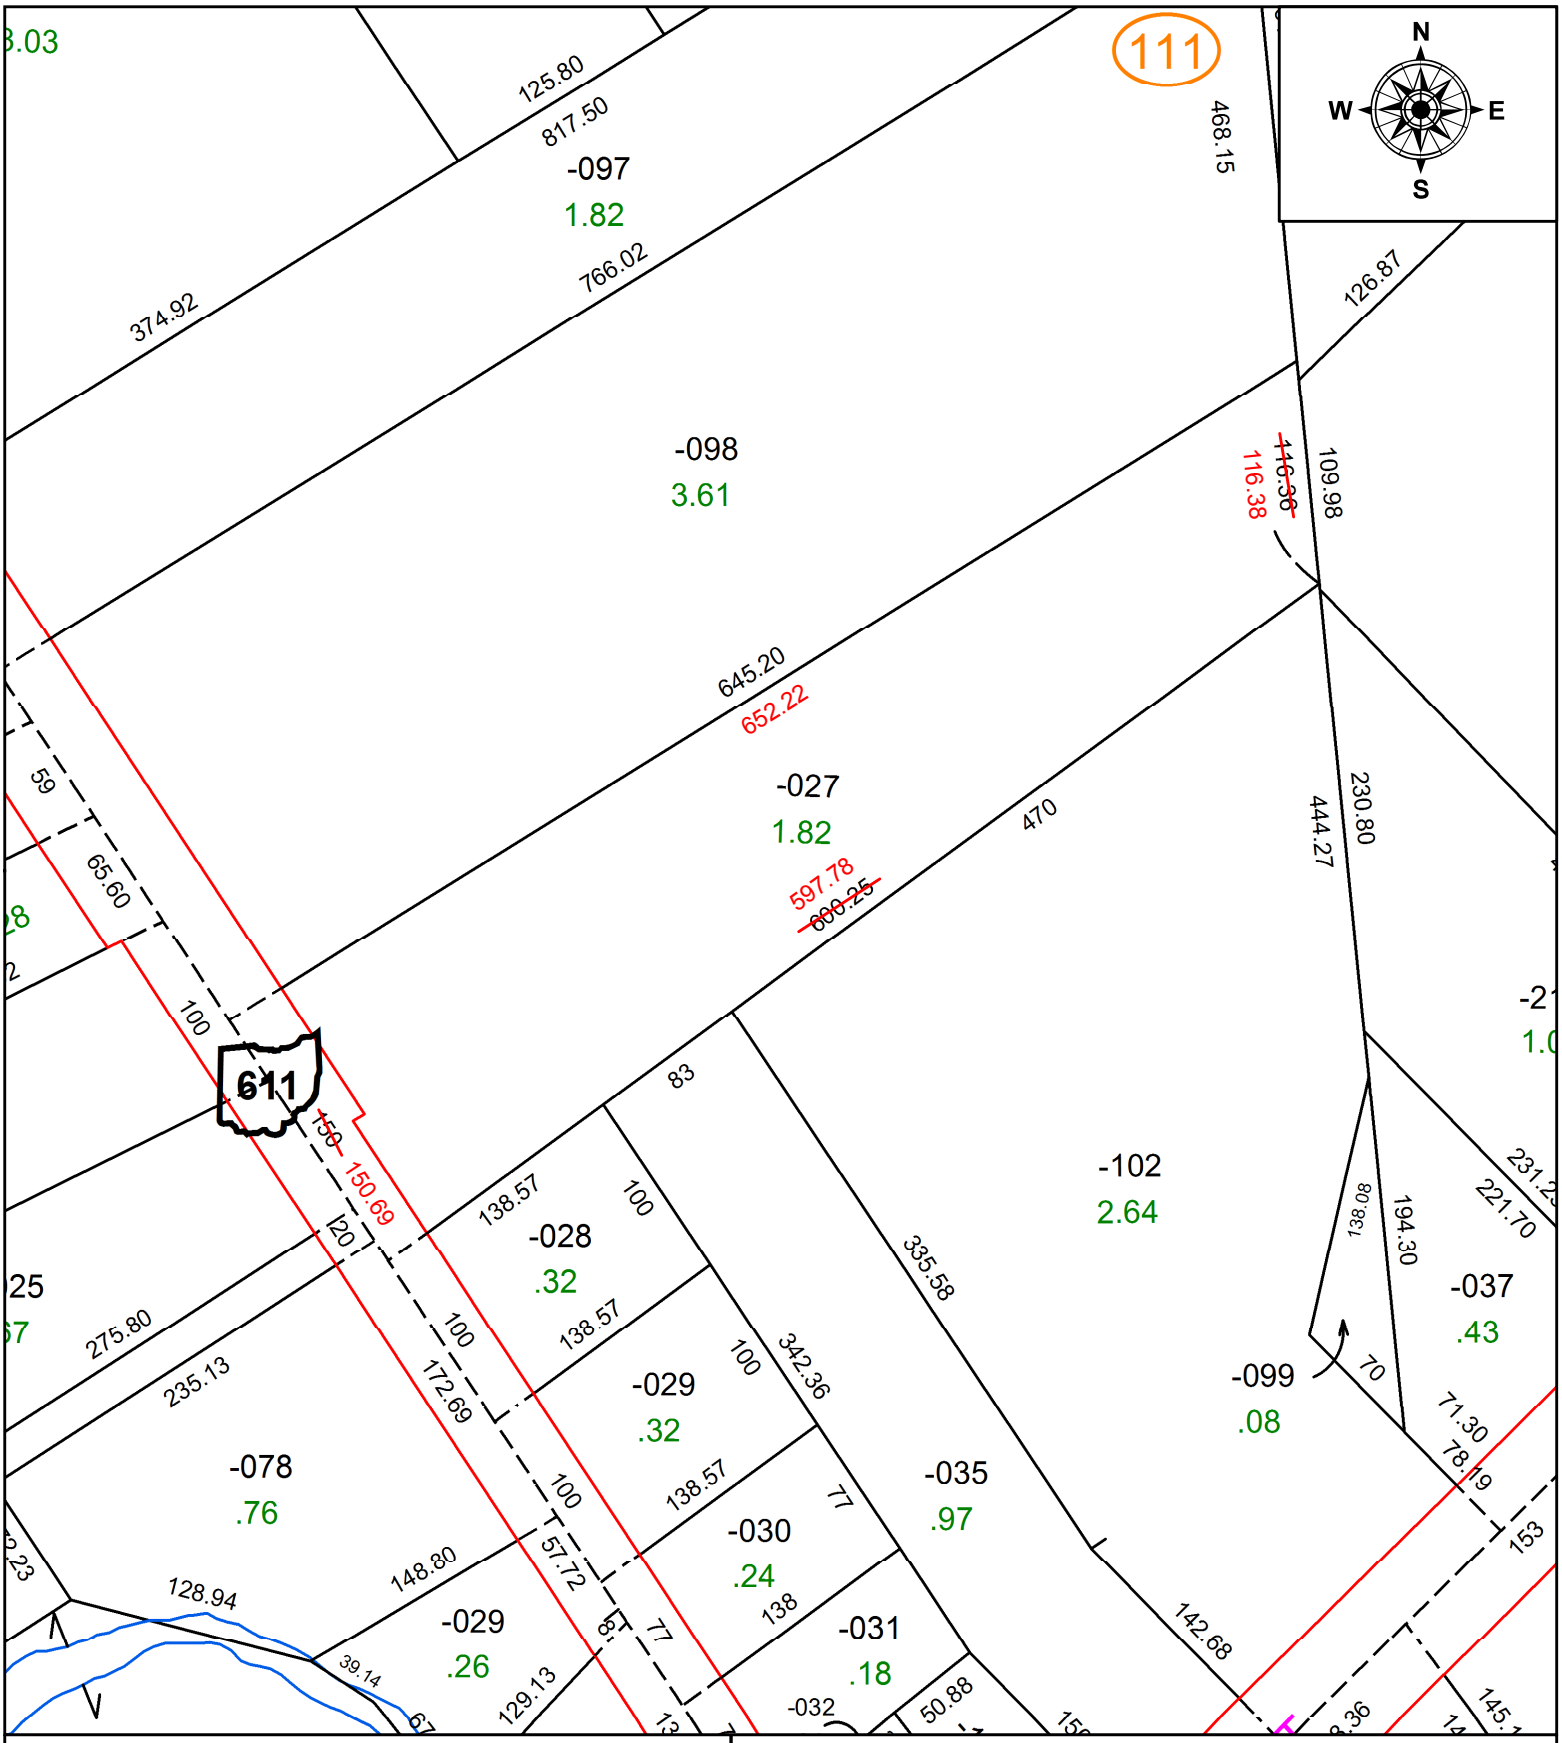

SPLITS/DEEDS PROCESSED

LORAIN COUNTY TAX MAP DEPARTMENT
226 MIDDLE AVE. ELYRIA, OH

SURVEYED BY: AMY KELLY
CLOSURE: 1: 613,270
MAP PAGE(S): 04-00-010
APPOVED BY: DMA **DATE:** 2/8/2022
SCALE: 1" = 100' **PRIOR INSTRUMENT:** 2021-0797071