PARENT PARCEL: 16-00-053-000-001 & 16-00-053-000-007

CHILD PARCEL: 16-00-053-000-013 THRU -016 & ST:16-00-053-000-007

STARTING POINT: C/L OF ISLAND RD AND SR 303 **AC CORR PER SURV BY JOHN A. DECHANT JR.**

23-04782

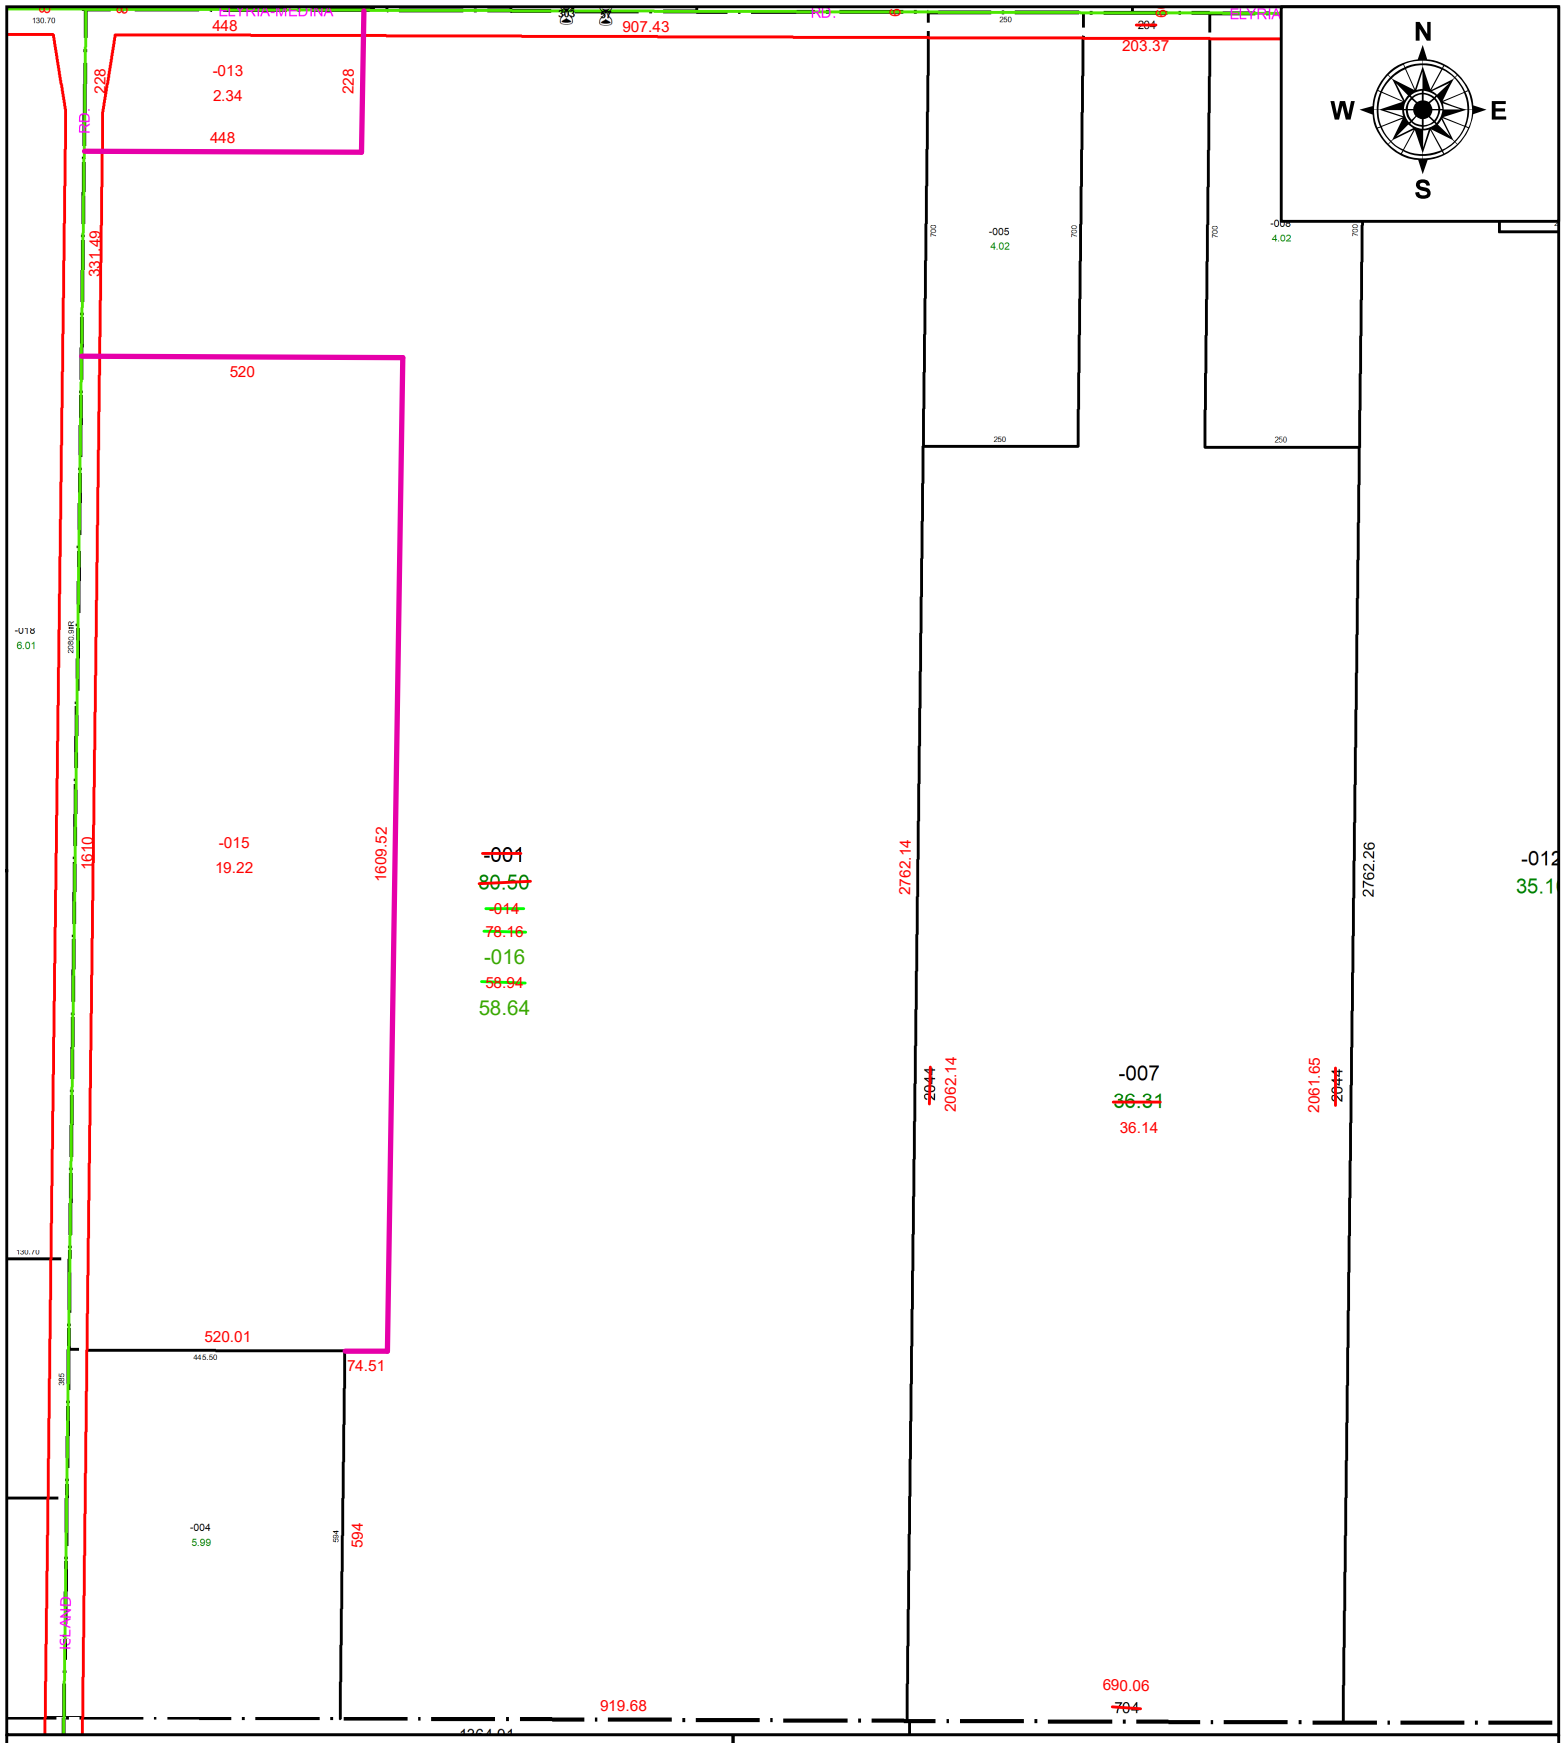

SPLITS/DEEDS PROCESSED

LORAIN COUNTY TAX MAP DEPARTMENT
226 MIDDLE AVE. ELYRIA, OH

SURVEYED BY: JOHN A. DECHANT JR. **SURV # 51058**

CLOSURE: 1: 2147483648

MAP PAGE(S): 16-00-053

APPOVED BY: AC **DATE:** November 17, 2023

SCALE: 1 in = 310 ft **PRIOR INSTRUMENT:** 2022- 0858804