PARENT PARCEL: 09-00-048-000-005 & 09-00-058-000-001

CHILD PARCEL: 09-00-058-000-041, -042, & 09-00-048-000-005 AC CORR PER SURVEYOR TIMOTHY HOZALSKI

STARTING POINT: IP PIN @ SOUTHEAST CORNER OF O.L. 48 & NORTHEAST CORNER OF O.L. 58

23-04787

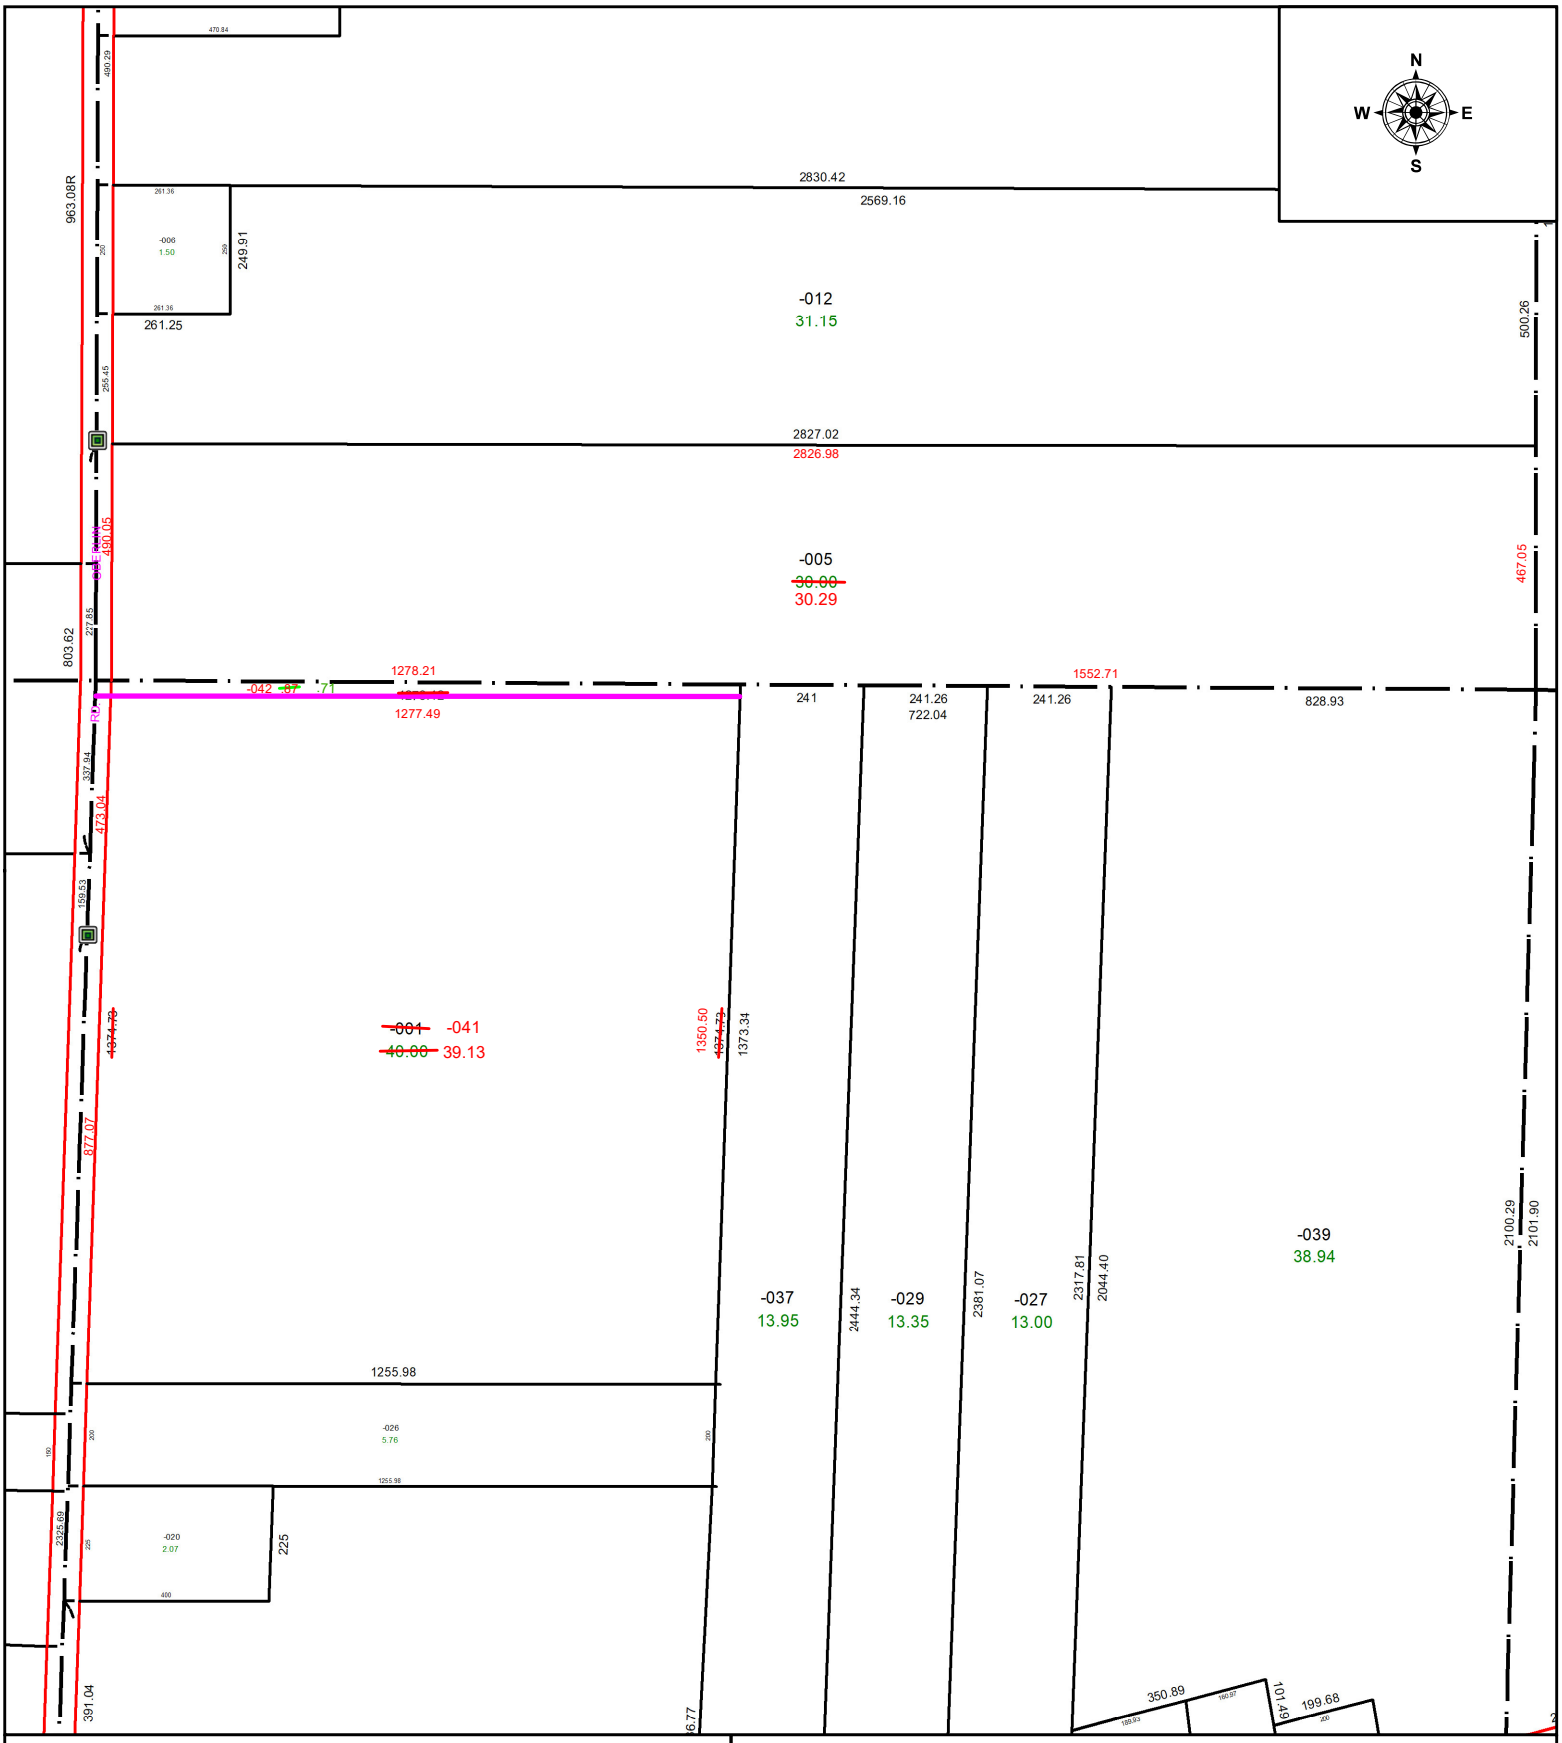

SPLITS/DEEDS PROCESSED

LORAIN COUNTY TAX MAP DEPARTMENT
226 MIDDLE AVE. ELYRIA, OH

SURVEYED BY: TIMOTHY HOZALSKI SURVEY # 51067

CLOSURE: 1: 645048

MAP PAGE(S): 09-00-048 & 09-00-058

APPOVED BY: WRZ **DATE:** 11/21/2023

SCALE: 1" = 375 **PRIOR INSTRUMENT:** #2020-0788154