PARENT PARCEL: 01-00-044-000-019

CHILD PARCEL: 01-00-044-000-063, -064, -065 AC CORR PER SURVEYOR THOMAS SIMON

STARTING POINT: MAG NAIL @ INTERSECTION OF C/LS OF NORTH RIDGE RD & CLAUS RD

23-04791

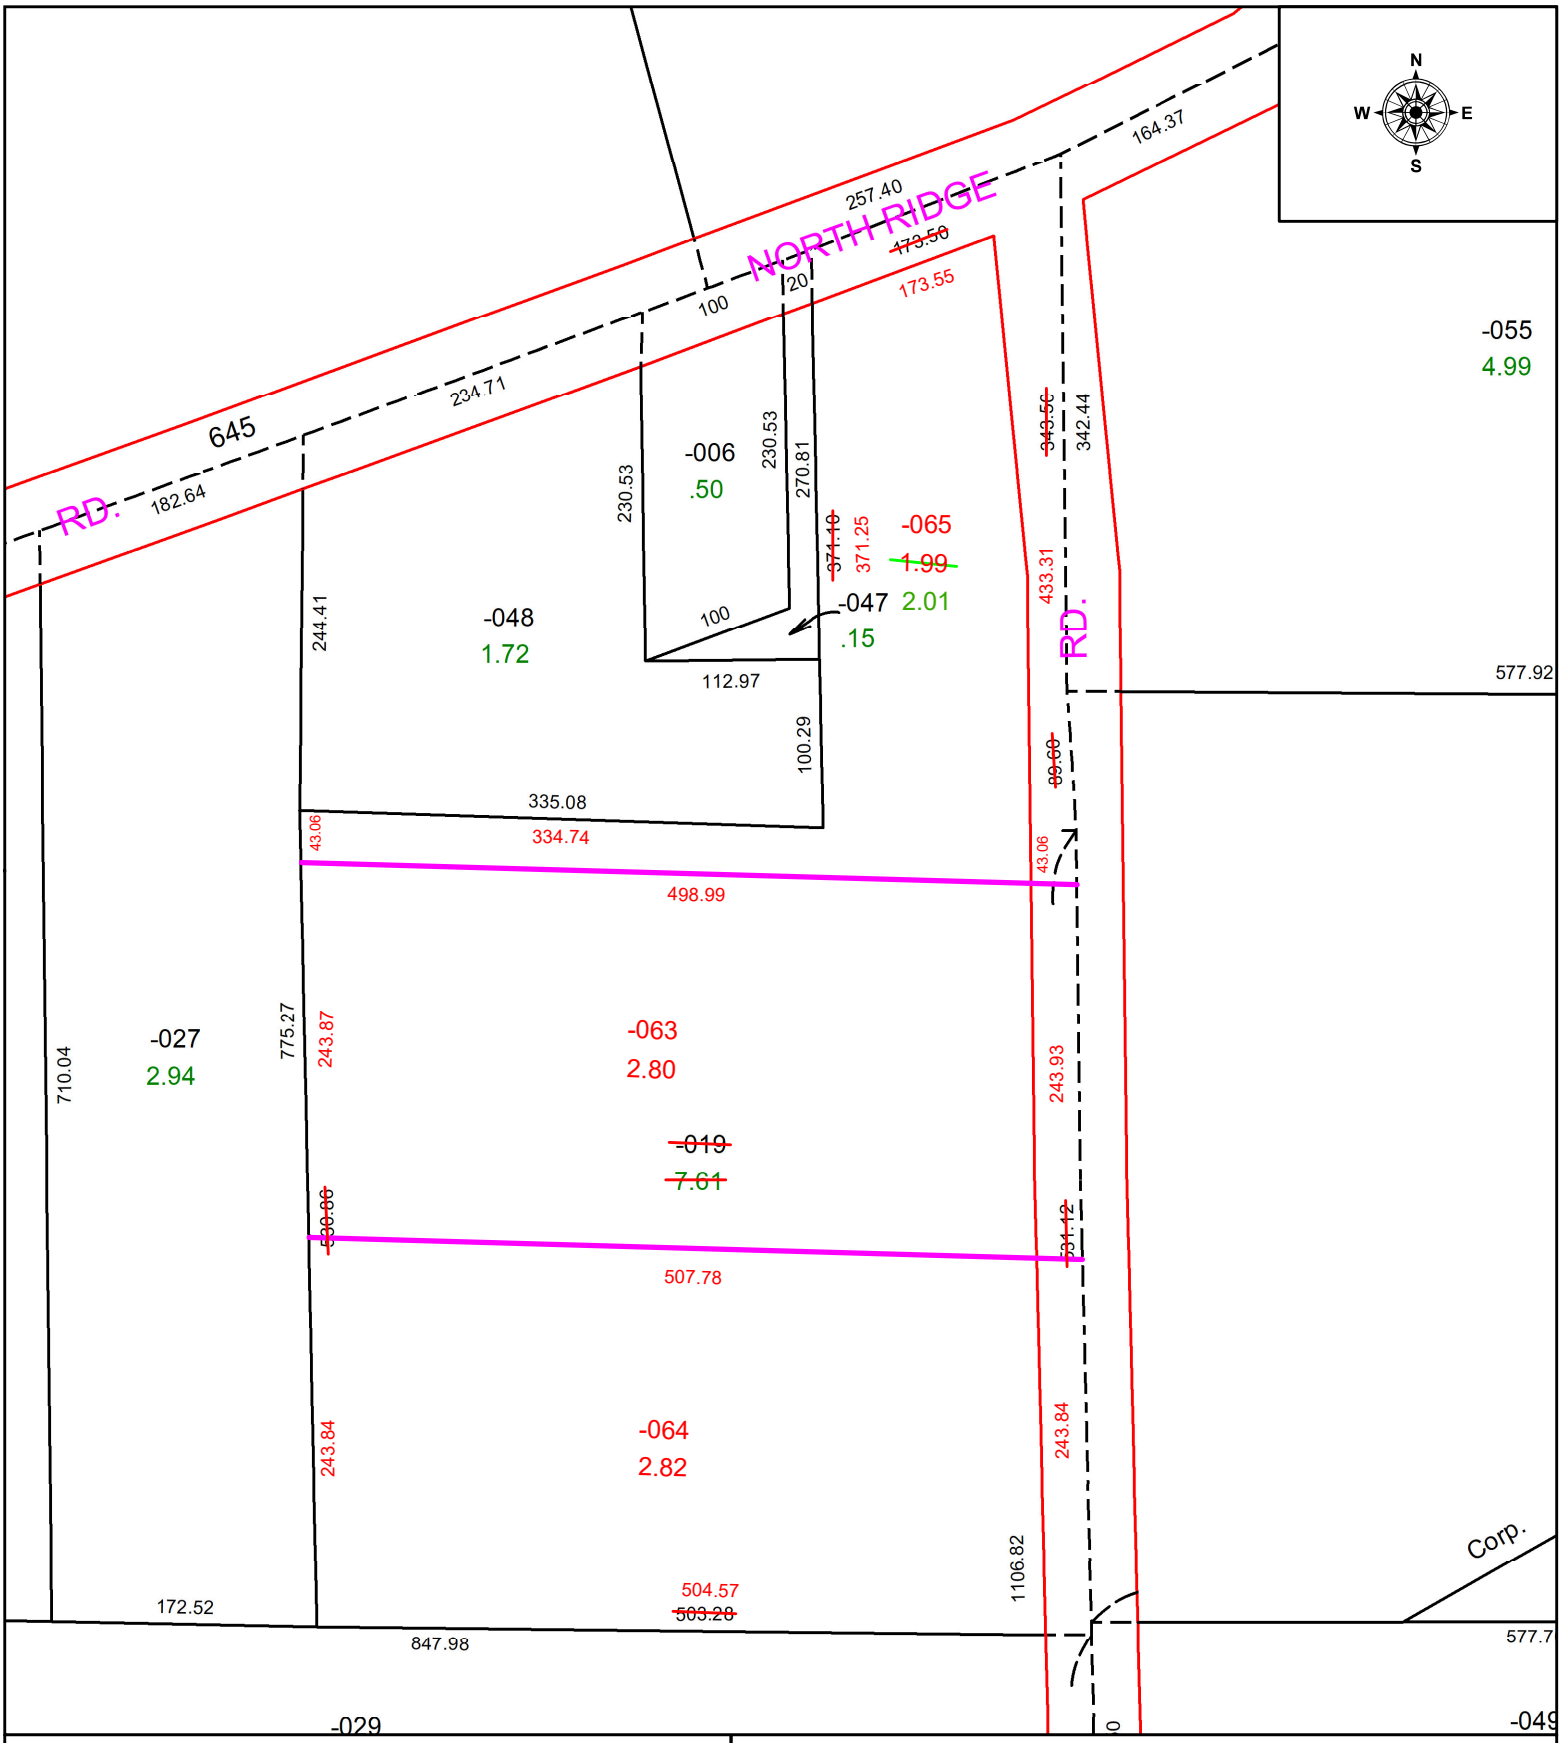

SPLITS/DEEDS PROCESSED

LORAIN COUNTY TAX MAP DEPARTMENT
226 MIDDLE AVE. ELYRIA, OH

SURVEYED BY: THOMAS SIMON SURVEY # 51074

CLOSURE: 1: 331232

MAP PAGE(S): 01-00-044

APPOVED BY: WRZ **DATE:** 12/4/2023

SCALE: 1" = 125 **PRIOR INSTRUMENT:** #2019-07232082