PARENT PARCEL: 08-00-099-000-034 & 08-00-094-000-006

CHILD PARCEL: 08-00-099-000-036 THRU -039 & 08-00-094-000-008 THRU -011

STARTING POINT: NW CORNER OF O/L 99 AND SW CORNER OF O/L 94

23-04792

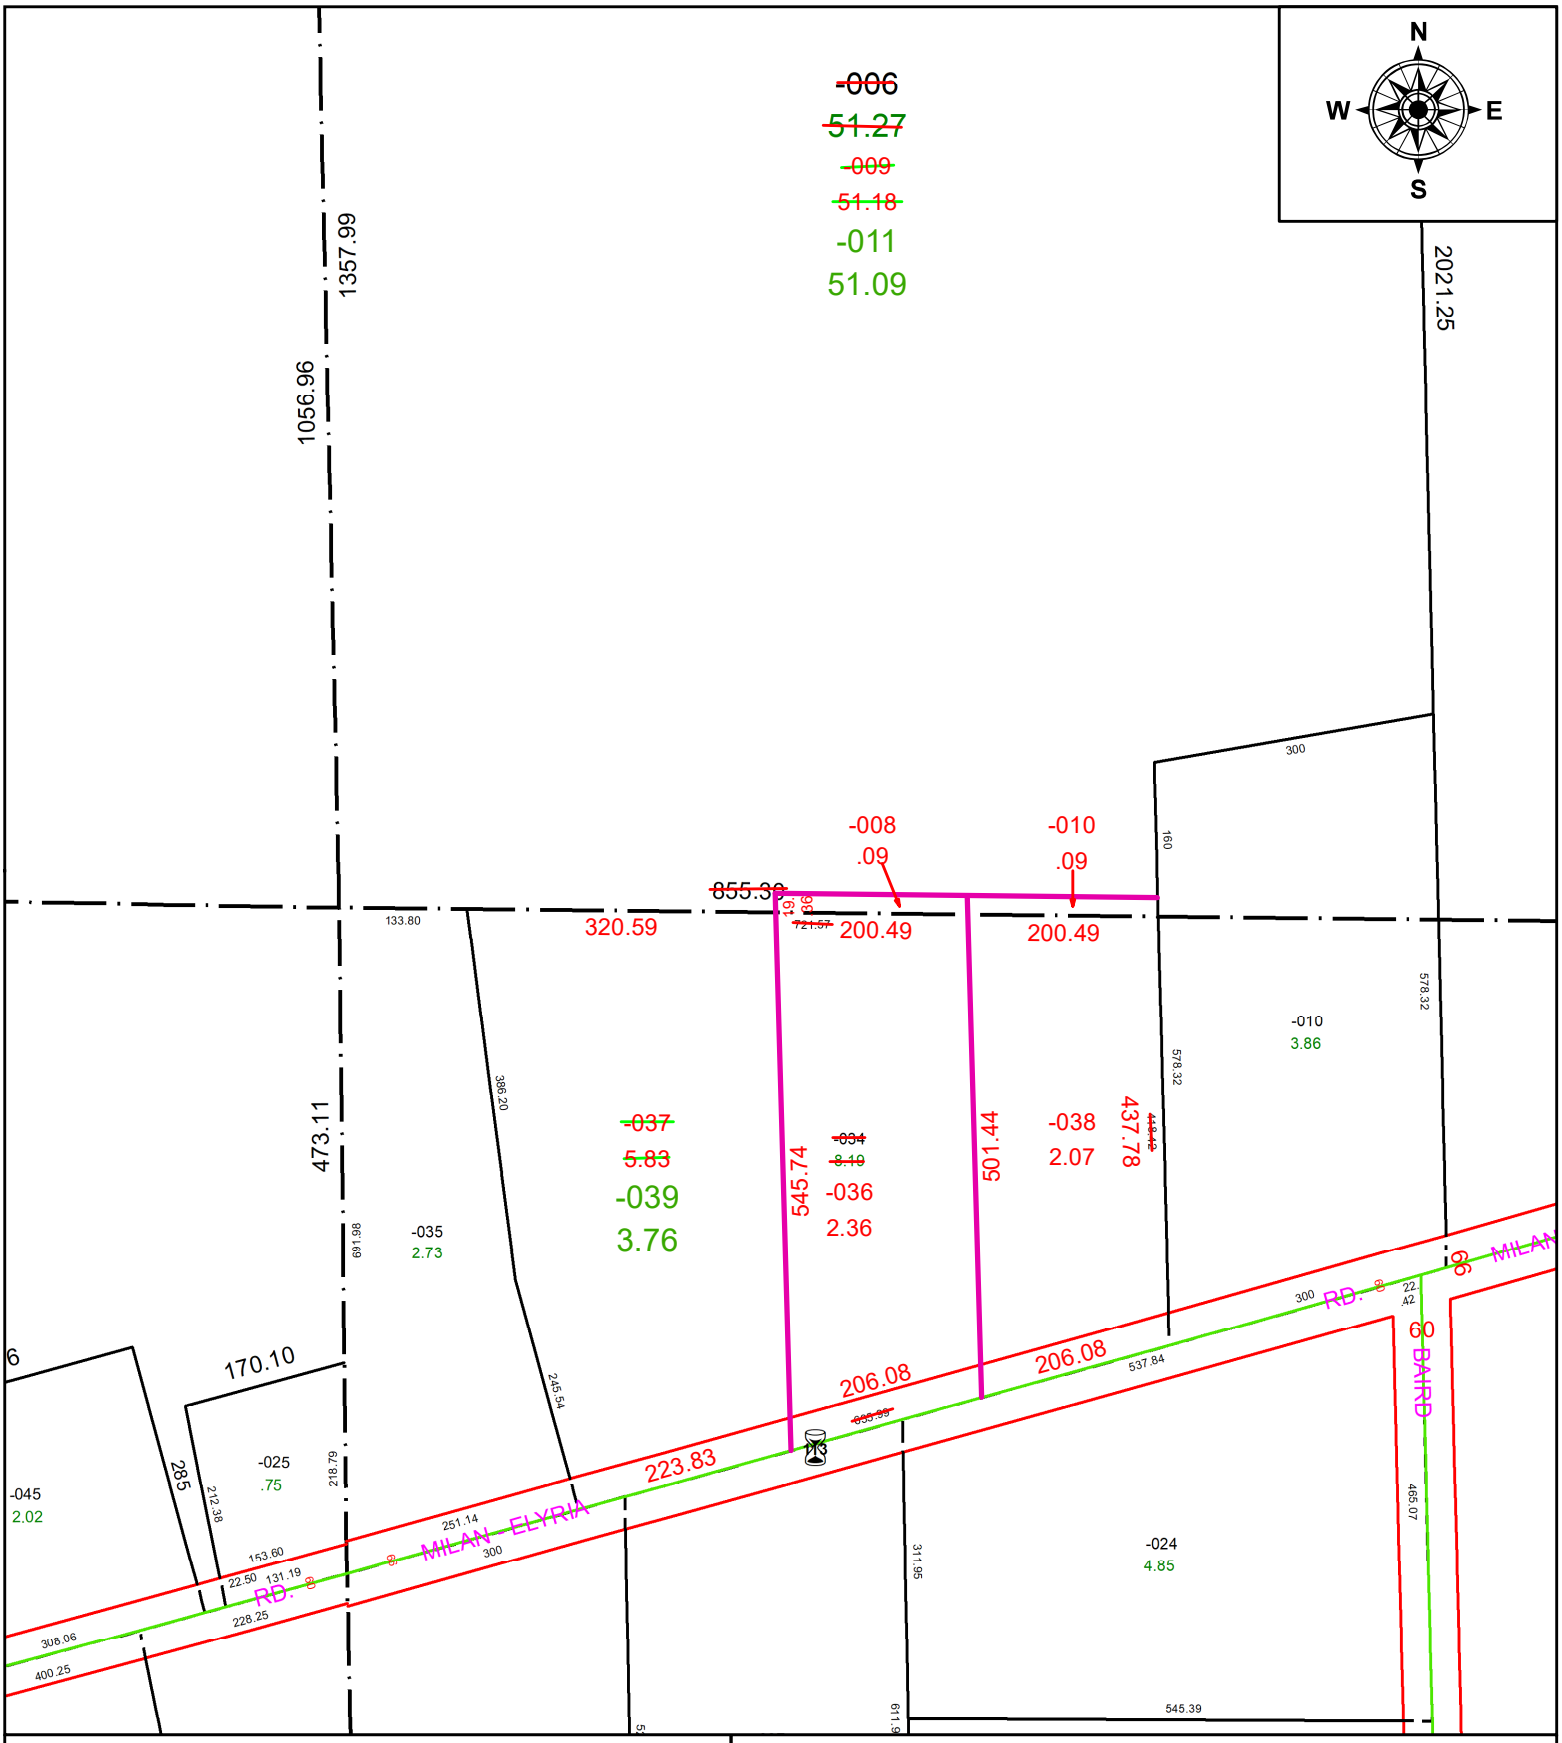

SPLITS/DEEDS PROCESSED

LORAIN COUNTY TAX MAP DEPARTMENT
226 MIDDLE AVE. ELYRIA, OH

SURVEYED BY: TIMOTHY D. HOZALSKI **SURV # 51072**

CLOSURE: 1: 1070648

MAP PAGE(S): 08-00-099

APPOVED BY: AC **DATE:** December 04, 2023

SCALE: 1 in = 200 ft **PRIOR INSTRUMENT:** 2023- 0910486