PARENT PARCEL: 21-01-011-000-004

CHILD PARCEL: 21-01-011-000-007 & -008

STARTING POINT: C/L OF CLARK RD AND S LINE OF O/L 11

23-04795

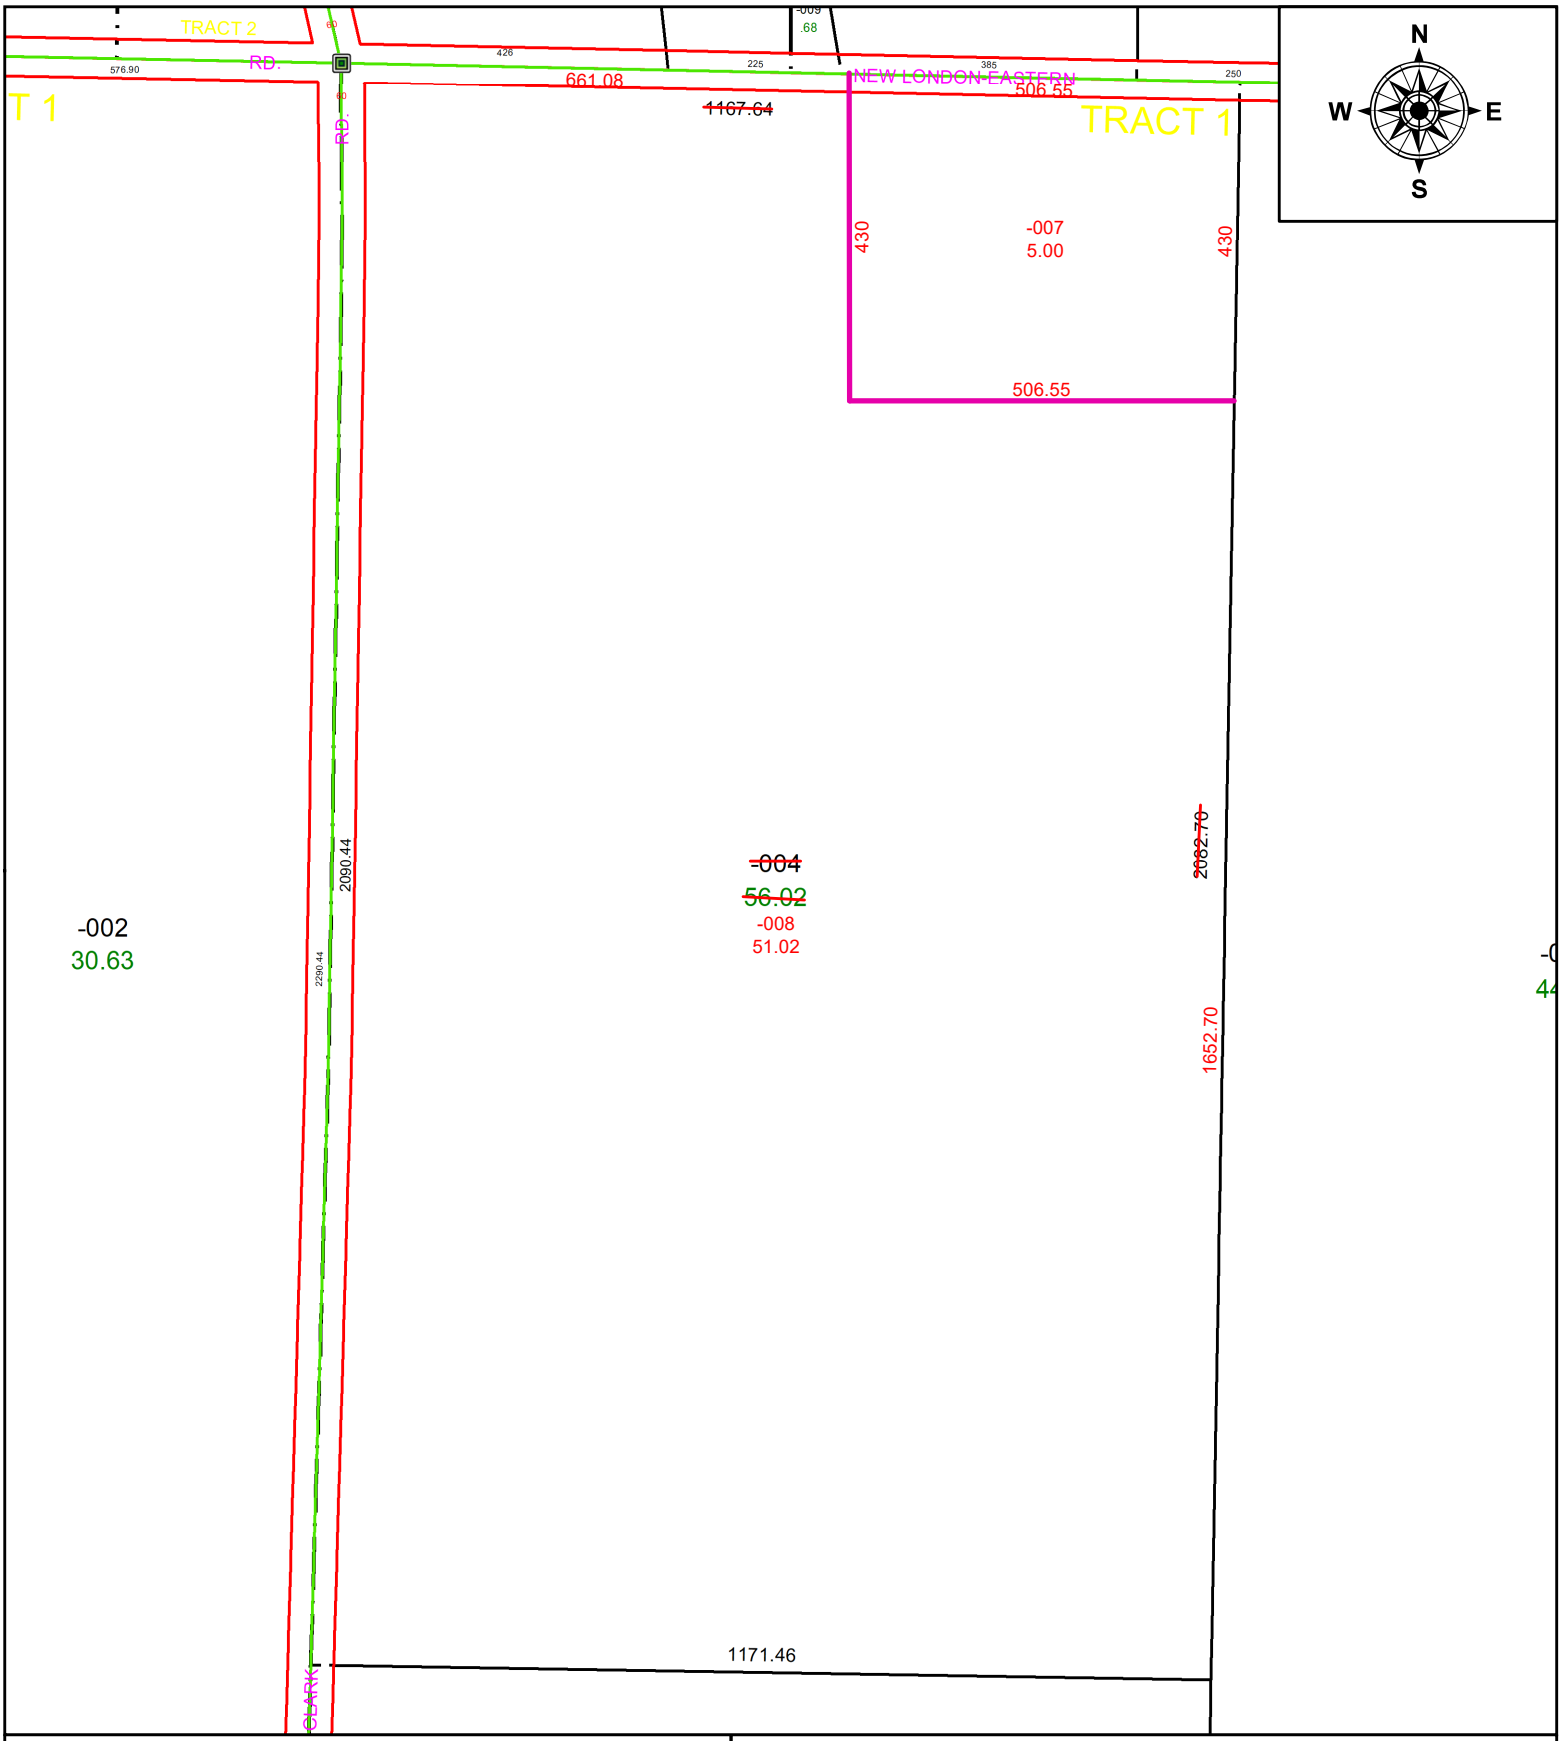

SPLITS/DEEDS PROCESSED

LORAIN COUNTY TAX MAP DEPARTMENT
226 MIDDLE AVE. ELYRIA, OH

SURVEYED BY: GEORGE A. HOFMANN **SURV # 51081**

CLOSURE: 1: 100789

MAP PAGE(S): 21-01-011

APPOVED BY: AC **DATE:** December 11, 2023

SCALE: 1 in = 250 ft **PRIOR INSTRUMENT:** 2013- 0462778