PARENT PARCEL: 09-00-079-000-003

CHILD PARCEL: 09-00-079-000-029 & -030

STARTING POINT: OBERLIN CITY ANNEXATION / UNCOMBINATION PER RES. 22-147

22-04799-X

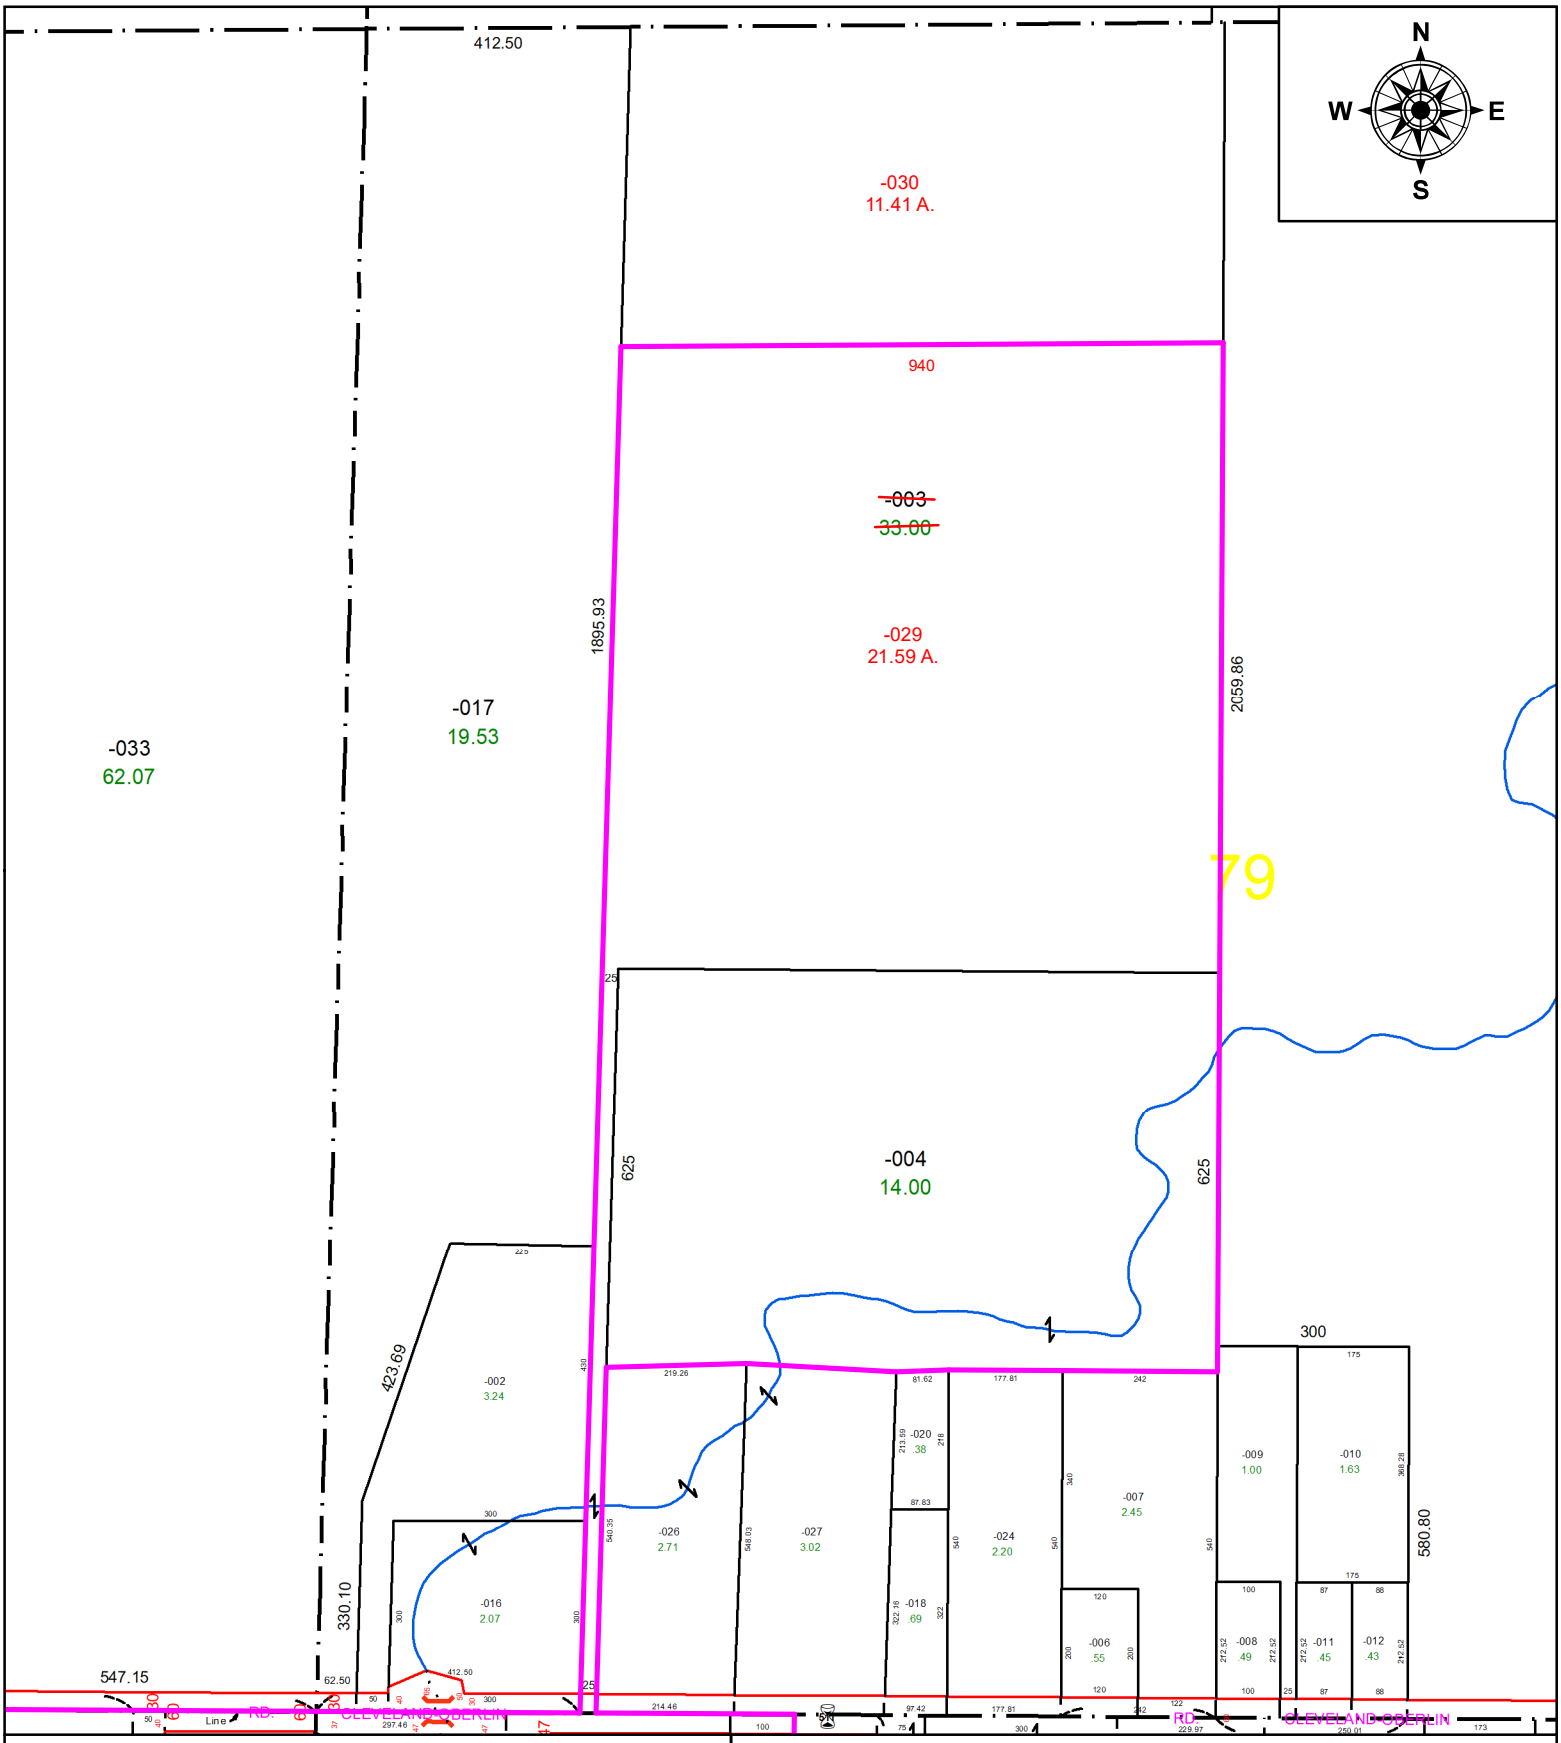

SPLITS/DEEDS PROCESSED

LORAIN COUNTY TAX MAP DEPARTMENT
226 MIDDLE AVE. ELYRIA, OH

SURVEYED BY: TREVOR BIXLER KS ASSOC.

CLOSURE: NA

MAP PAGE(S): 09-00-079

APPOVED BY: TJS **DATE:** 3/2/2022

SCALE: 1" = 300' **PRIOR INSTRUMENT:** DV XXXX/XXXX