PARENT PARCEL: 06-26-002-102-002, -003, -004
CHILD PARCEL: 06-26-002-102-040
STARTING POINT: INTERSECTION OF CENTERLINES OF 15TH ST & WEST AVE

23-04799

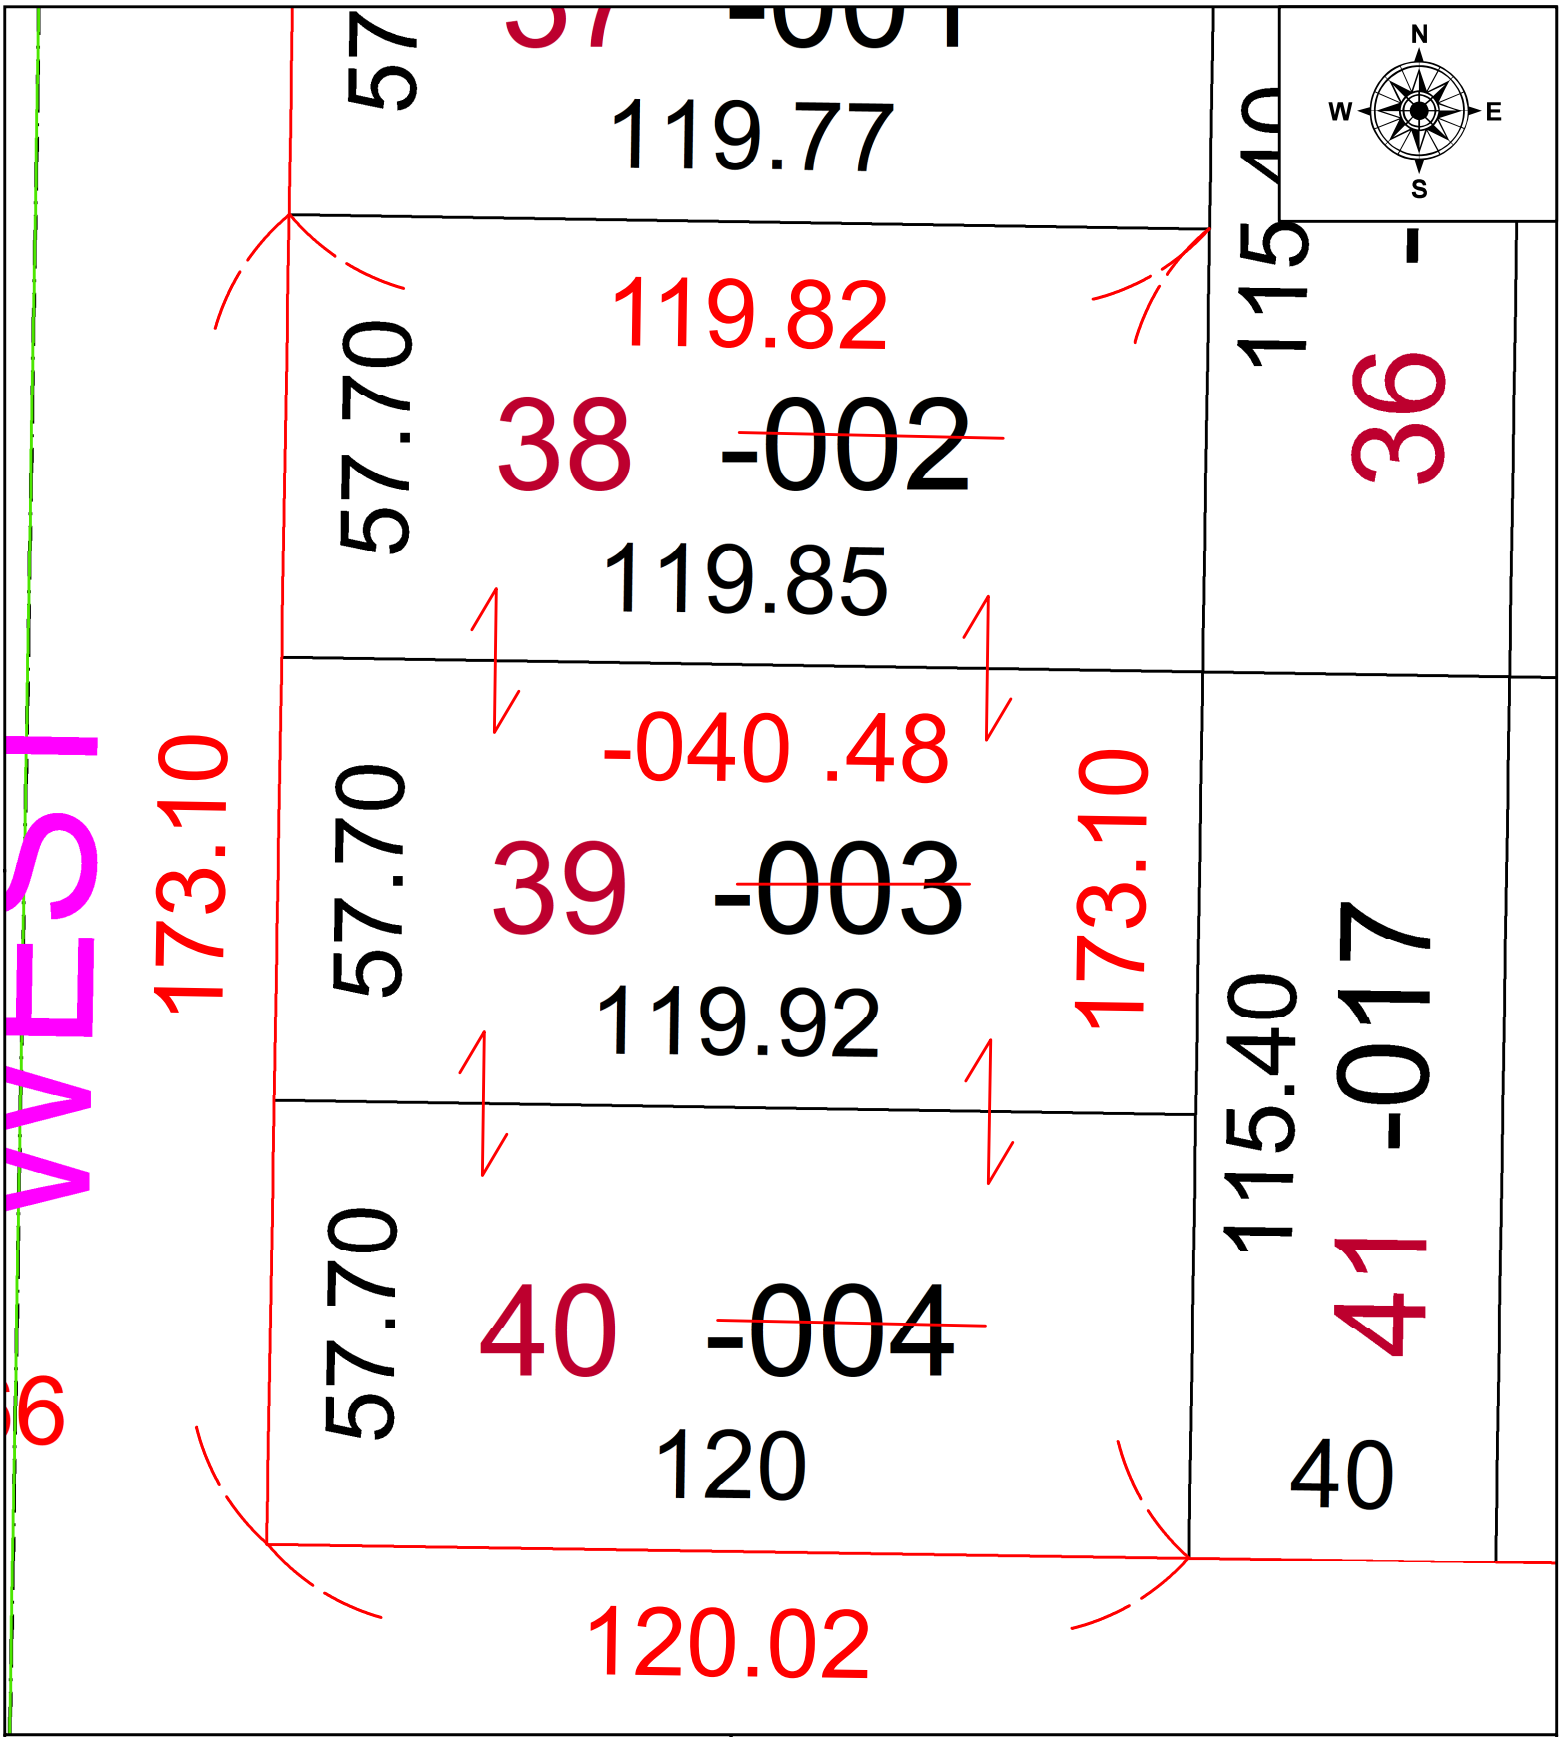

SPLITS/DEEDS PROCESSED
LORAIN COUNTY TAX MAP DEPARTMENT
226 MIDDLE AVE. ELYRIA, OH

SURVEYED BY: BRENT D. ANDERSON **SURVEY #:** 51089
CLOSURE: 1: 413,926
MAP PAGE(S): 06-26-002
APPOVED BY: SP **DATE:** 12/14/2023
SCALE: 1" = 25' **PRIOR INSTRUMENT:** 2023-0931770