PARENT PARCEL: 16-00-048-000-014 & -041

CHILD PARCEL: 16-00-048-000-048 AC CORR PER SURVEYOR WILFREDO BARBOSA

STARTING POINT: IRON PIN @ INTERSECTION OF C/LS OF ISLAND RD & SR 303

23-04800

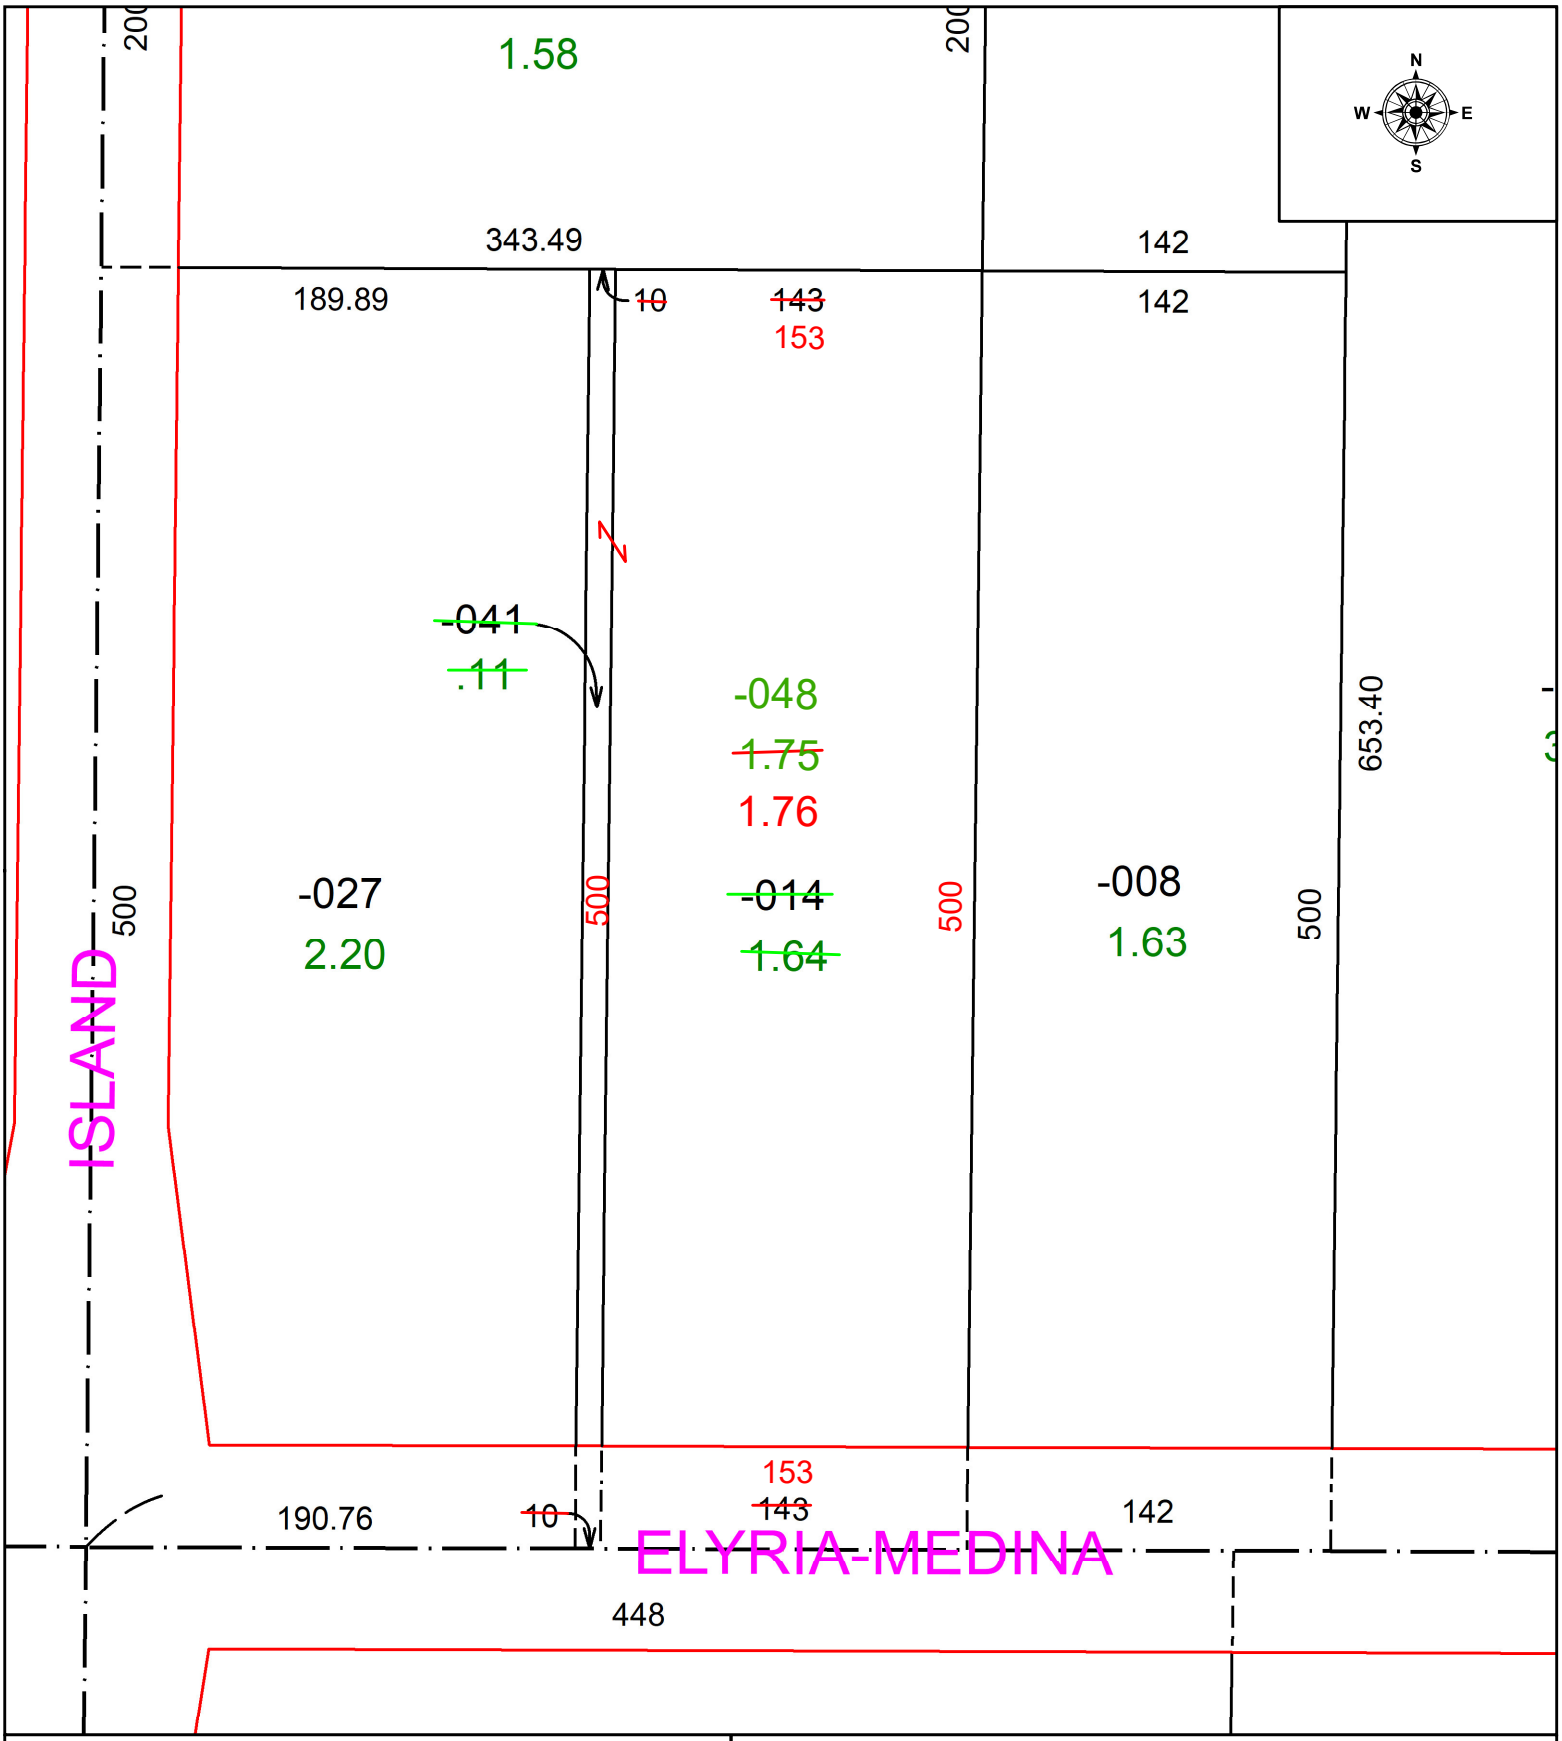

SPLITS/DEEDS PROCESSED

LORAIN COUNTY TAX MAP DEPARTMENT
226 MIDDLE AVE. ELYRIA, OH

SURVEYED BY: WILFREDO BARBOSA SURVEY # 51092

CLOSURE: 1: INF

MAP PAGE(S): 16-00-048

APPOVED BY: WRZ **DATE:** 12/19/2023

SCALE: 1" = 75 **PRIOR INSTRUMENT:** #2017-0646411