PARENT PARCEL: 03-00-002-101-139

CHILD PARCEL: AC. CORR. PER PRIOR INSTRUMENT # 2019-0741204

STARTING POINT: CL OF DETROIT RD. & RESERVE WAY

22-04803-A

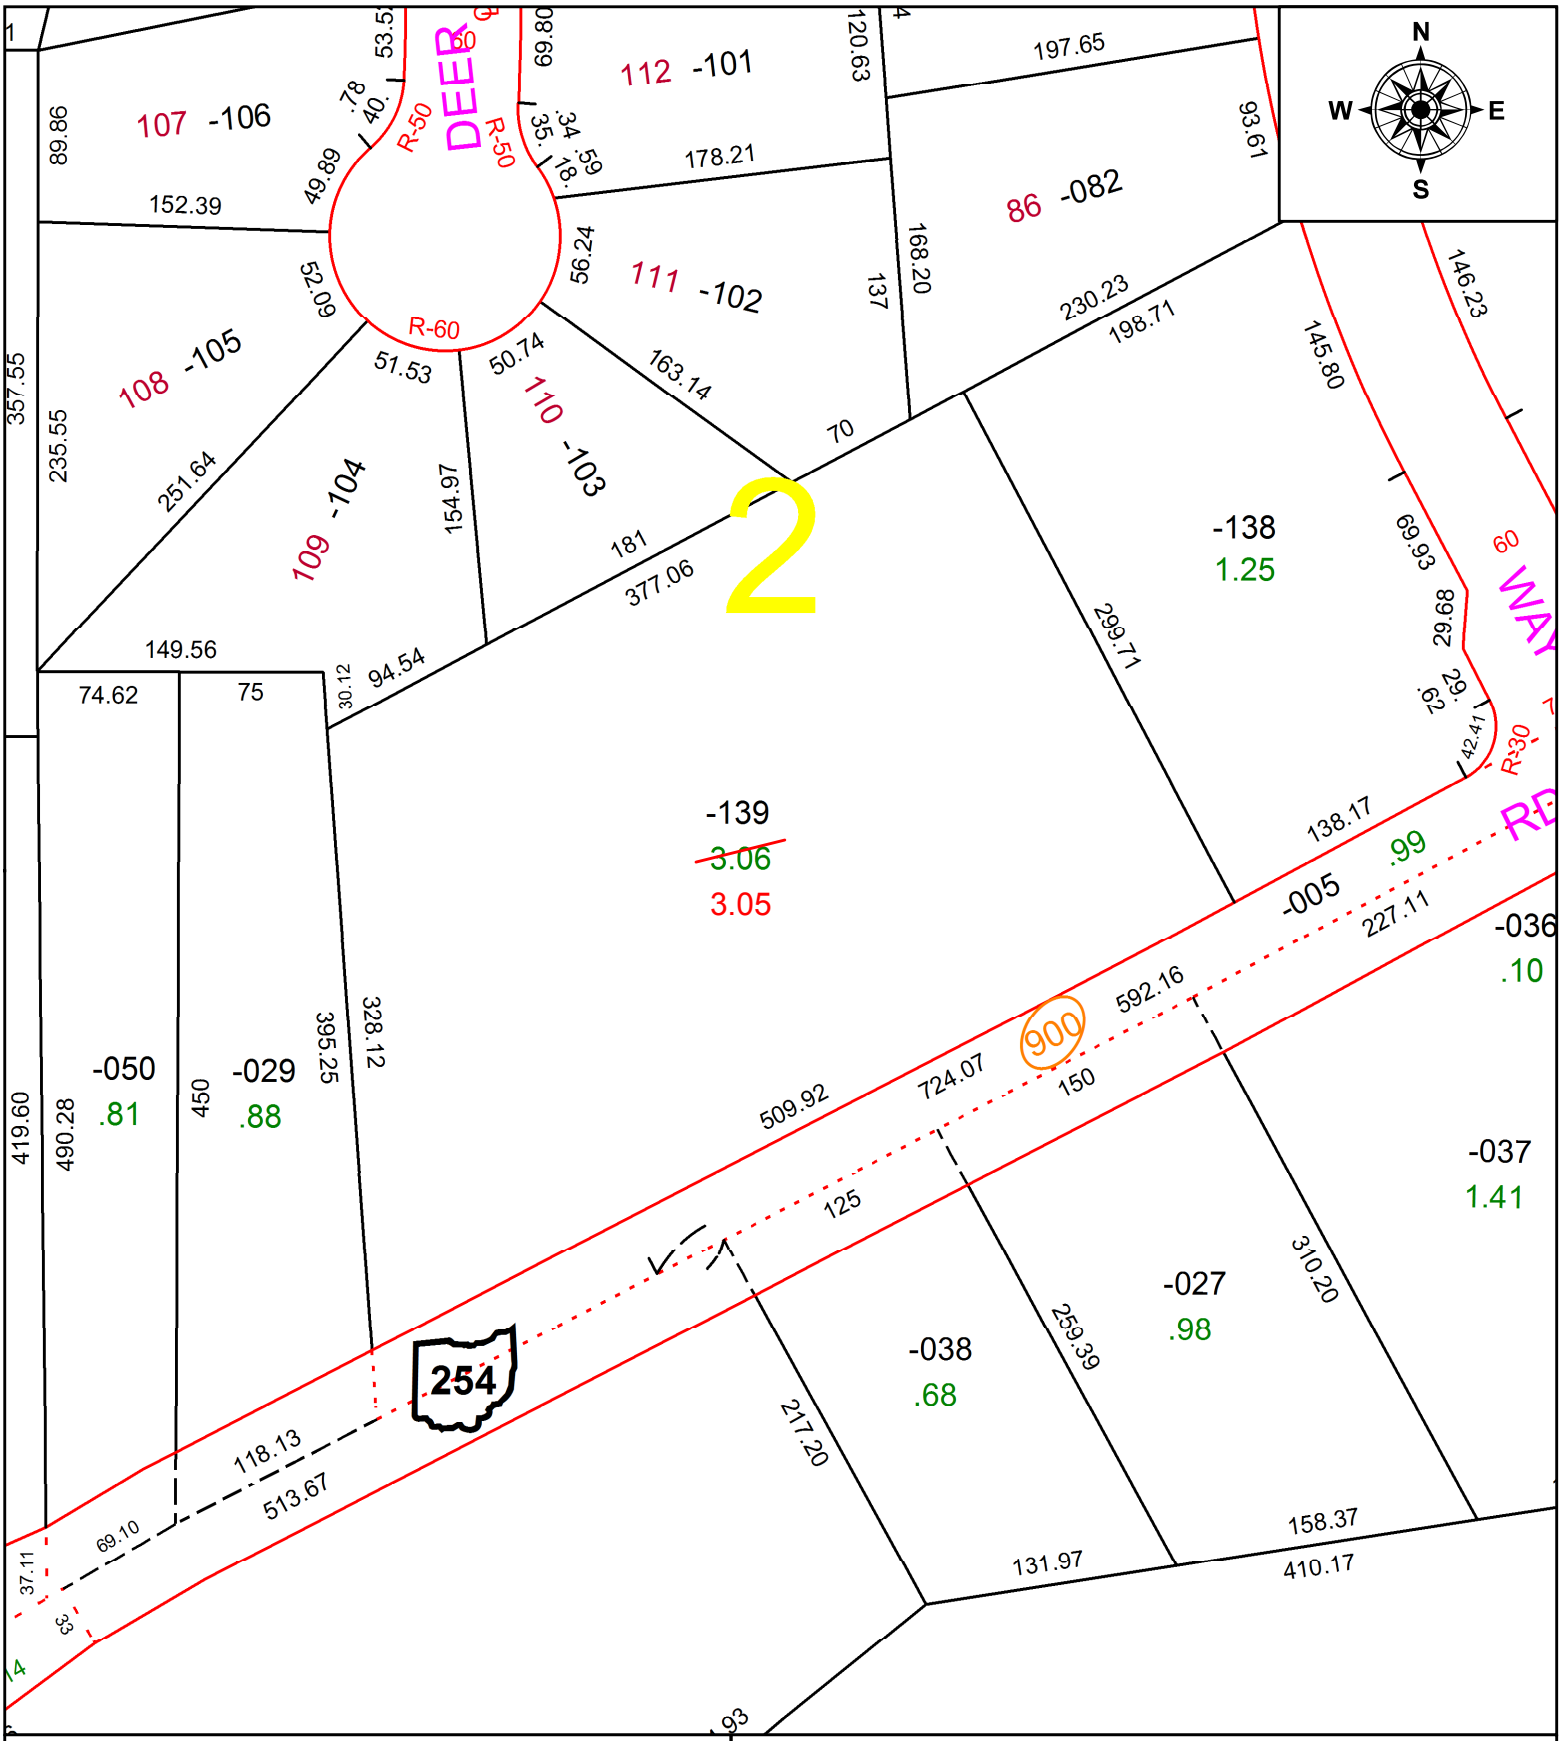

SPLITS/DEEDS PROCESSED

LORAIN COUNTY TAX MAP DEPARTMENT
226 MIDDLE AVE. ELYRIA, OH

SURVEYED BY: BRUCE ROBINSON
CLOSURE: N/A
MAP PAGE(S): 03-00-002
APPOVED BY: DMA **DATE:** 3/7/2022
SCALE: 1" = 100' **PRIOR INSTRUMENT:** 2019-0741204