PARENT PARCEL: 14-00-035-000-008

CHILD PARCEL: 14-00-035-000-009 & -010

STARTING POINT: SOUTHWEST CORNER OF O.L. 35

23-04804

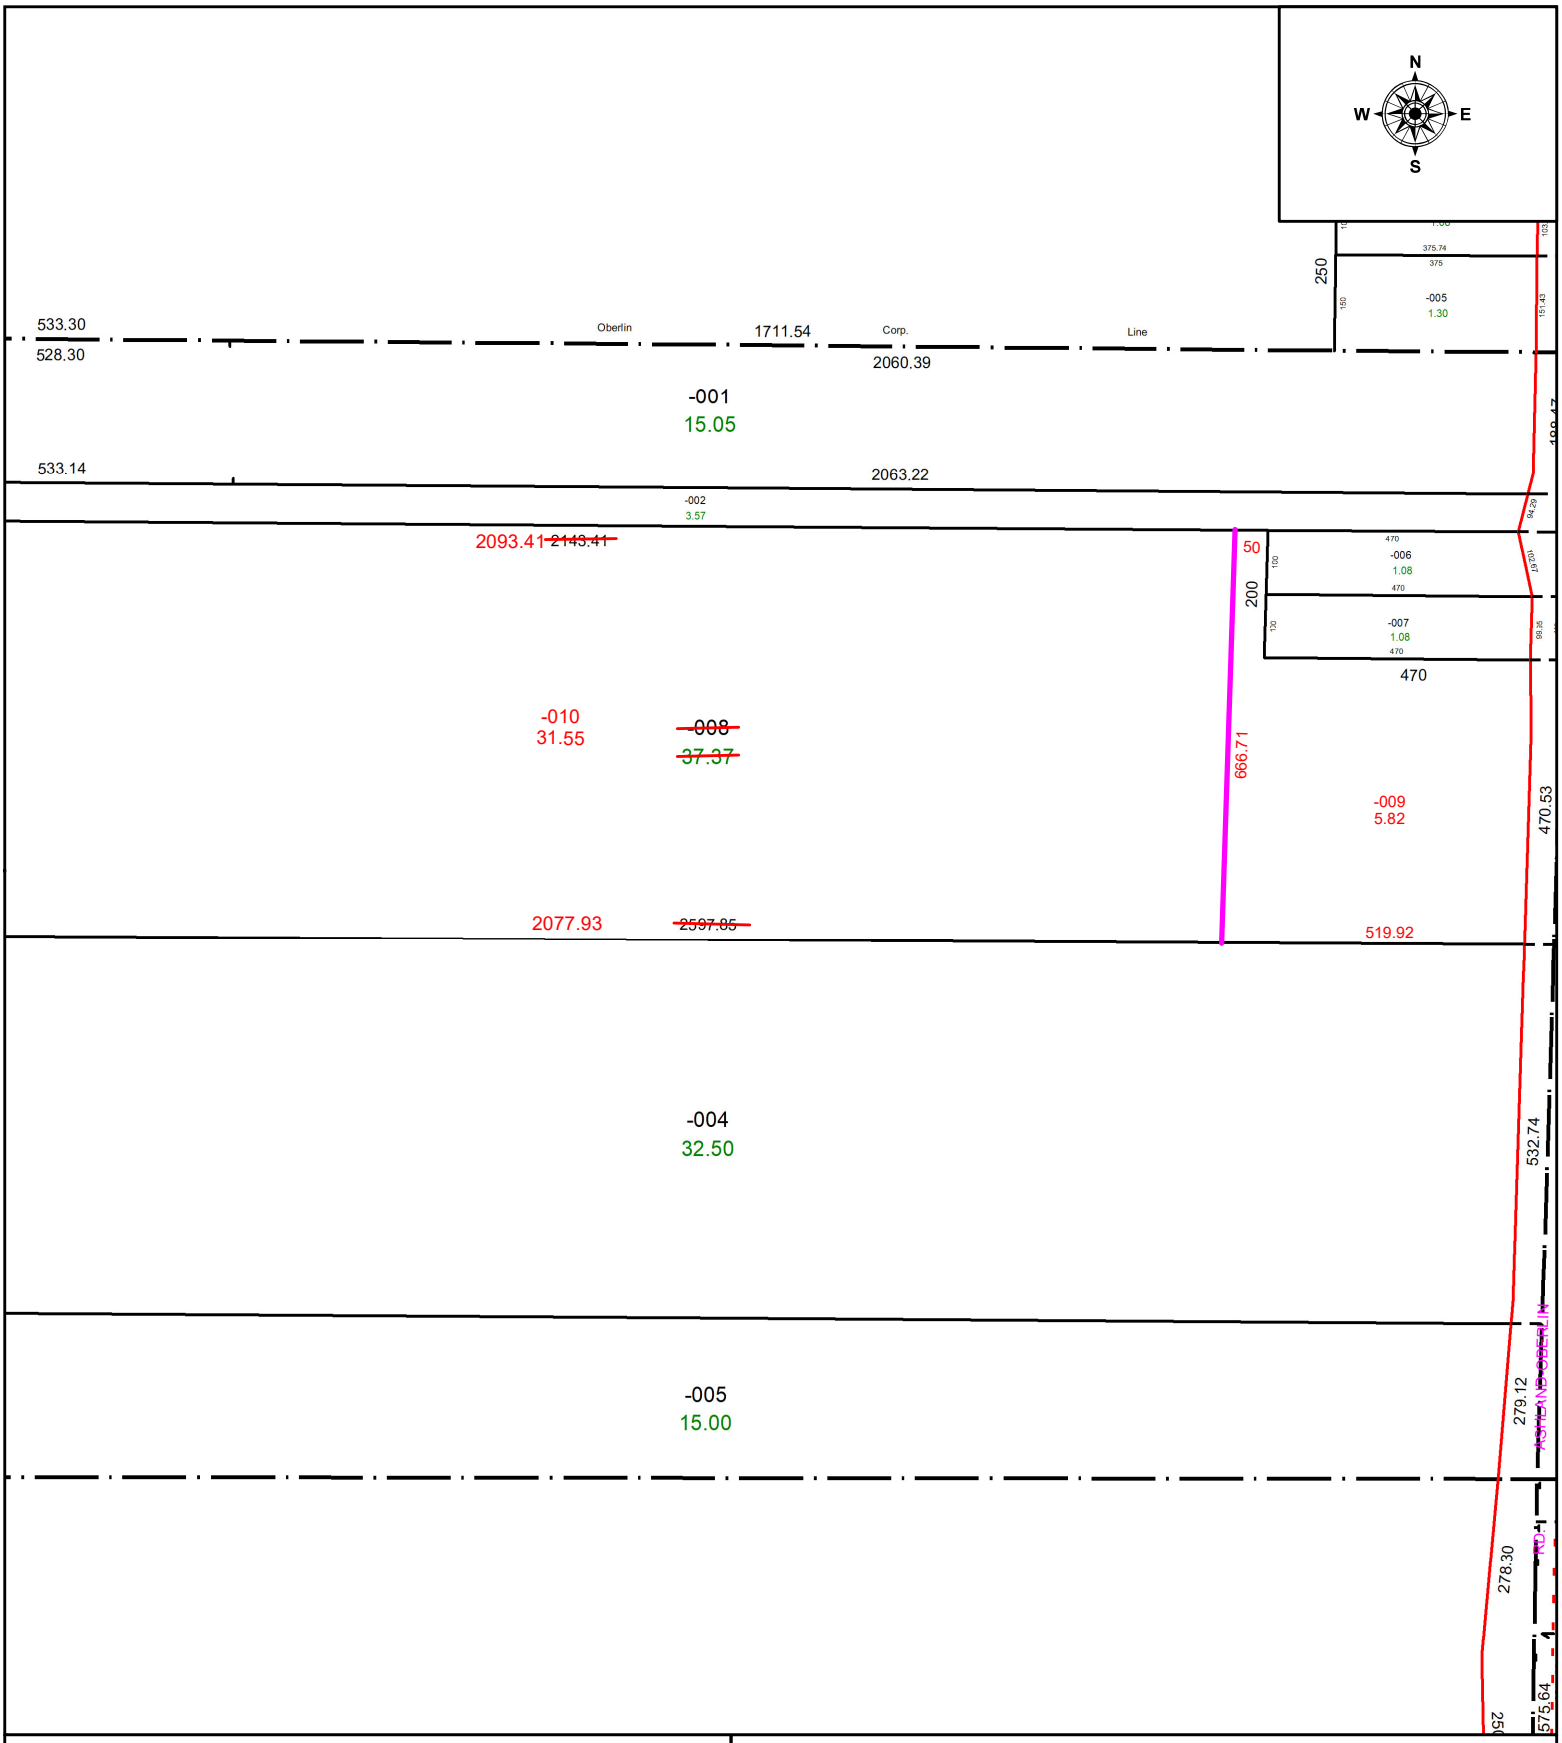

SPLITS/DEEDS PROCESSED

LORAIN COUNTY TAX MAP DEPARTMENT
226 MIDDLE AVE. ELYRIA, OH

SURVEYED BY: TIMOTHY HOZALSKI

SURVEY # 51097

CLOSURE: 1: 671015

MAP PAGE(S): 14-00-035

APPOVED BY: WRZ **DATE:** 1/4/2024

SCALE: 1" = 300 **PRIOR INSTRUMENT:** #2023-0907458