PARENT PARCEL: 16-00-049-000-009

CHILD PARCEL: 16-00-049-000-028 & -029

STARTING POINT: C/L OF MEDINA-ELYRIA AND COWLEY RD **AC CORR PER SURV BY RICHARD J. KOLE**

24-04805

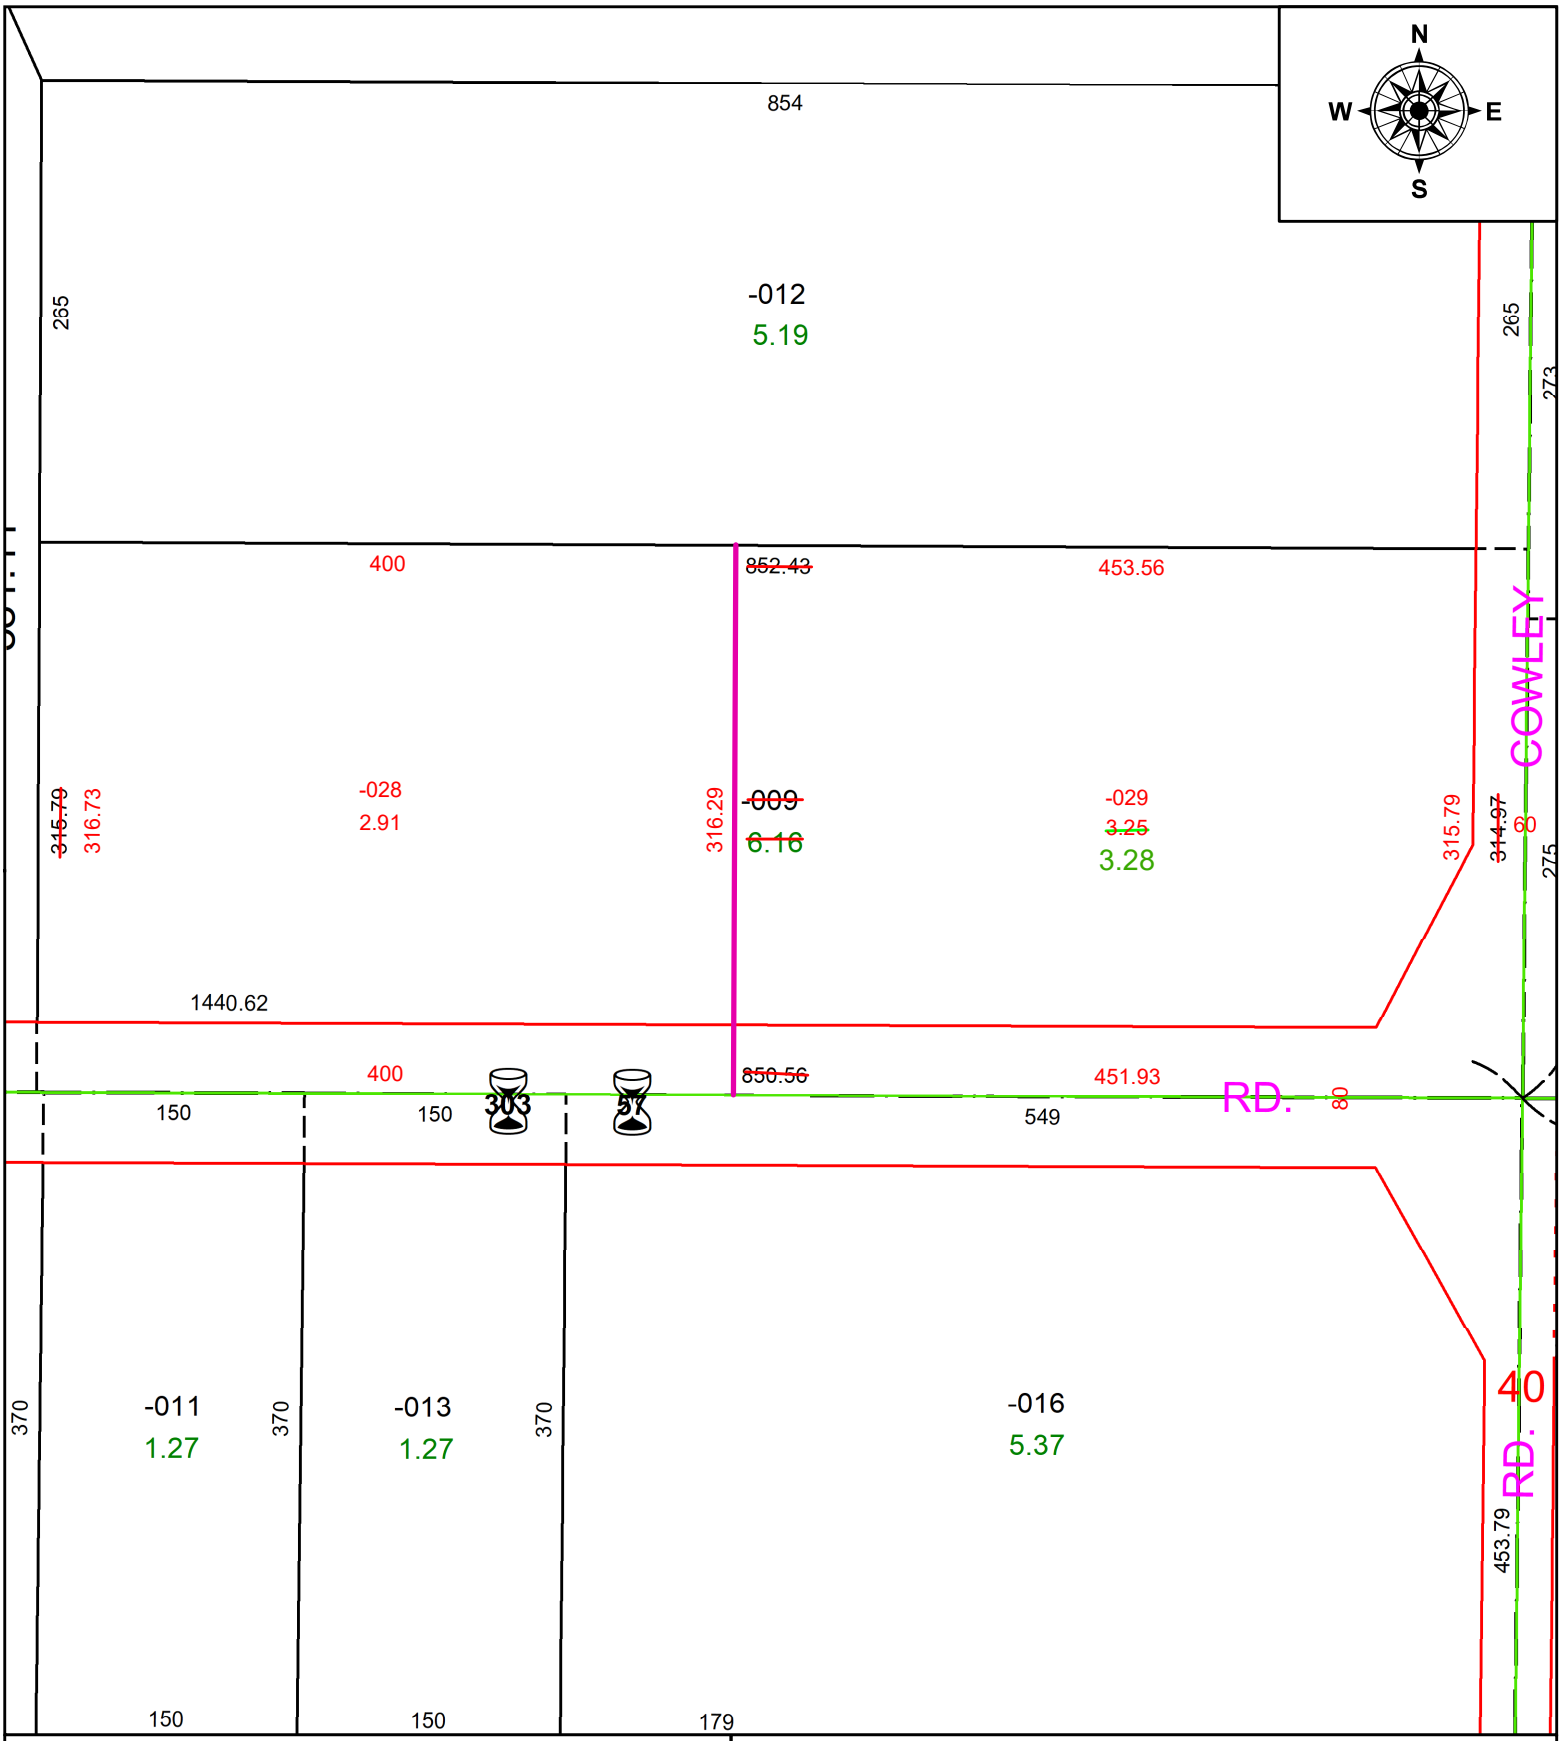

SPLITS/DEEDS PROCESSED

LORAIN COUNTY TAX MAP DEPARTMENT
226 MIDDLE AVE. ELYRIA, OH

SURVEYED BY: RICHARD J. KOLE **SURV # 51100**

CLOSURE: 1: 824463

MAP PAGE(S): 16-00-049

APPOVED BY: AC **DATE:** January 09, 2024

SCALE: 1 in = 110 ft **PRIOR INSTRUMENT:** 2022- 0859197