PARENT PARCEL: 14-00-096-000-028
CHILD PARCEL: 14-00-096-000-054 & -055
STARTING POINT: UNCOMBINATION PER PRIOR DEED

22-04806-C

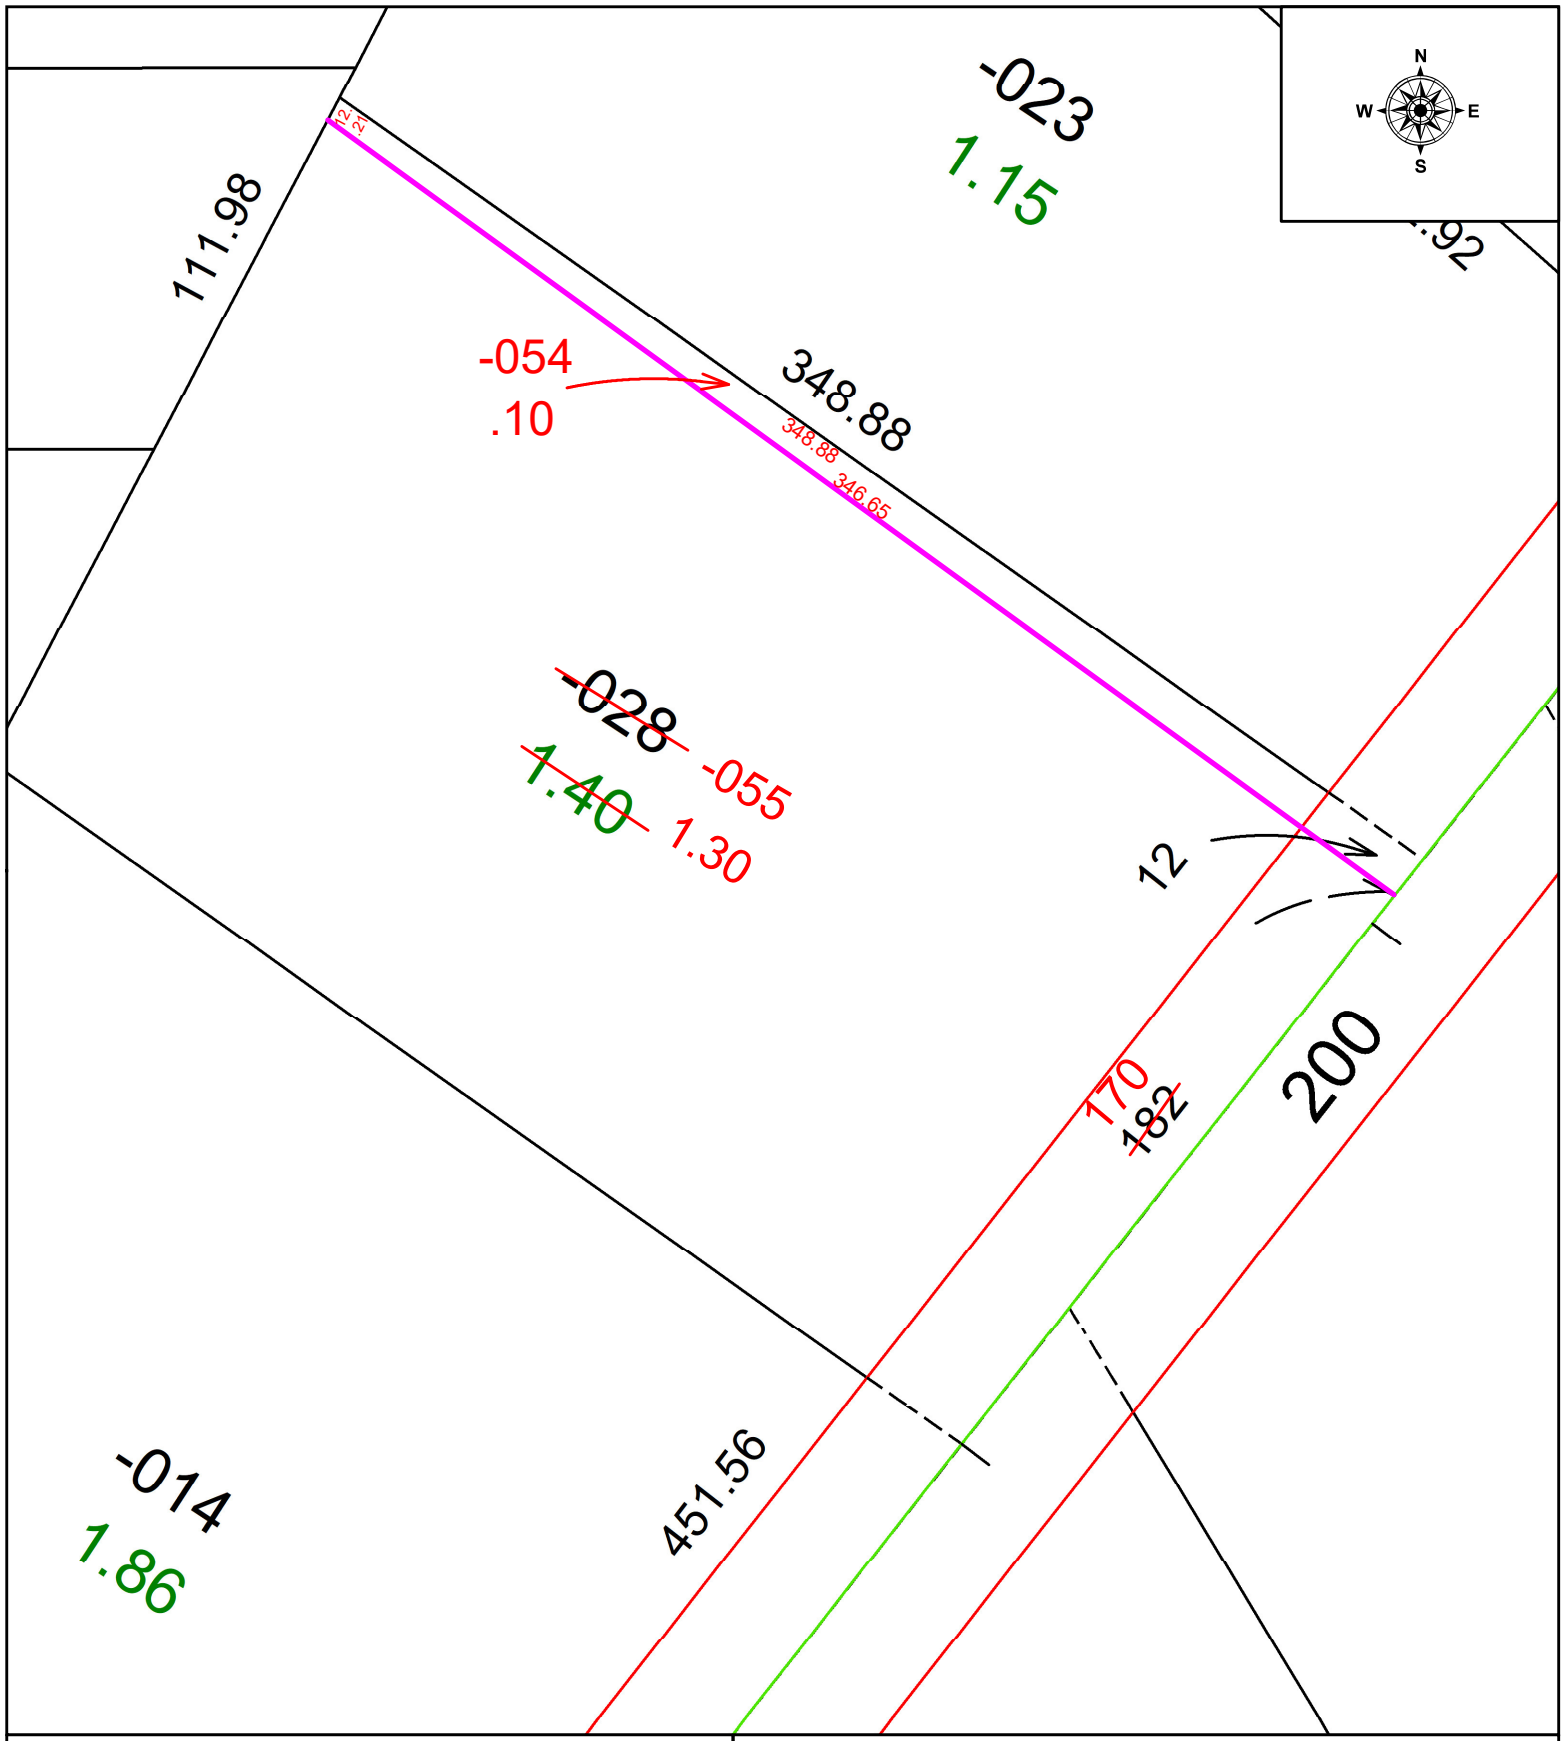

SPLITS/DEEDS PROCESSED
LORAIN COUNTY TAX MAP DEPARTMENT
226 MIDDLE AVE. ELYRIA, OH

SURVEYED BY: NEFF & ASSOCIATES INC.
CLOSURE: 1:148154
MAP PAGE(S): 14-00-096
APPOVED BY: WRZ **DATE:** 3/11/2022
SCALE: 1" = 50 **PRIOR INSTRUMENT:** 2007-0213780