PARENT PARCEL: 15-00-013-000-001

CHILD PARCEL: 15-00-013-000-032, -033, & -034 AC CORR PER SURVEYOR THOMAS SIMON

STARTING POINT: MONUMENT BOX @ NORTHWESTERLY CORNER OF O.L. 13

24-04807

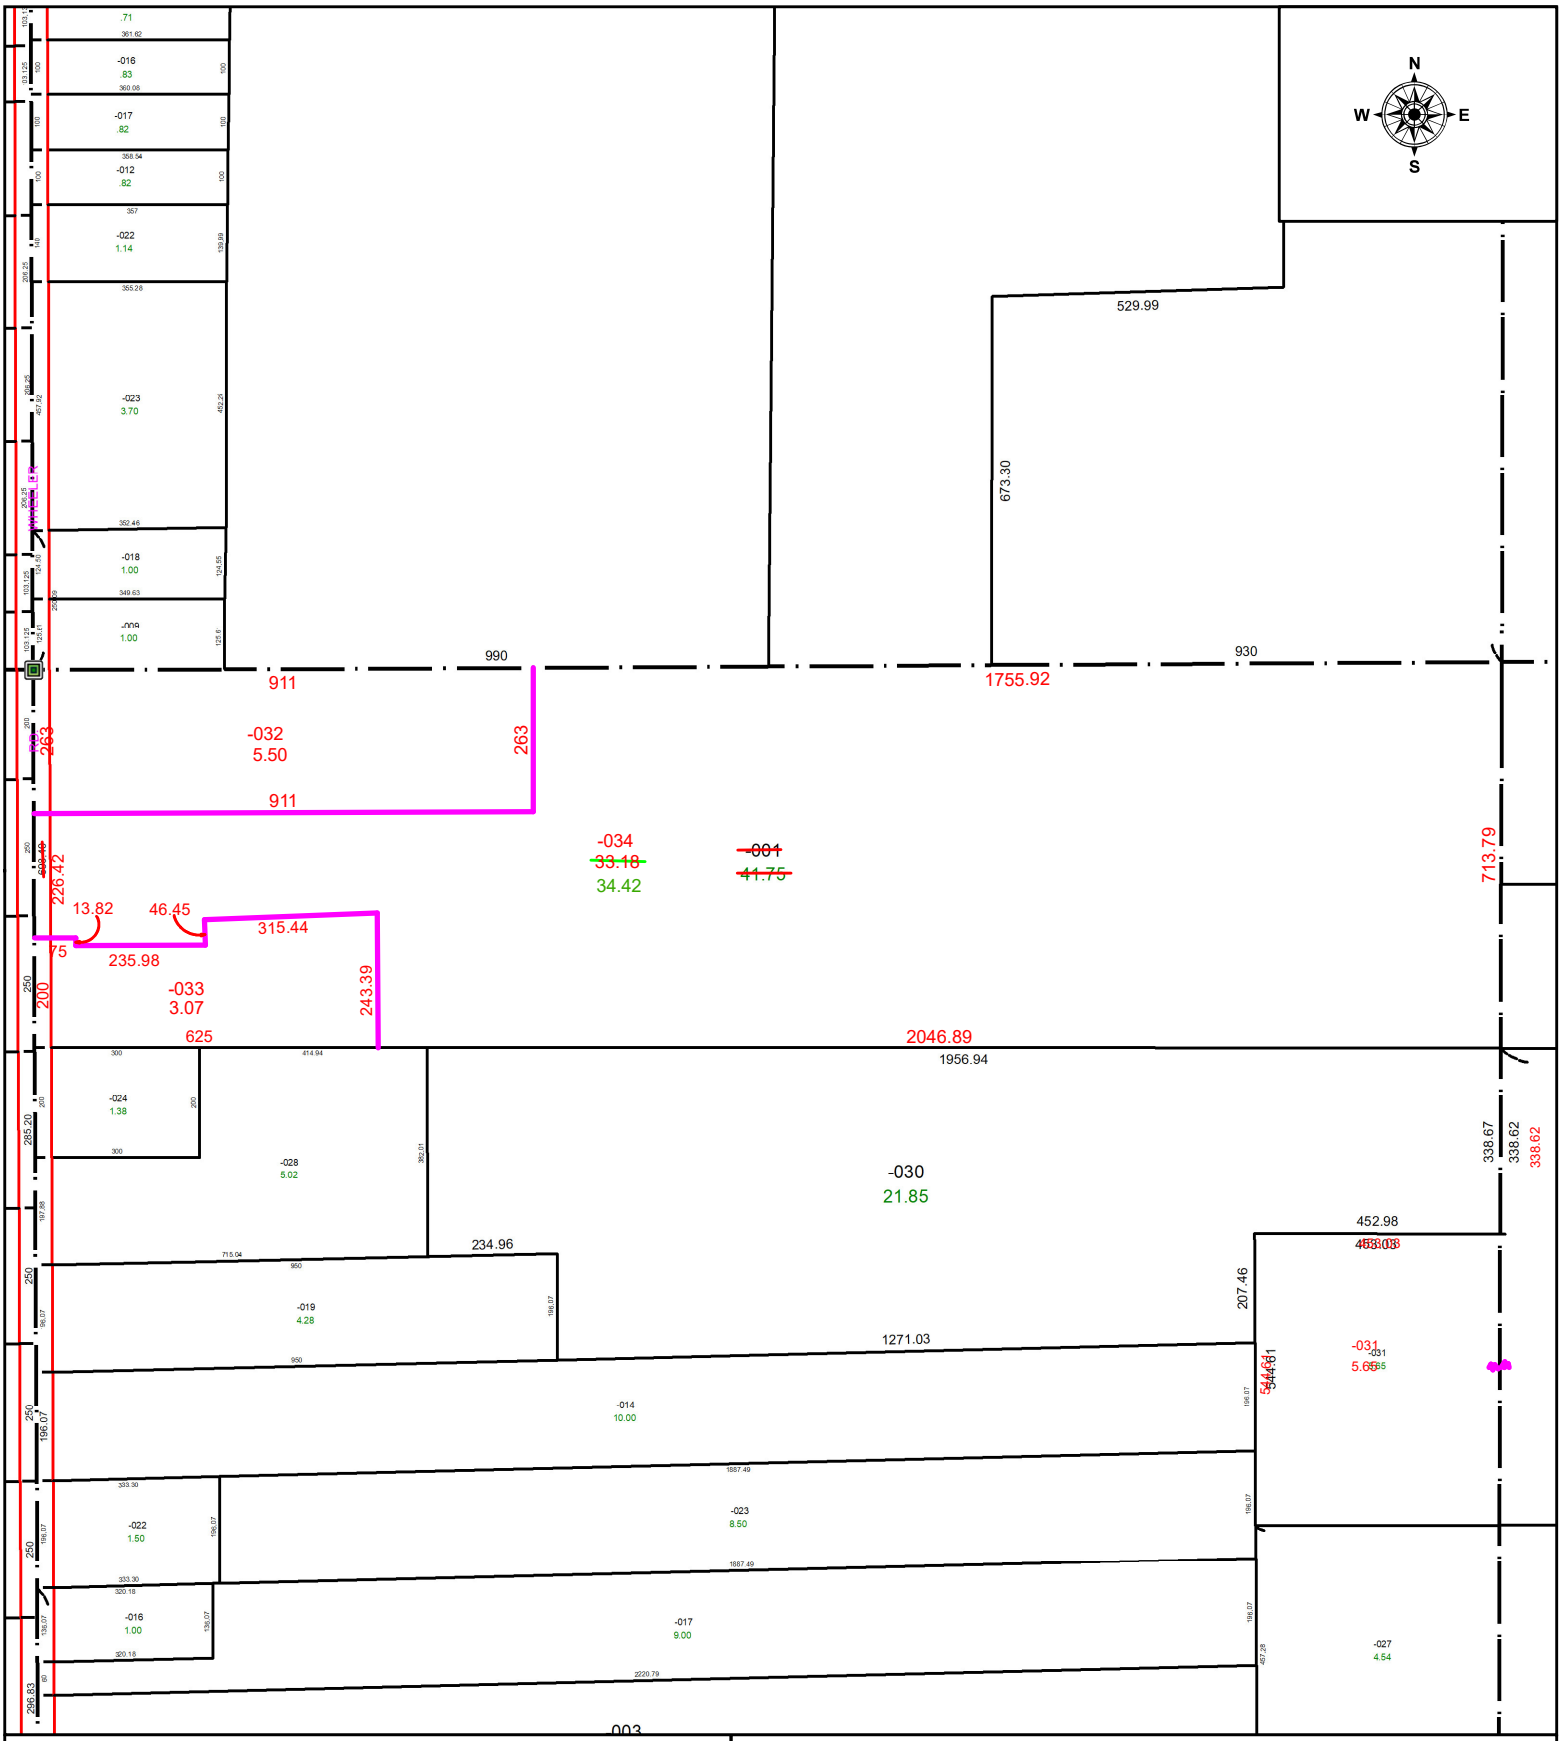

SPLITS/DEEDS PROCESSED

LORAIN COUNTY TAX MAP DEPARTMENT
226 MIDDLE AVE. ELYRIA, OH

SURVEYED BY: THOMAS SIMON SURVEY # 51103

CLOSURE: 1: INF

MAP PAGE(S): 15-00-013

APPOVED BY: WRZ **DATE:** 1/9/2024

SCALE: 1" = 350 **PRIOR INSTRUMENT:** #2023-003531