PARENT PARCEL: 19-05-047-000-009

CHILD PARCEL: 19-05-047-000-018 & -019 AC CORR PER SURVEYOR THOMAS SIMON

STARTING POINT: MONUMENT BOX @ INTERSECTION OF SHORT RD & VERMONT ST

24-04809

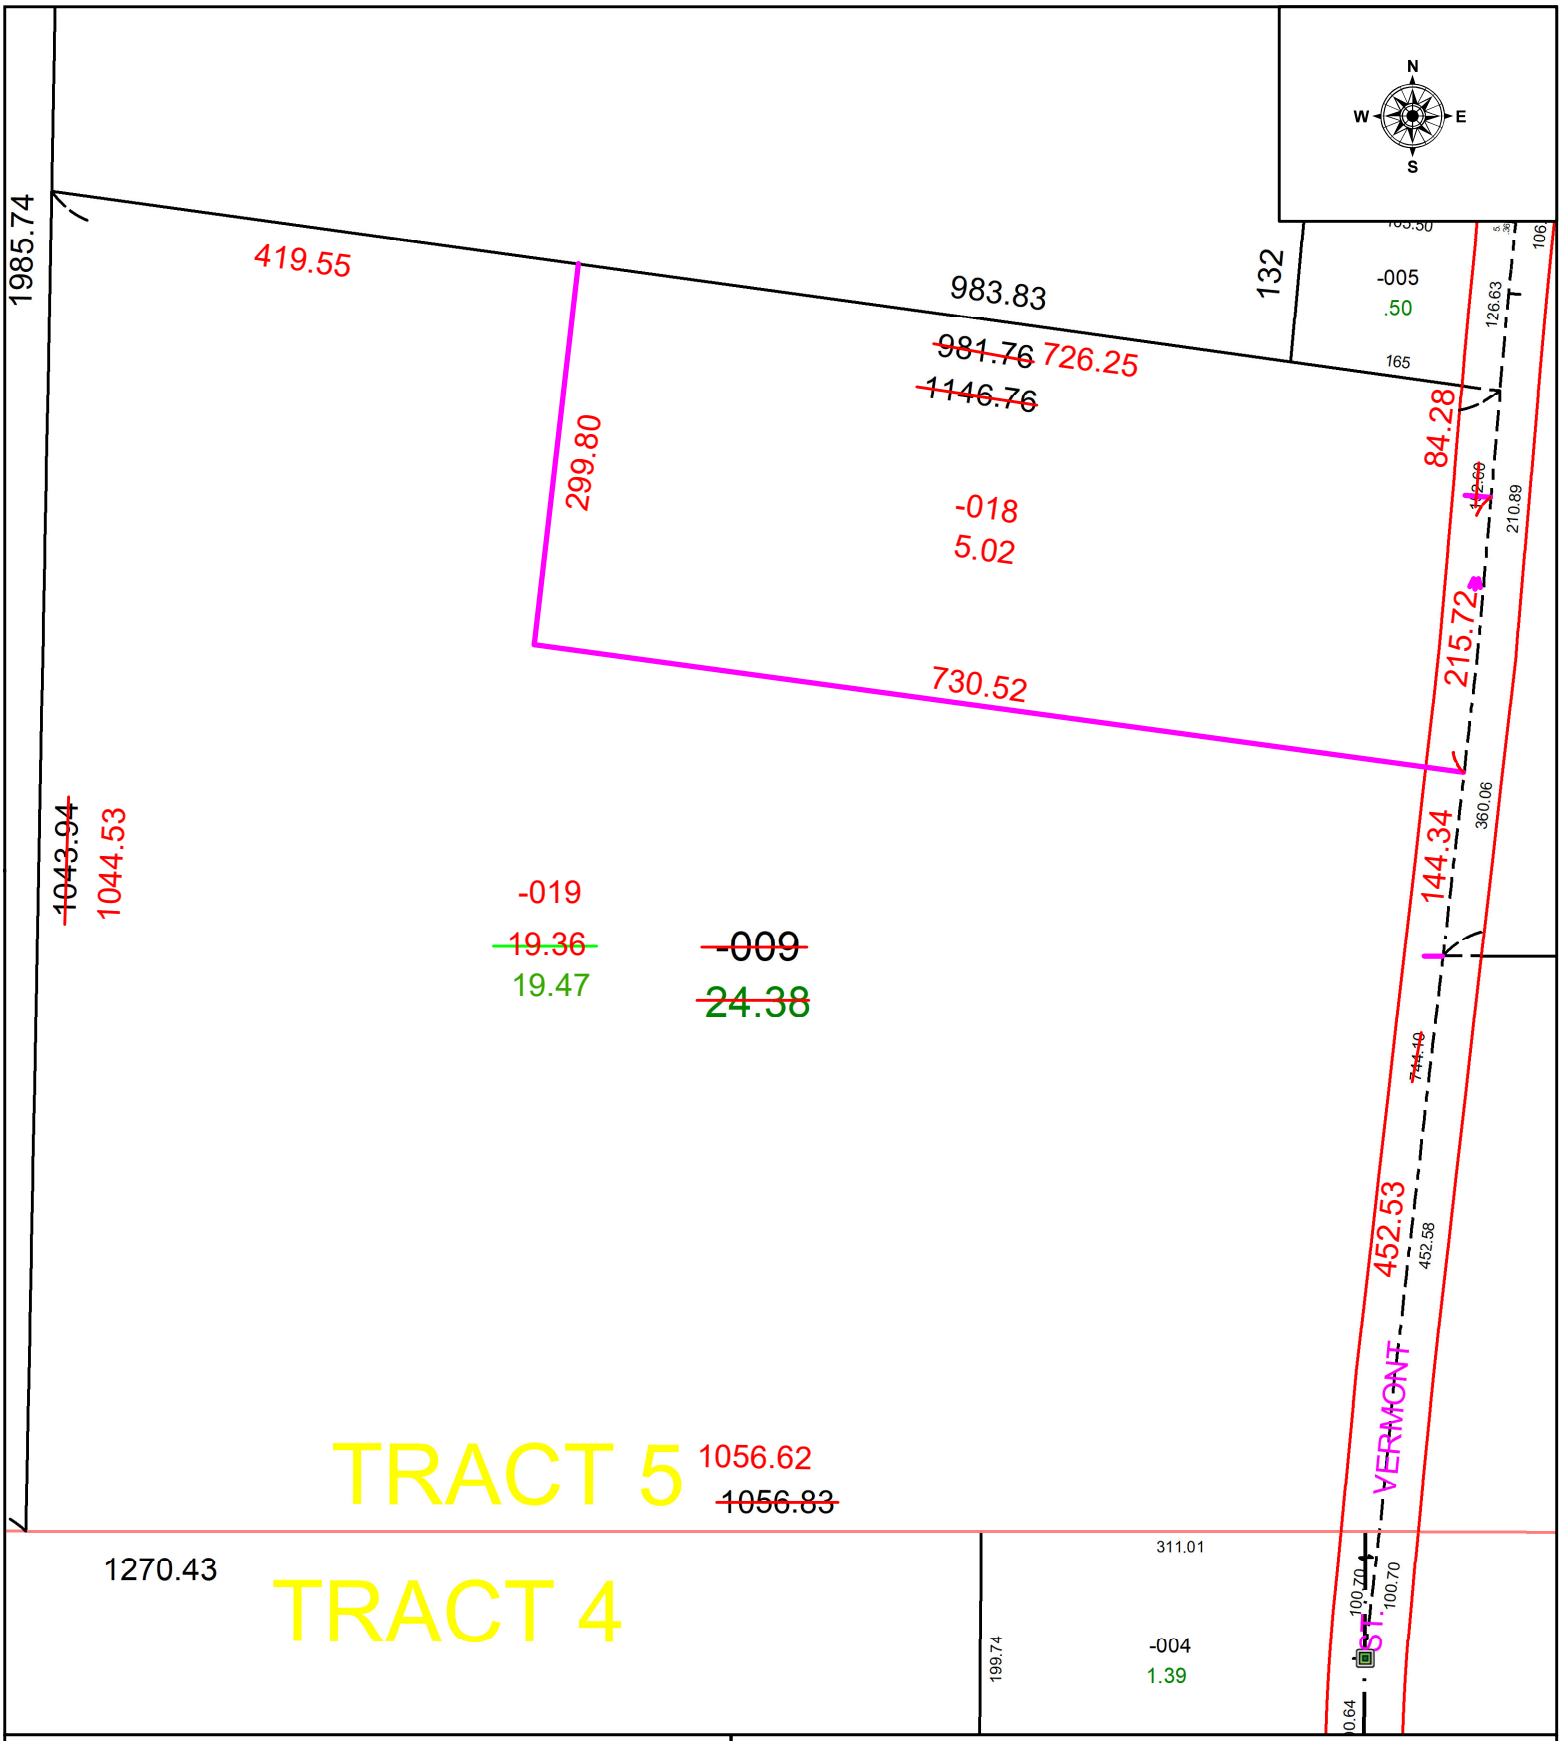

SPLITS/DEEDS PROCESSED

LORAIN COUNTY TAX MAP DEPARTMENT
226 MIDDLE AVE. ELYRIA, OH

SURVEYED BY: THOMAS SIMON SURVEY # 51107
CLOSURE: 1: 458459
MAP PAGE(S): 19-05-047
APPOVED BY: WRZ **DATE:** 1/12/2024
SCALE: 1" = 150 **PRIOR INSTRUMENT:** #2022-0898477