PARENT PARCEL: 11-00-092-000-078 **AC CORR PER SURV BY THOMAS A. SIMON**

CHILD PARCEL: 11-00-092-000-095, 11-00-093-101-083

STARTING POINT: C/L OF DURKEE RD AND BUTTERNUT RIDGE RD

22-04811-A

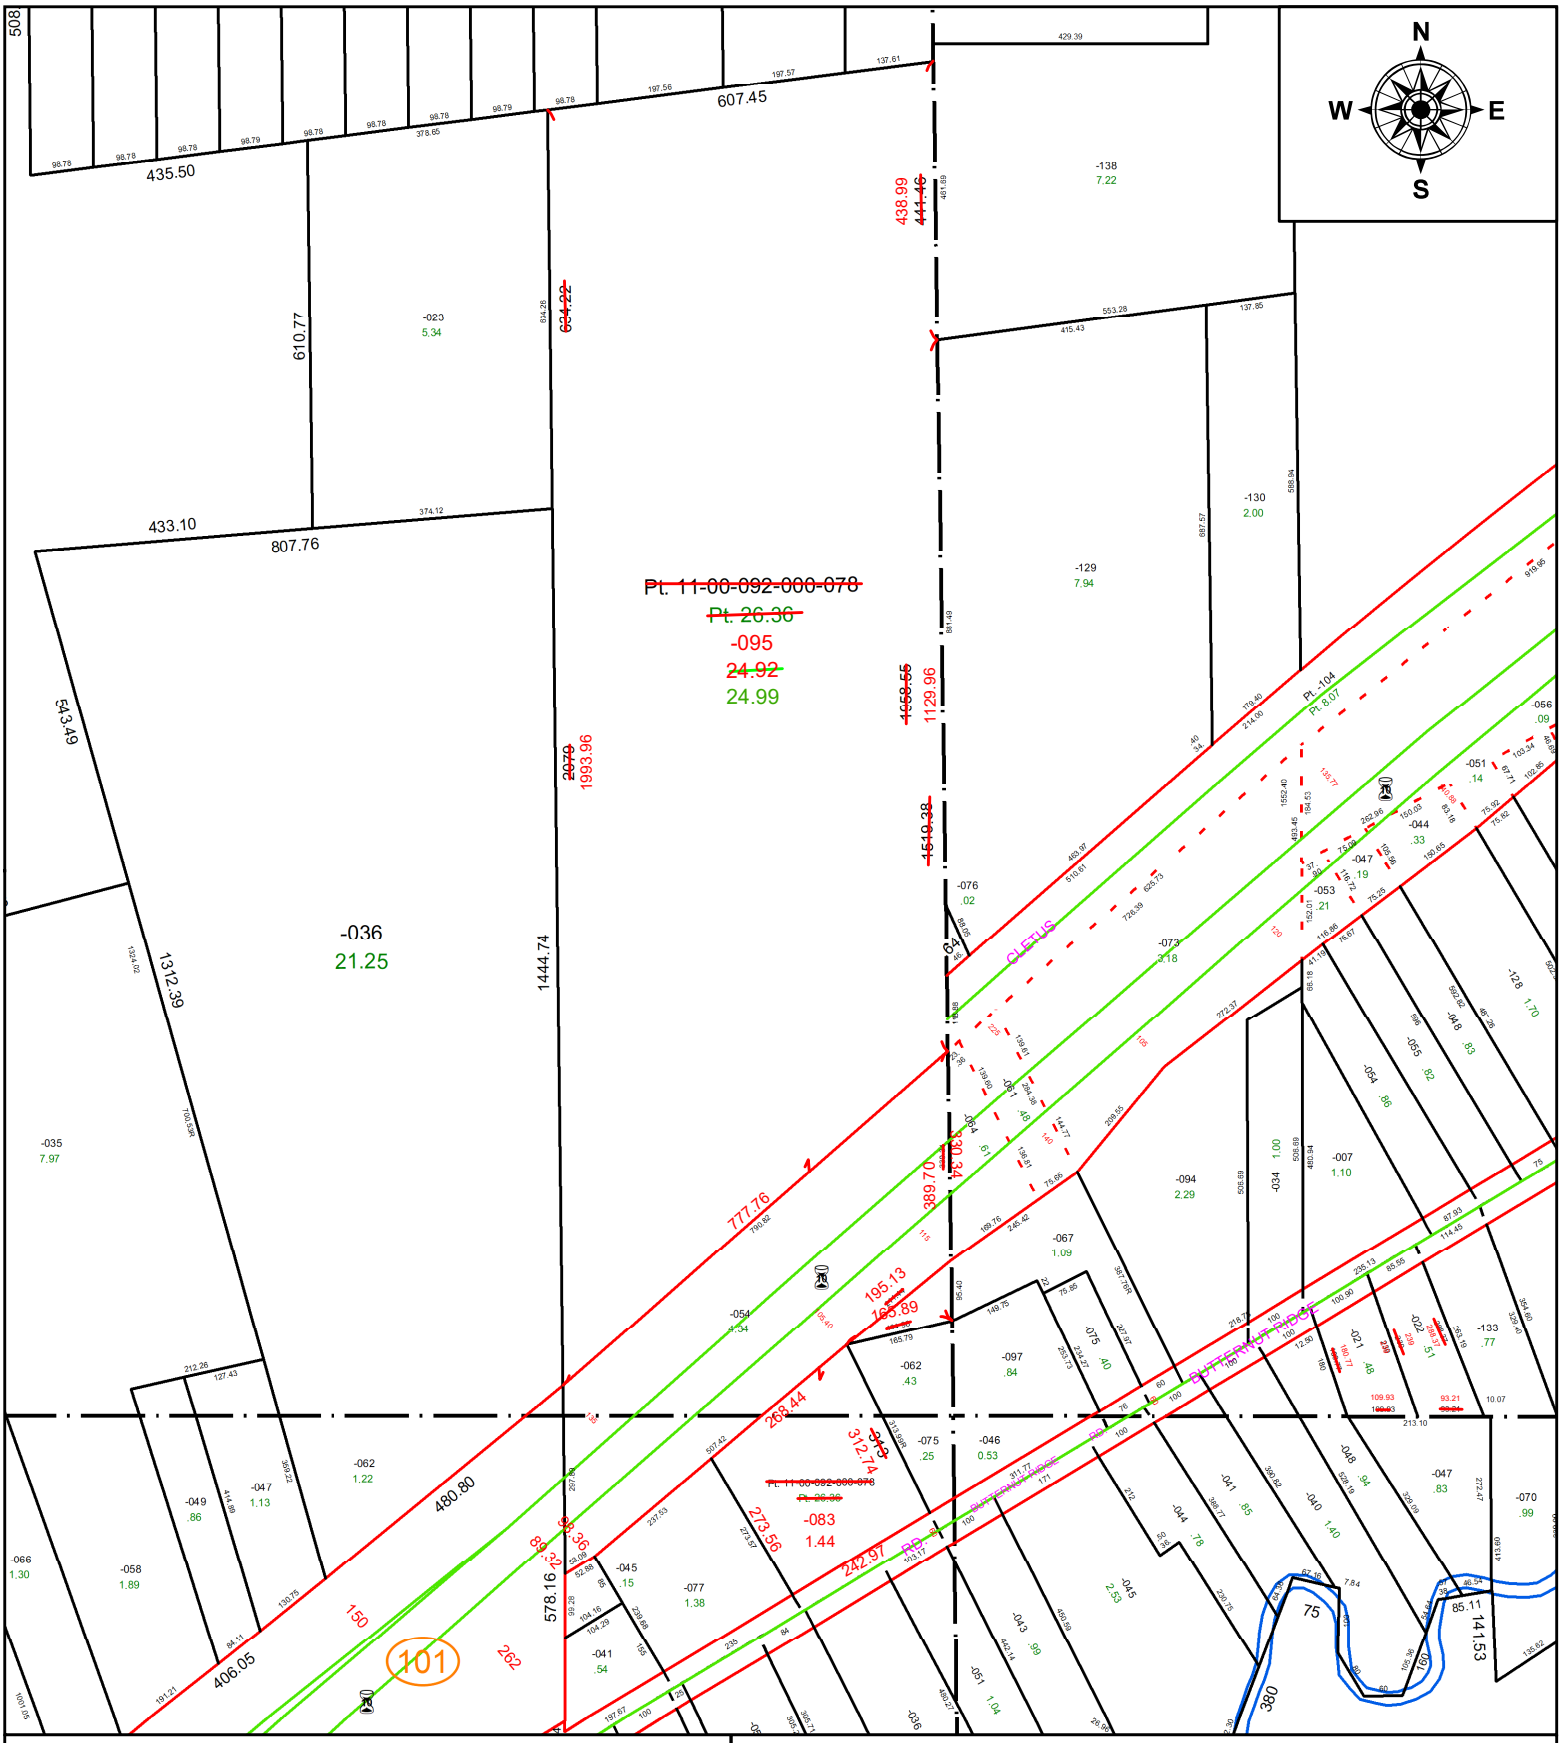

SPLITS/DEEDS PROCESSED

LORAIN COUNTY TAX MAP DEPARTMENT
226 MIDDLE AVE. ELYRIA, OH

SURVEYED BY: THOMAS A. SIMON
CLOSURE: 1: 515675
MAP PAGE(S): 11-00-092
APPOVED BY: AC **DATE:** 3/16/2022
SCALE: 1" = 300 **PRIOR INSTRUMENT:** 2017- 0650393