**PARENT PARCEL:** 21-12-000-000-103 AC. CORR. FROM 12.87 A. TO 12.86 A.

**CHILD PARCEL:** XX-XX-XXX-XXX-XXX

**STARTING POINT:** 2" IRON DISK MON, BOX, CL OF BURSLEY RD. & CL OF HAWLEY RD.

# 22-04812-A

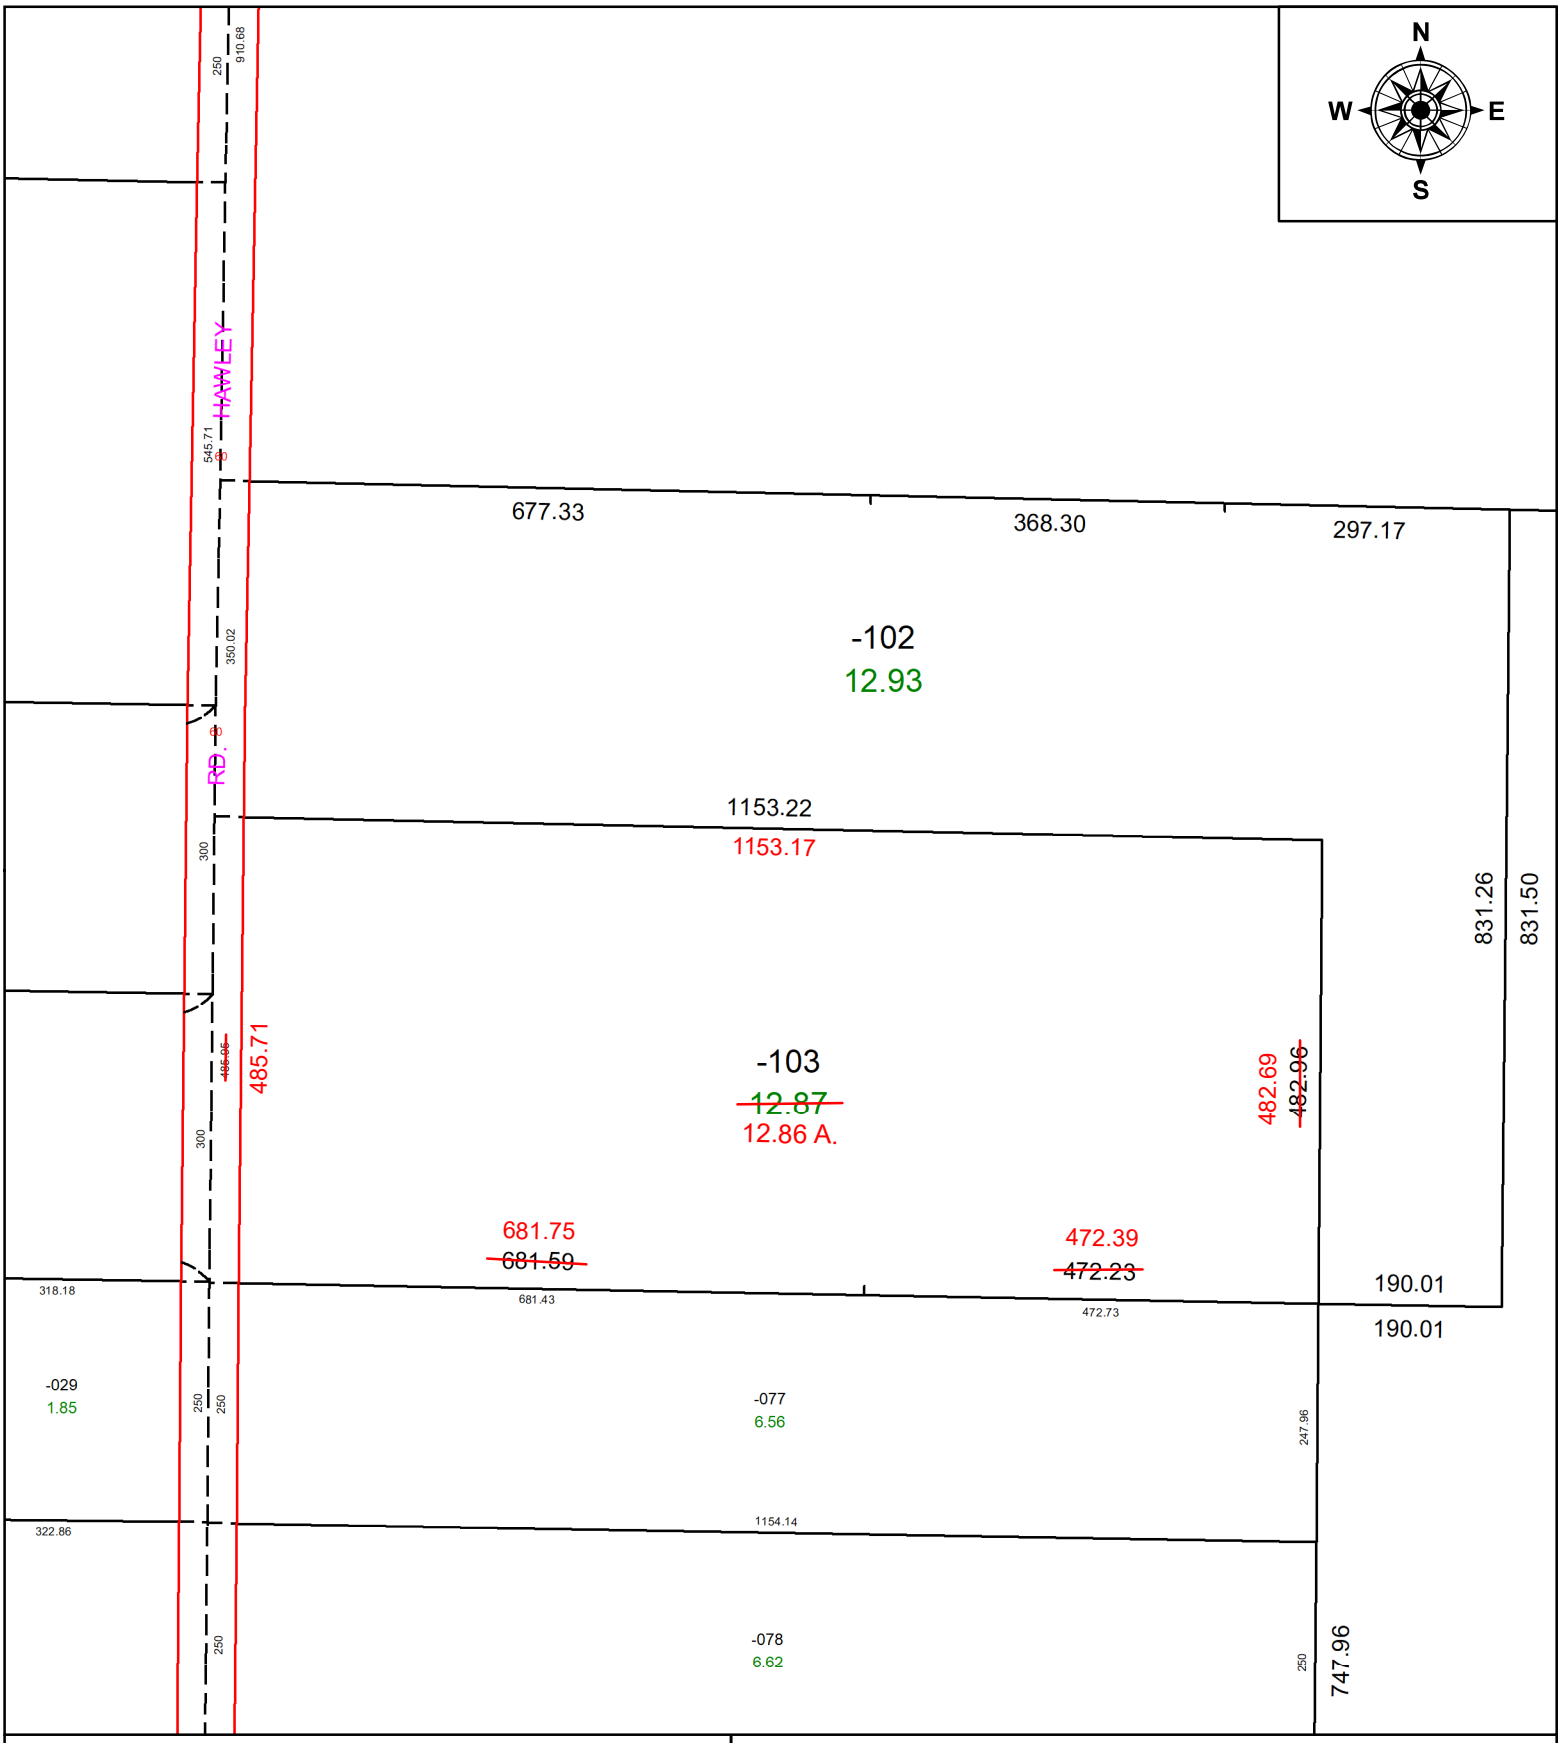


**SPLITS/DEEDS PROCESSED**

LORAIN COUNTY TAX MAP DEPARTMENT
226 MIDDLE AVE. ELYRIA, OH

**SURVEYED BY:** SCOTT J. CASEY
**CLOSURE:** 1: 33,000
**MAP PAGE(S):** 21-12-000
**APPOVED BY:** TJS **DATE:** 3/21/22
**SCALE:** 1" = 200 **PRIOR INSTRUMENT:** 2022-0857272