PARENT PARCEL: 04-00-014-105-068

CHILD PARCEL: 04-00-014-105-074 & -075 AC CORR PER SURVEYOR AMY KELLY

STARTING POINT: MAG NAIL @ INTERSECTION OF C/LS OF CENTER RD & KINZEL RD

24-04812

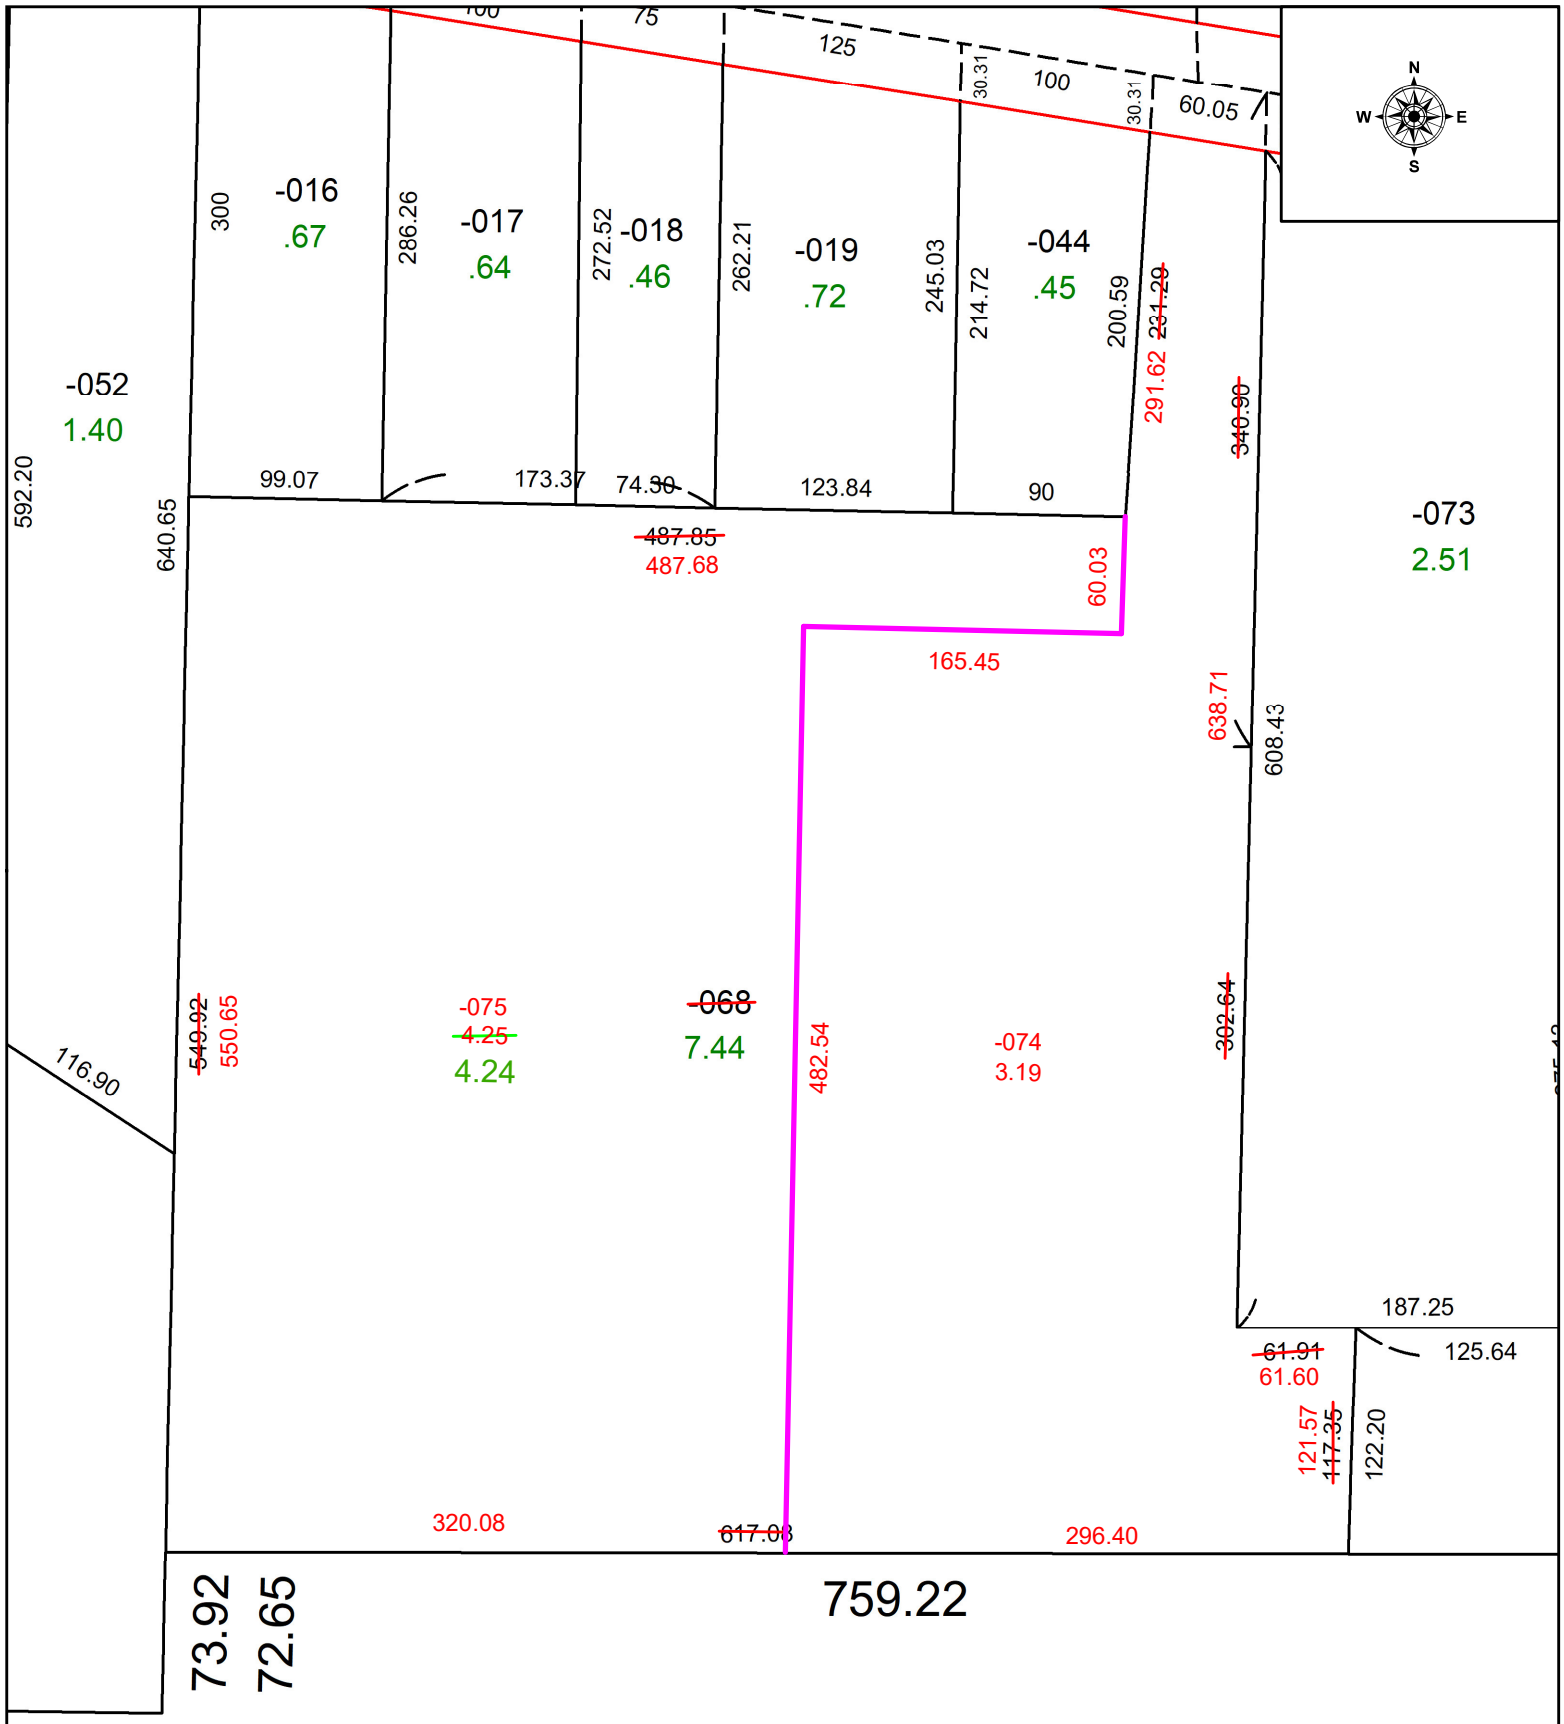

SPLITS/DEEDS PROCESSED

LORAIN COUNTY TAX MAP DEPARTMENT
226 MIDDLE AVE. ELYRIA, OH

SURVEYED BY: AMY KELLY SURVEY # 51114

CLOSURE: 1: 2247104

MAP PAGE(S): 04-00-014

APPOVED BY: WRZ **DATE:** 1/24/2024

SCALE: 1" = 100 **PRIOR INSTRUMENT:** #2015-0555508