PARENT PARCEL: 06-24-017-101-003, -007, & 06-24-018-000-033

CHILD PARCEL: 06-24-017-101-013 THRU -015 & 06-24-018-000-037 THRU -039

STARTING POINT: CL OF TELEGRAPH RD. (S.R. 113) & CL OF WEST RIDGE RD.

24-04815

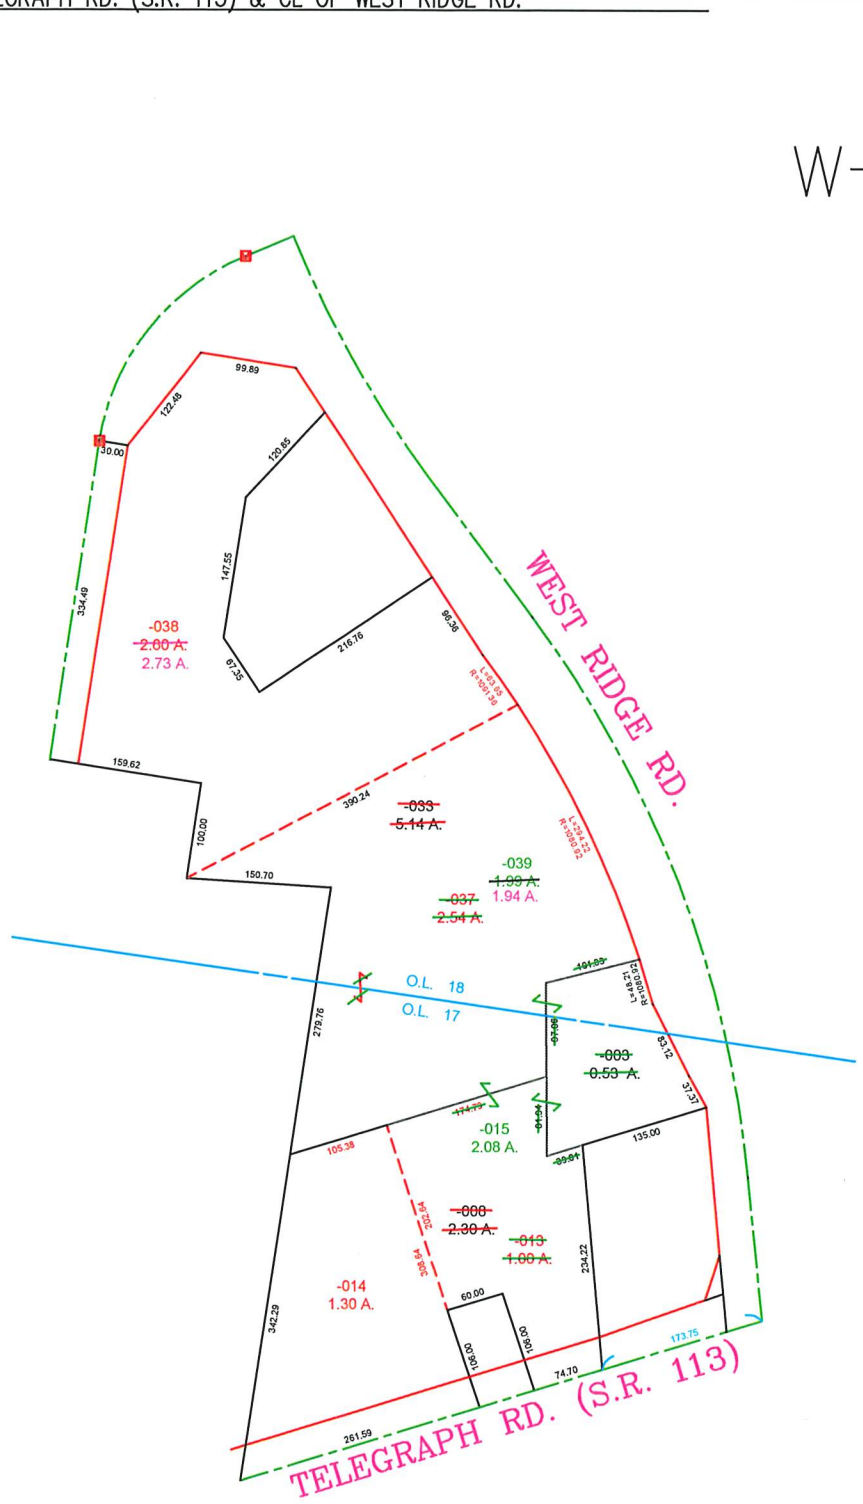

SPLITS/DEEDS PROCESSED

LORAIN COUNTY TAX MAP DEPARTMENT

226 MIDDLE AVE. ELYRIA, OHIO

SURVEYED BY: T. SIMON

CLOSURE: 1:217963

MAP PAGE(S): 06-24-017 & -018

APPROVED BY: TJS DATE: 3/1/2024

SCALE: 1"= 200 PRIOR INSTRUMENT: OR 2233/367