PARENT PARCEL: 04-00-005-000-131 & ADD TO DUP. 04-00-005-000-132

CHILD PARCEL: 04-00-005-000-133

STARTING POINT: CL OF MILLER RD. & CL OF WALKER RD. ,POINT BEING N89°46'58"E 17.75' FROM A 1" I.P. FD. IN MON. BOX

24-04817

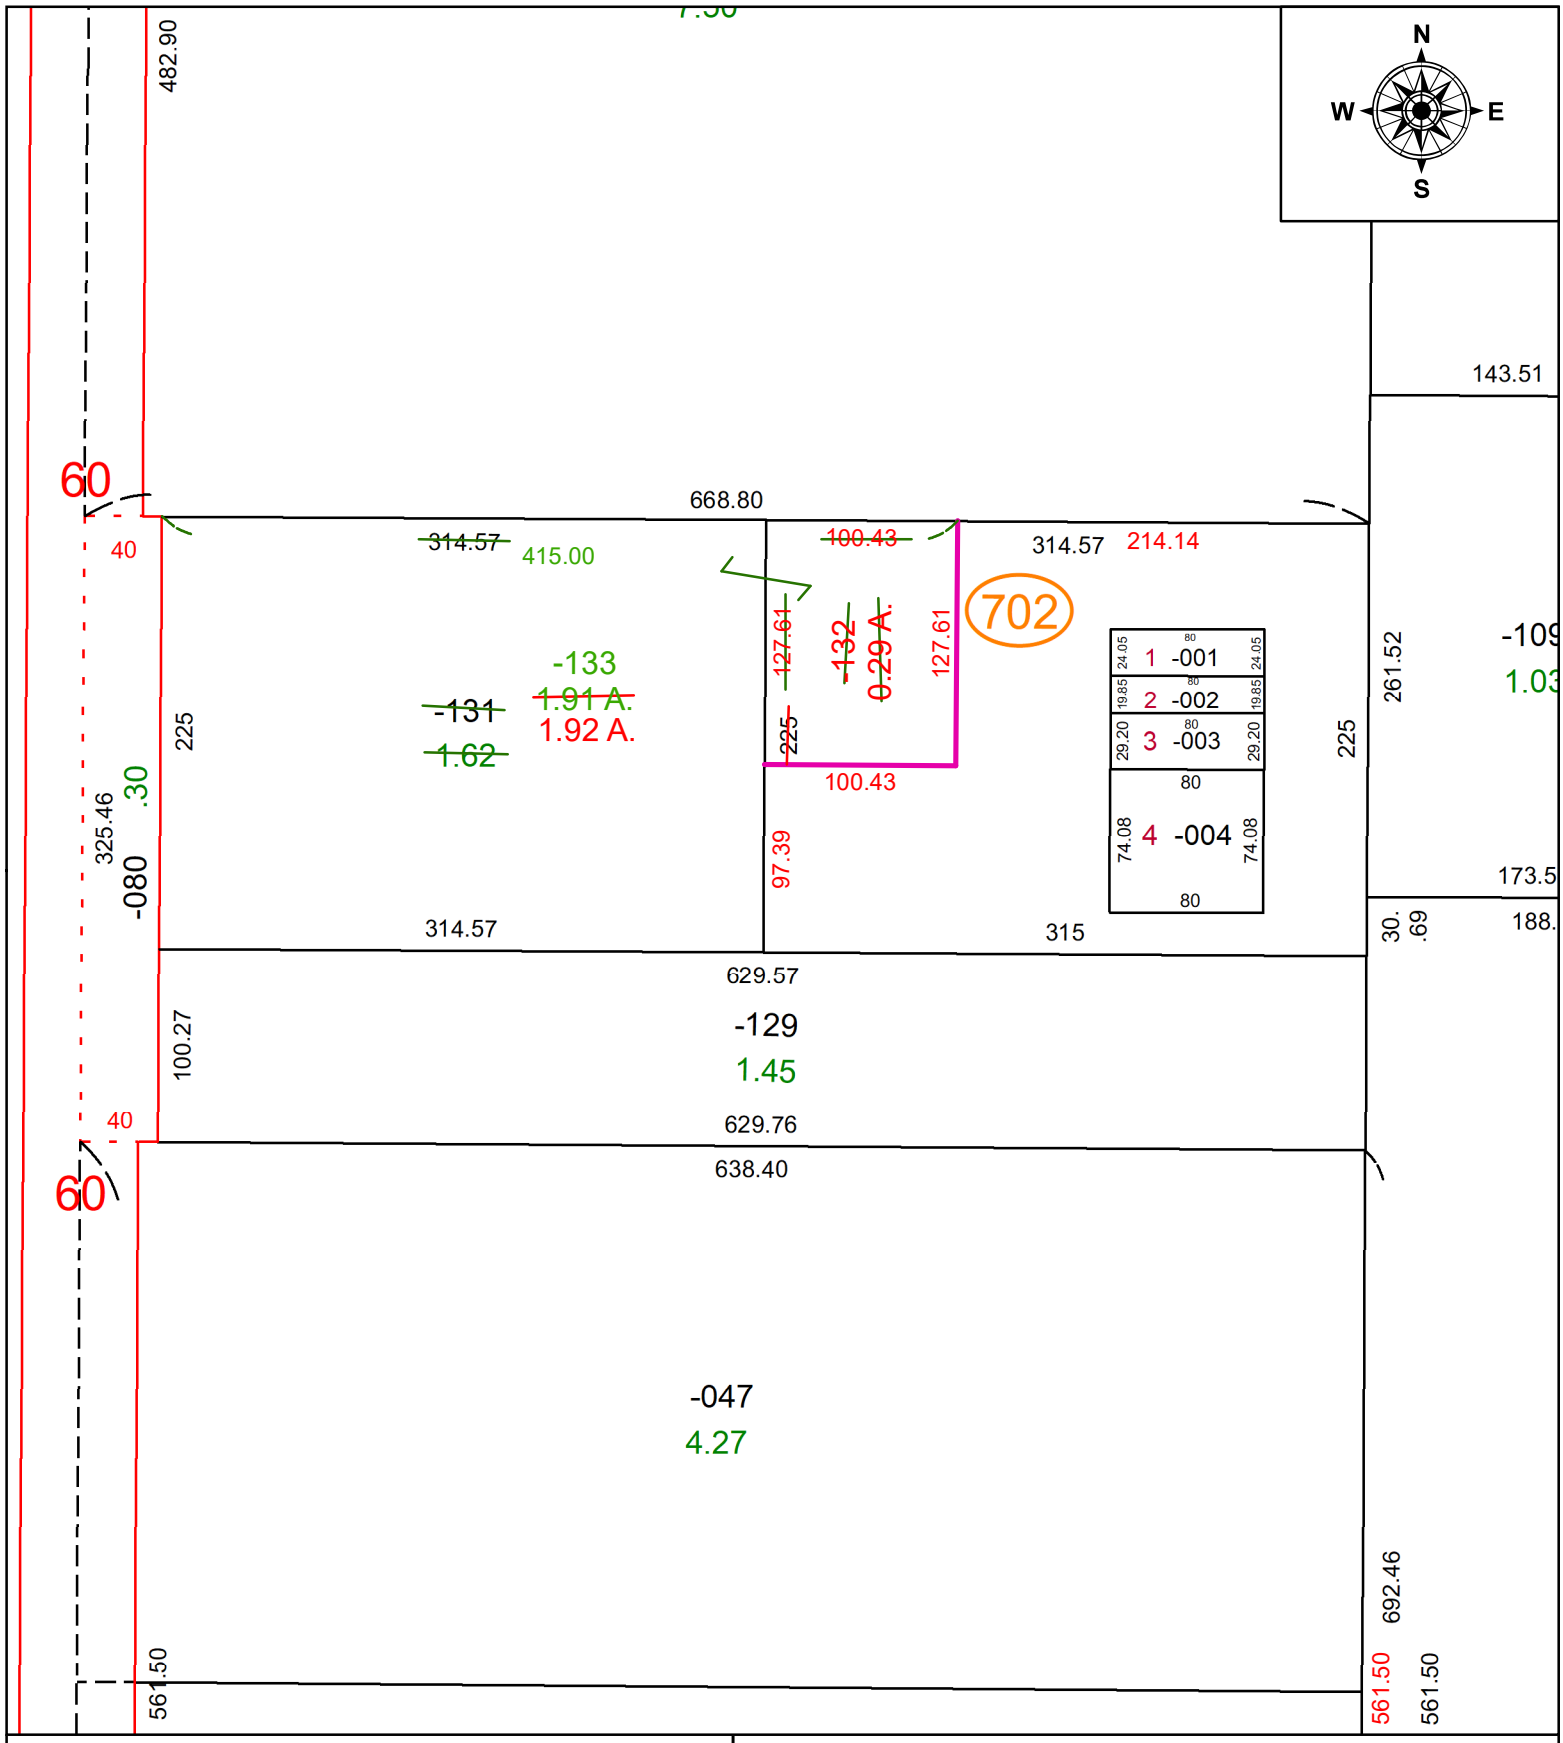

SPLITS/DEEDS PROCESSED

LORAIN COUNTY TAX MAP DEPARTMENT
226 MIDDLE AVE. ELYRIA, OH

SURVEYED BY: AMY KELLY
CLOSURE: 1: INF
MAP PAGE(S): 04-00-005
APPOVED BY: TJS **DATE:** 2/13/2024
SCALE: 1" = 100' **PRIOR INSTRUMENT:** PV. 111 PG. 23