PARENT PARCEL: 02-01-007-102-050 & -02-01-008-102-013, -014, -022, -025

CHILD PARCEL: 02-01-008-102-026 thru -028

STARTING POINT: C/L OF WASHINGTON AVE & NORTH RIDGE RD.

24-04818

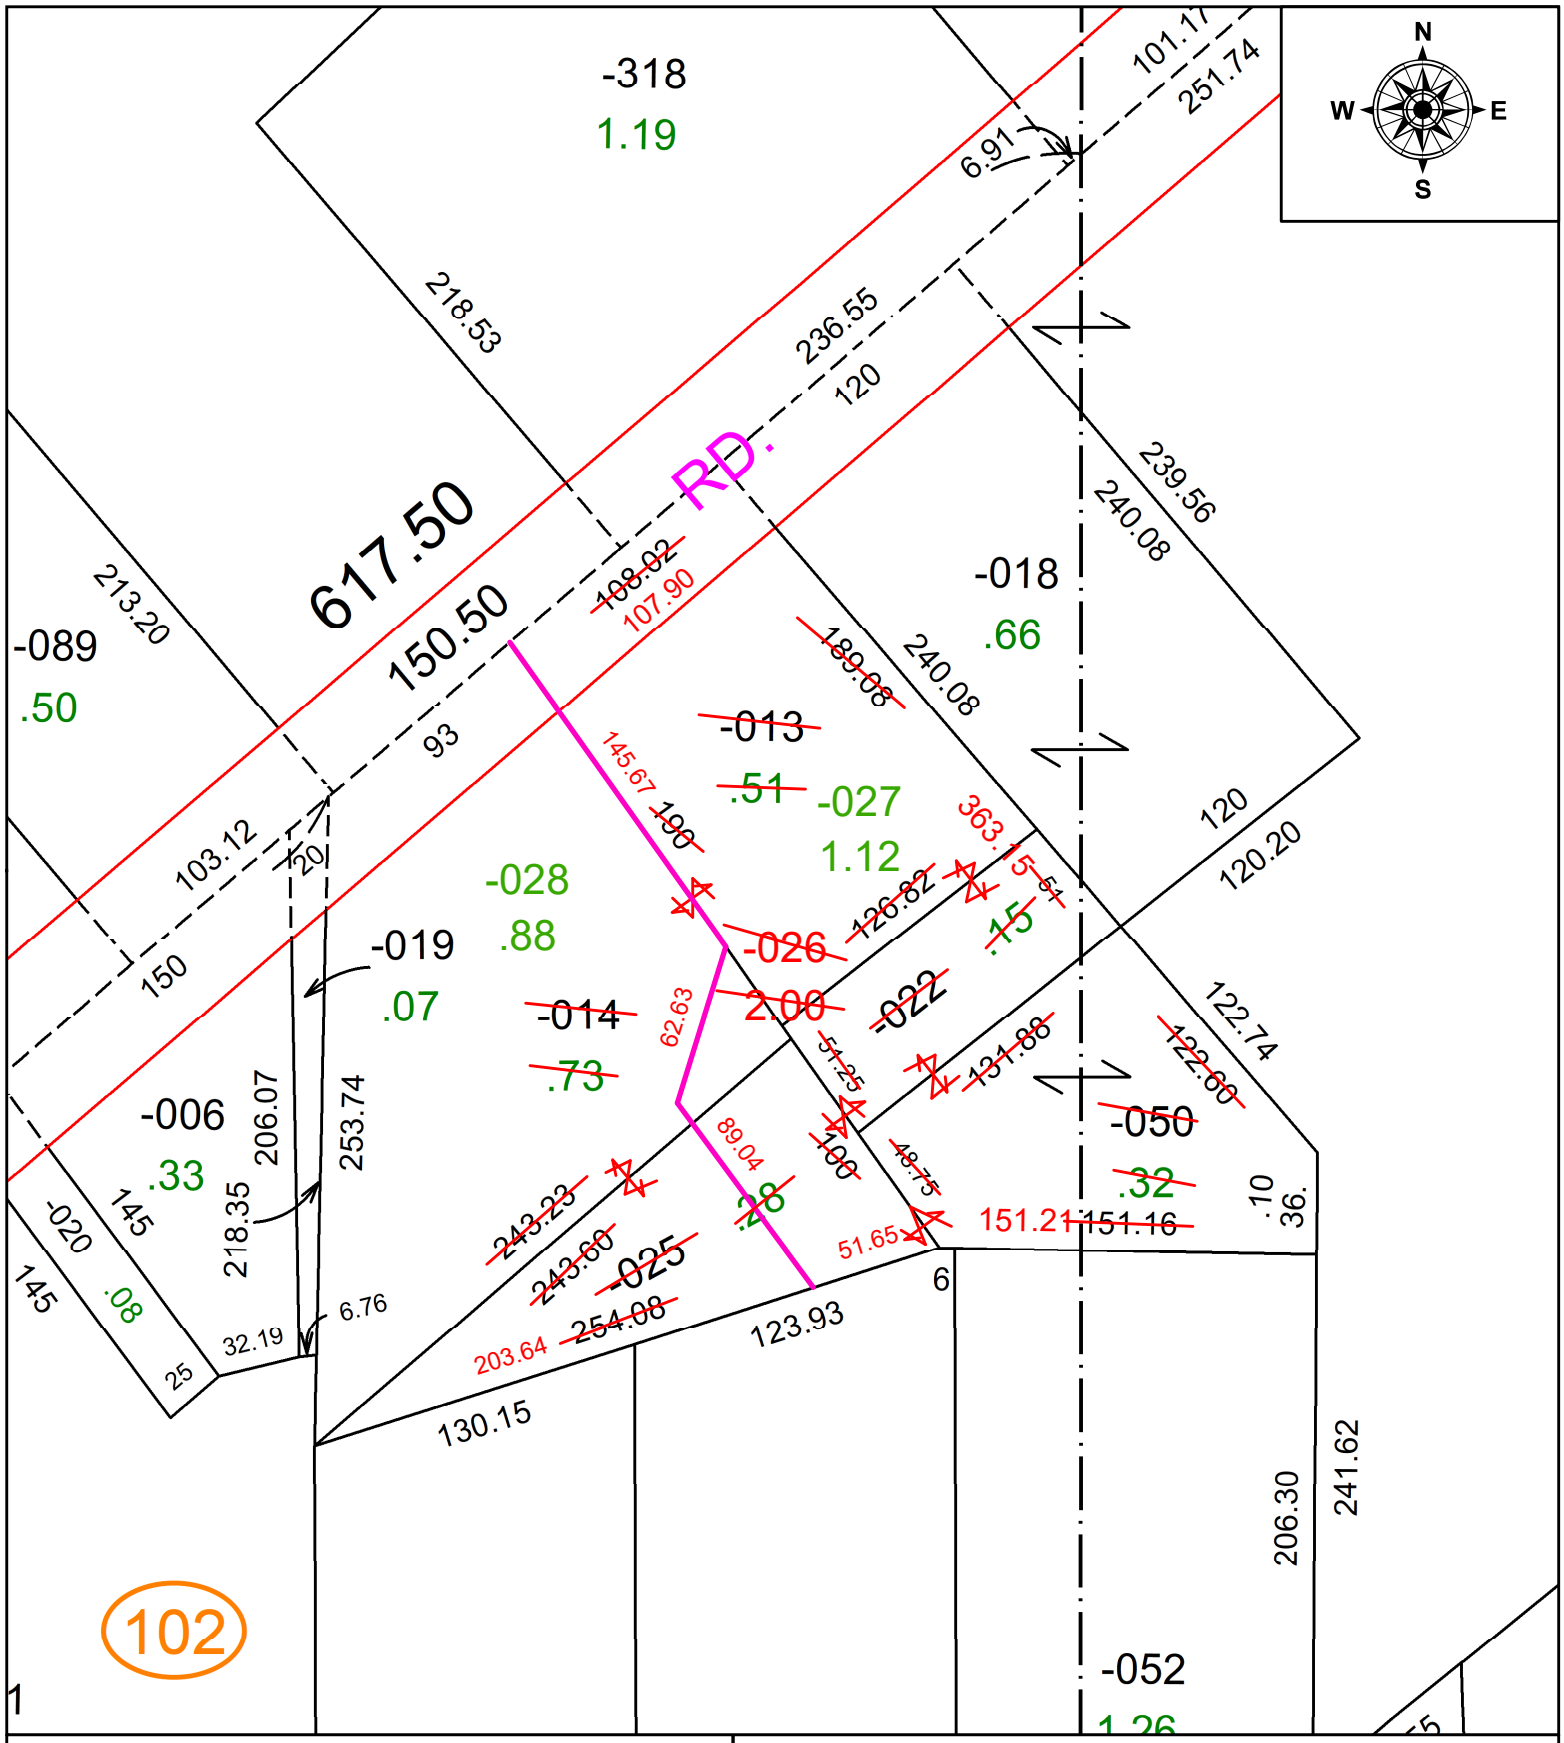

SPLITS/DEEDS PROCESSED

LORAIN COUNTY TAX MAP DEPARTMENT
226 MIDDLE AVE. ELYRIA, OH

SURVEYED BY: THOMAS SIMON **SURVEY #:** 51122
CLOSURE: 1:585055
MAP PAGE(S): 07-00-008
APPOVED BY: DMA **DATE:** 2/14/2024
SCALE: 1" = 75' **PRIOR INSTRUMENT:** 2021-0846521