PARENT PARCEL: 06-24-006-000-006

CHILD PARCEL: MAP CORR. PER SURVEY WILLIAM WALLACE

STARTING POINT: CL OF ALBRECHT RD. & MURRAY RD.

22-04822-C

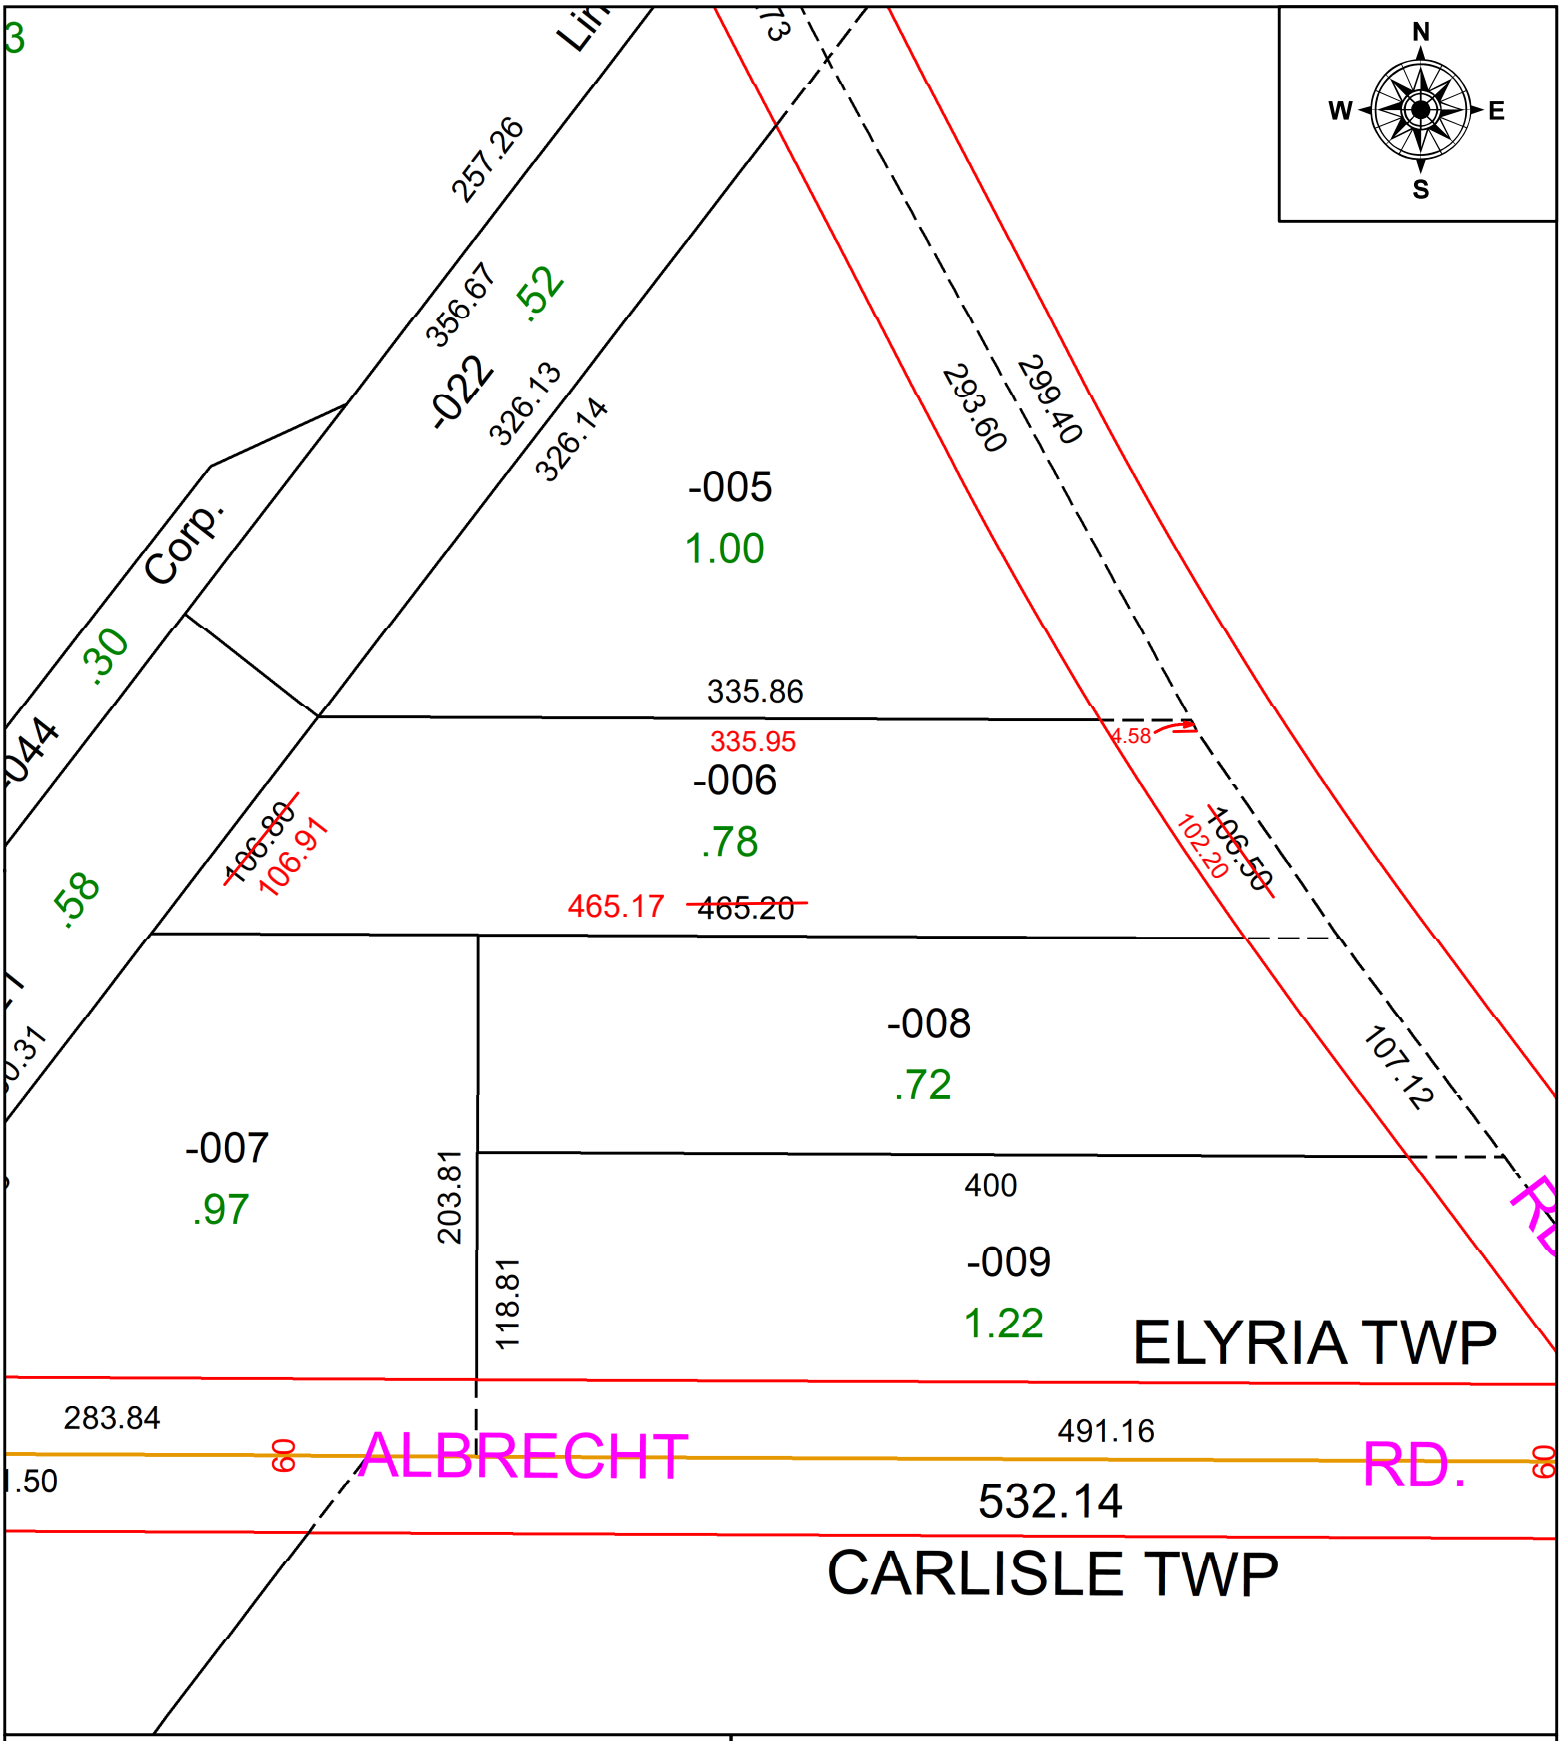

SPLITS/DEEDS PROCESSED

LORAIN COUNTY TAX MAP DEPARTMENT
226 MIDDLE AVE. ELYRIA, OH

SURVEYED BY: WILLIAM WALLACE
CLOSURE: 1: 112,538
MAP PAGE(S): 06-24-006
APPOVED BY: DMA **DATE:** 3/23/2022
SCALE: 1" = 75' **PRIOR INSTRUMENT:** 2022-0862065