PARENT PARCEL: 15-00-065-000-094

CHILD PARCEL: AC CORR PER SURV BY ROGER SIMON

STARTING POINT: C/L OF WATERFORD AND HOAG DR

22-04823-A

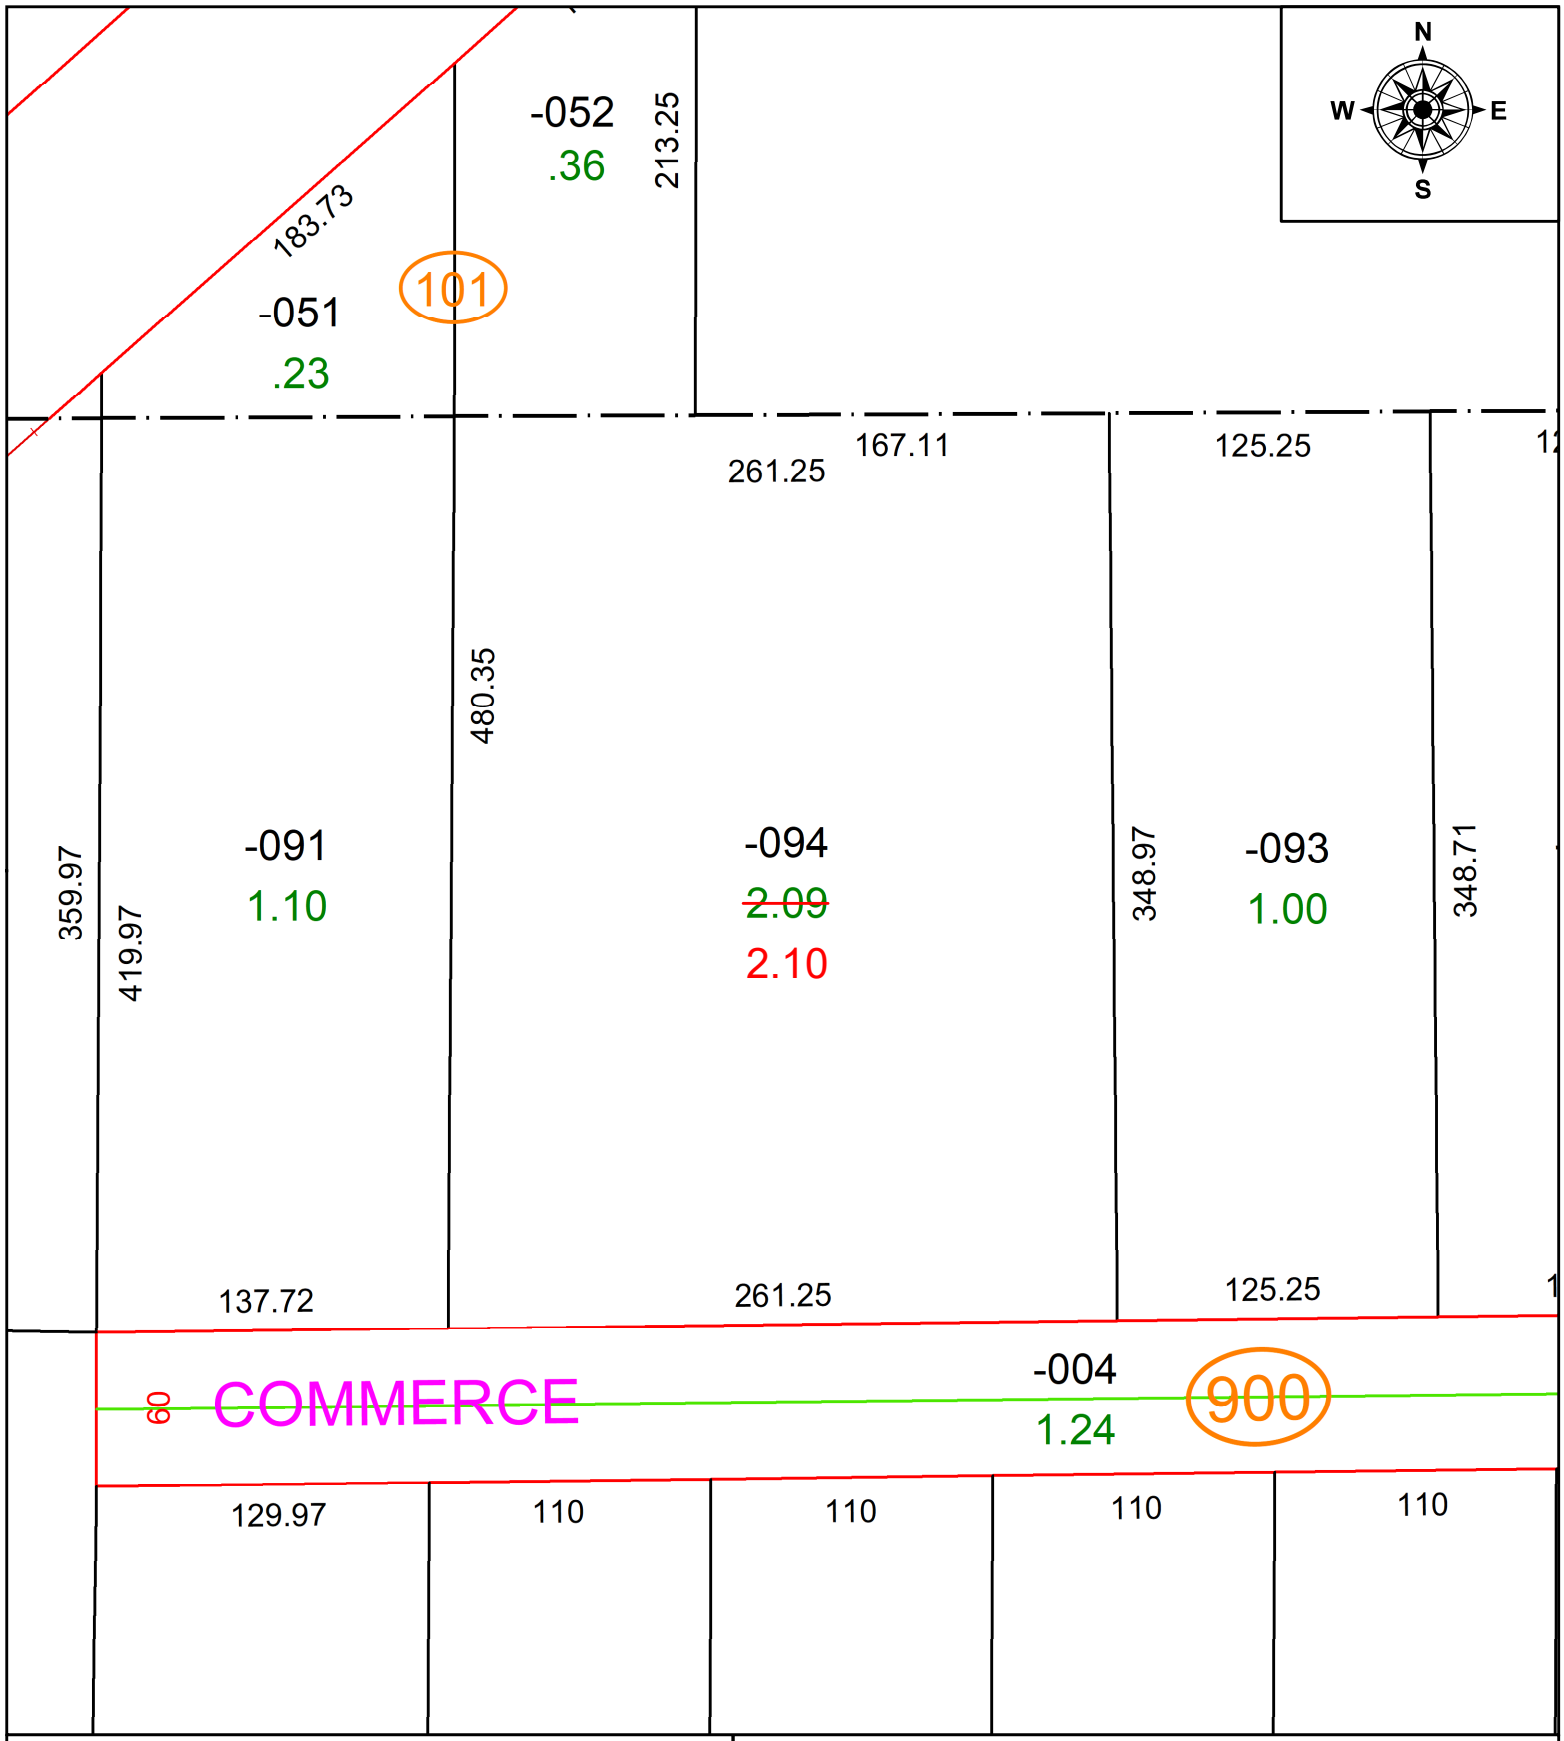

SPLITS/DEEDS PROCESSED

LORAIN COUNTY TAX MAP DEPARTMENT
226 MIDDLE AVE. ELYRIA, OH

SURVEYED BY: ROGER SIMON
CLOSURE: 1: 159087
MAP PAGE(S): 15-00-065-A
APPOVED BY: AC **DATE:** 3/22/2022
SCALE: 1" = 75 **PRIOR INSTRUMENT:** 2022- 0858648